


PARCEL INSTRUMENT	DATE	GRANTOR	GRANTEE	RECORDED HARDWICK	REMARK
A	Q.C.D.	4-3-39	IRVING & SARAH CARR	STAFF	BOOK 41 PAGE 601 DATE 4-7-39

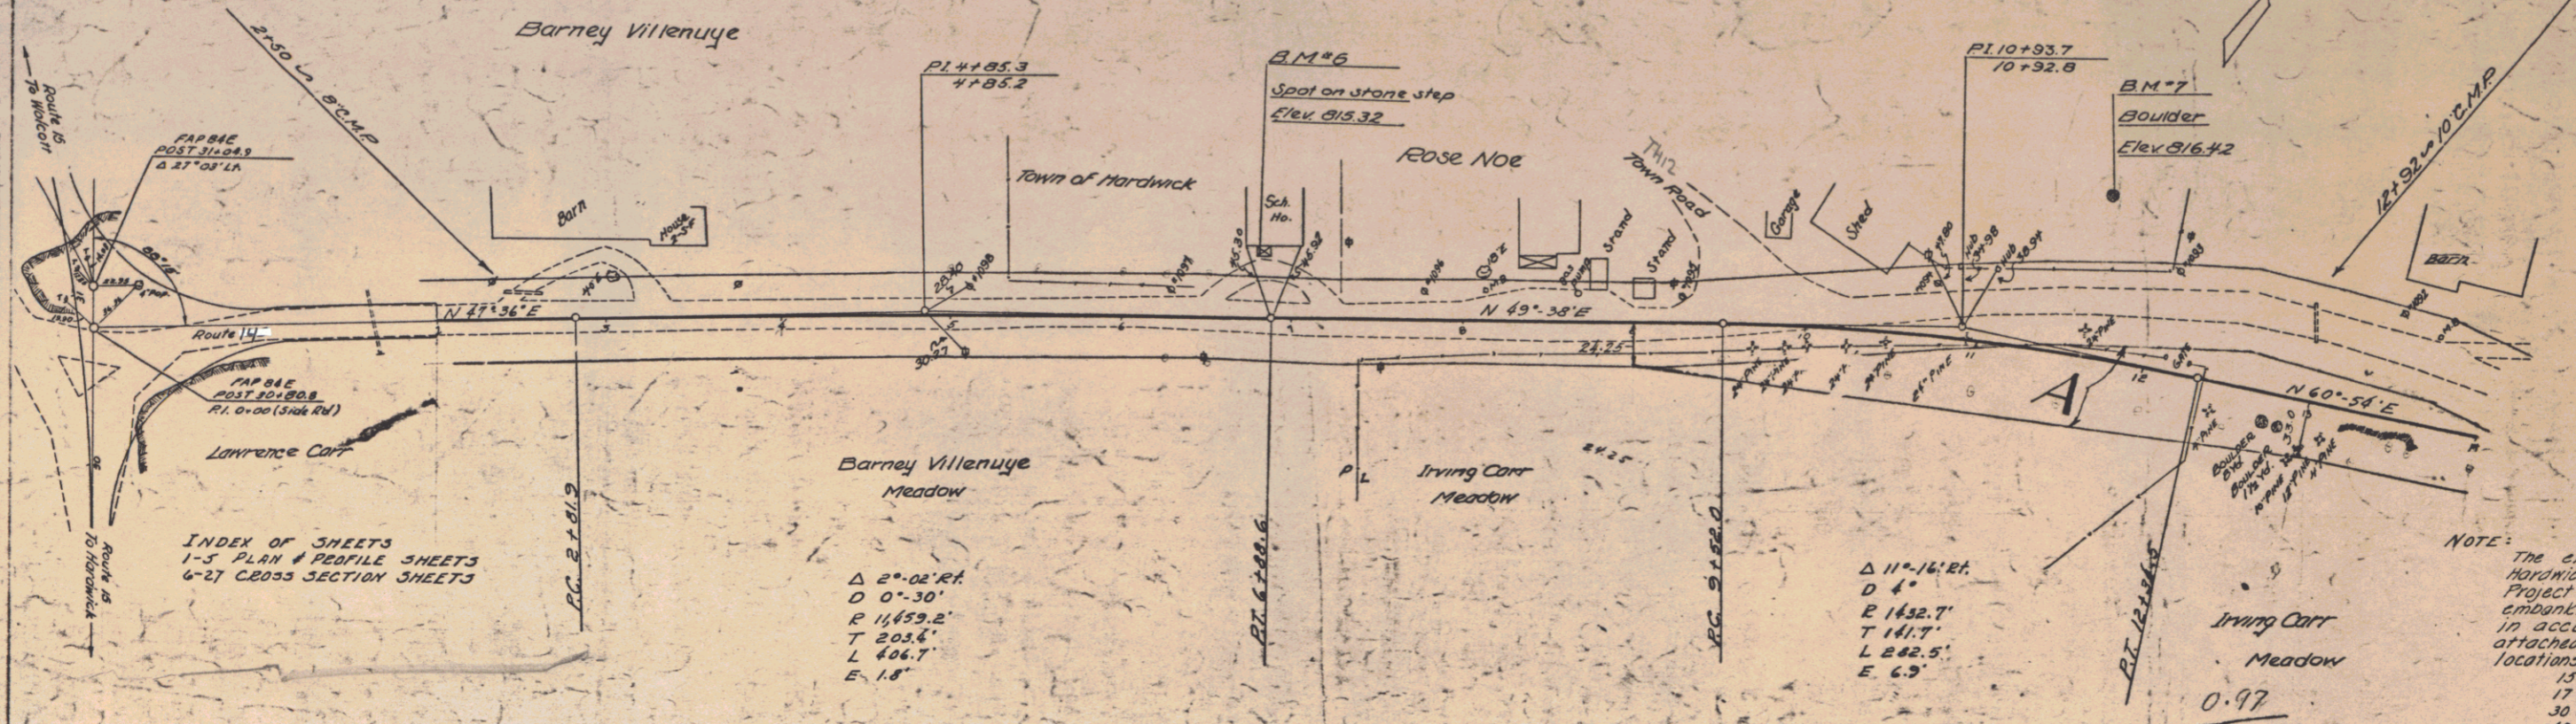

DRAINAGE STRUCTURES							
STA	OLD CULV	ADD	TYPE	W/O	PROJ	REM	REMARK
15+50	-	6	18"	24"	30"	36"	5
31+88.5	W.C.M.	6	3.4	18"	30"	1.9	7
37+108	-	6	3.4	18"	30"	1.9	2 REMOVE
37+112	OCU	6	-	-	-	10	4 REMOVE
TOTALS				18"	18"	3.8	109 18

SUMMARY OF QUANTITIES			
NO.	ITEM	UNIT	QUAN.
128	Trench Excavation of Earth	CY	109
129	Trench Excavation of Rock	-	18
85	Cement Rubble Masonry	CY	3.8
32E	18" Cor. Galv. Metal Pipe Run C/U	L.F.	183
32D	24"	-	88

NOTE: The quantities listed above are not included in the quantities for F.A.P. 84-E, but are to be paid for at the unit bid price for each item as bid on F.A.P. 84-E.  
This work is not to be included in Govt. Participation.

