
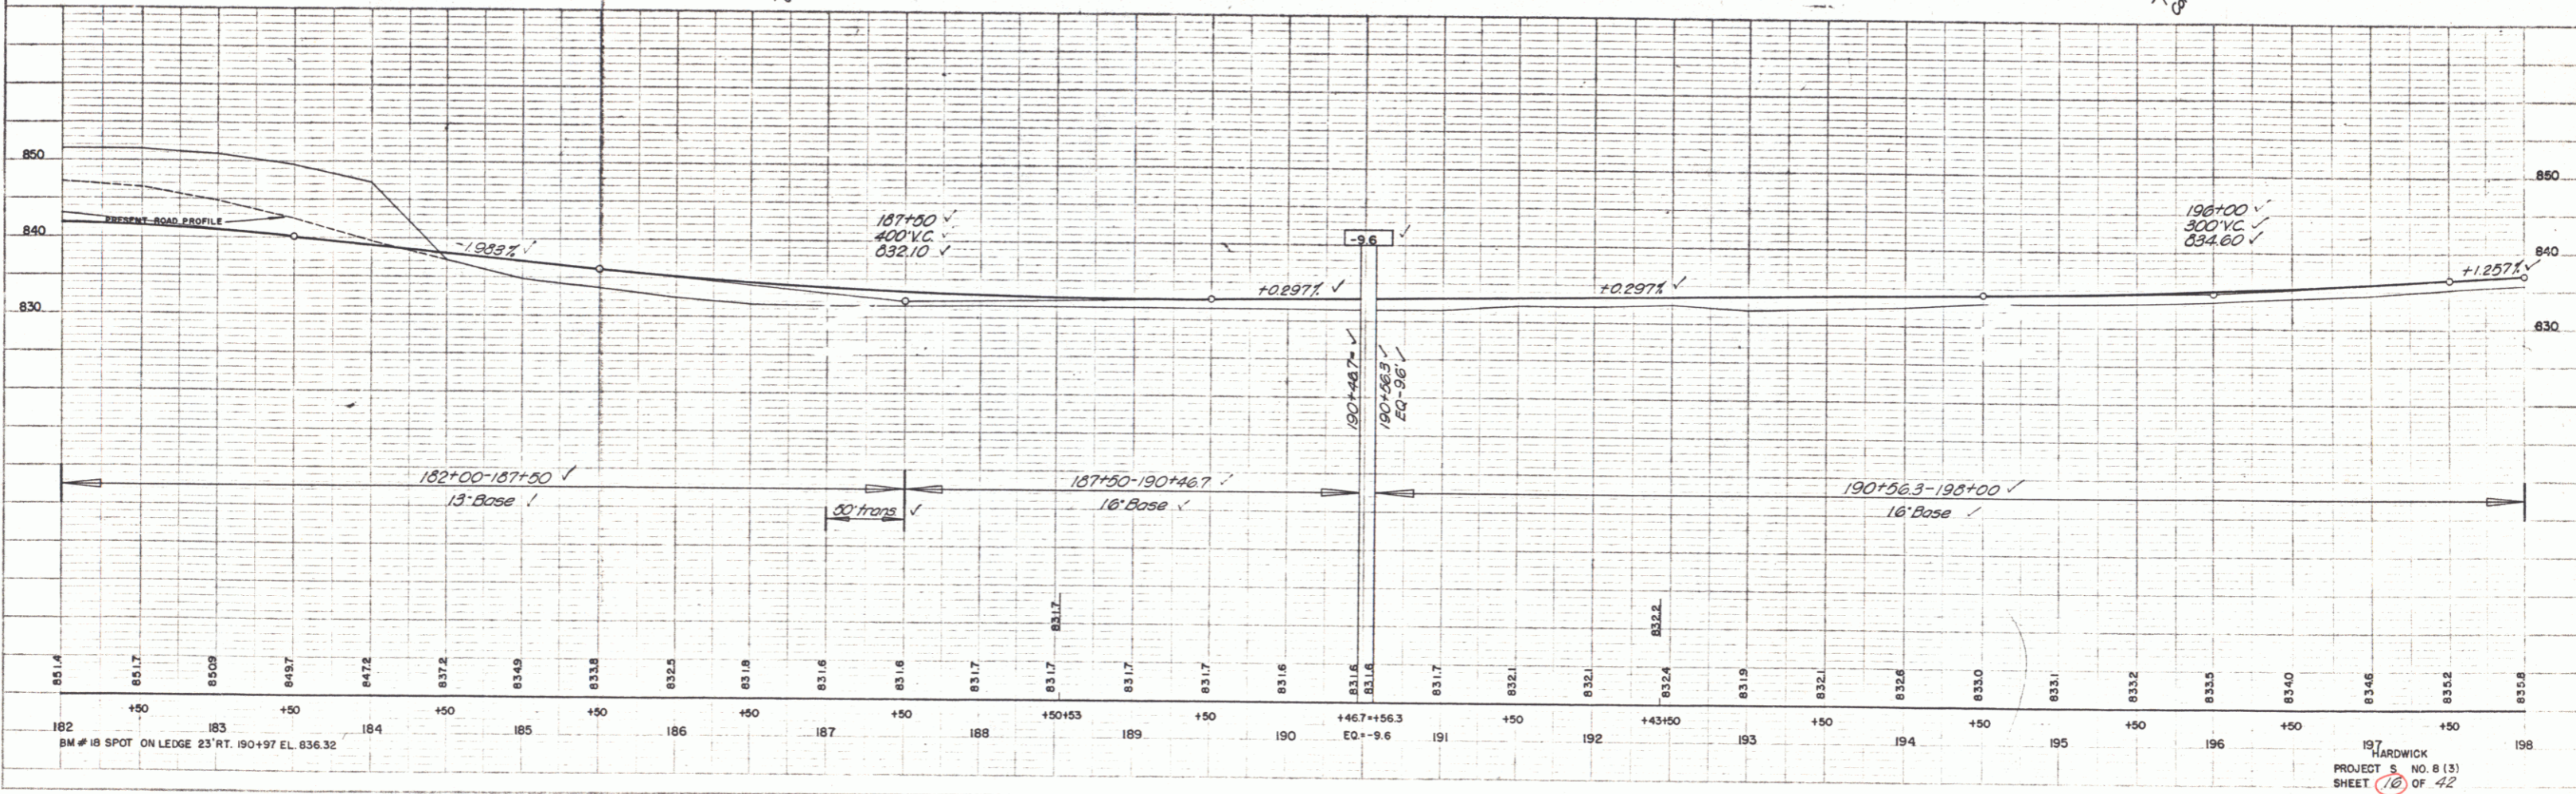


DATE	7/24
BY	7/24
PROJECT	SPAWLING
NO.	10
NOTE	SEE SHEET 10 FOR CHANGES
TRACED	AT

DATE	7/24
BY	7/24
PROJECT	SPAWLING
NO.	10
NOTE	SEE SHEET 10 FOR CHANGES
TRACED	AT

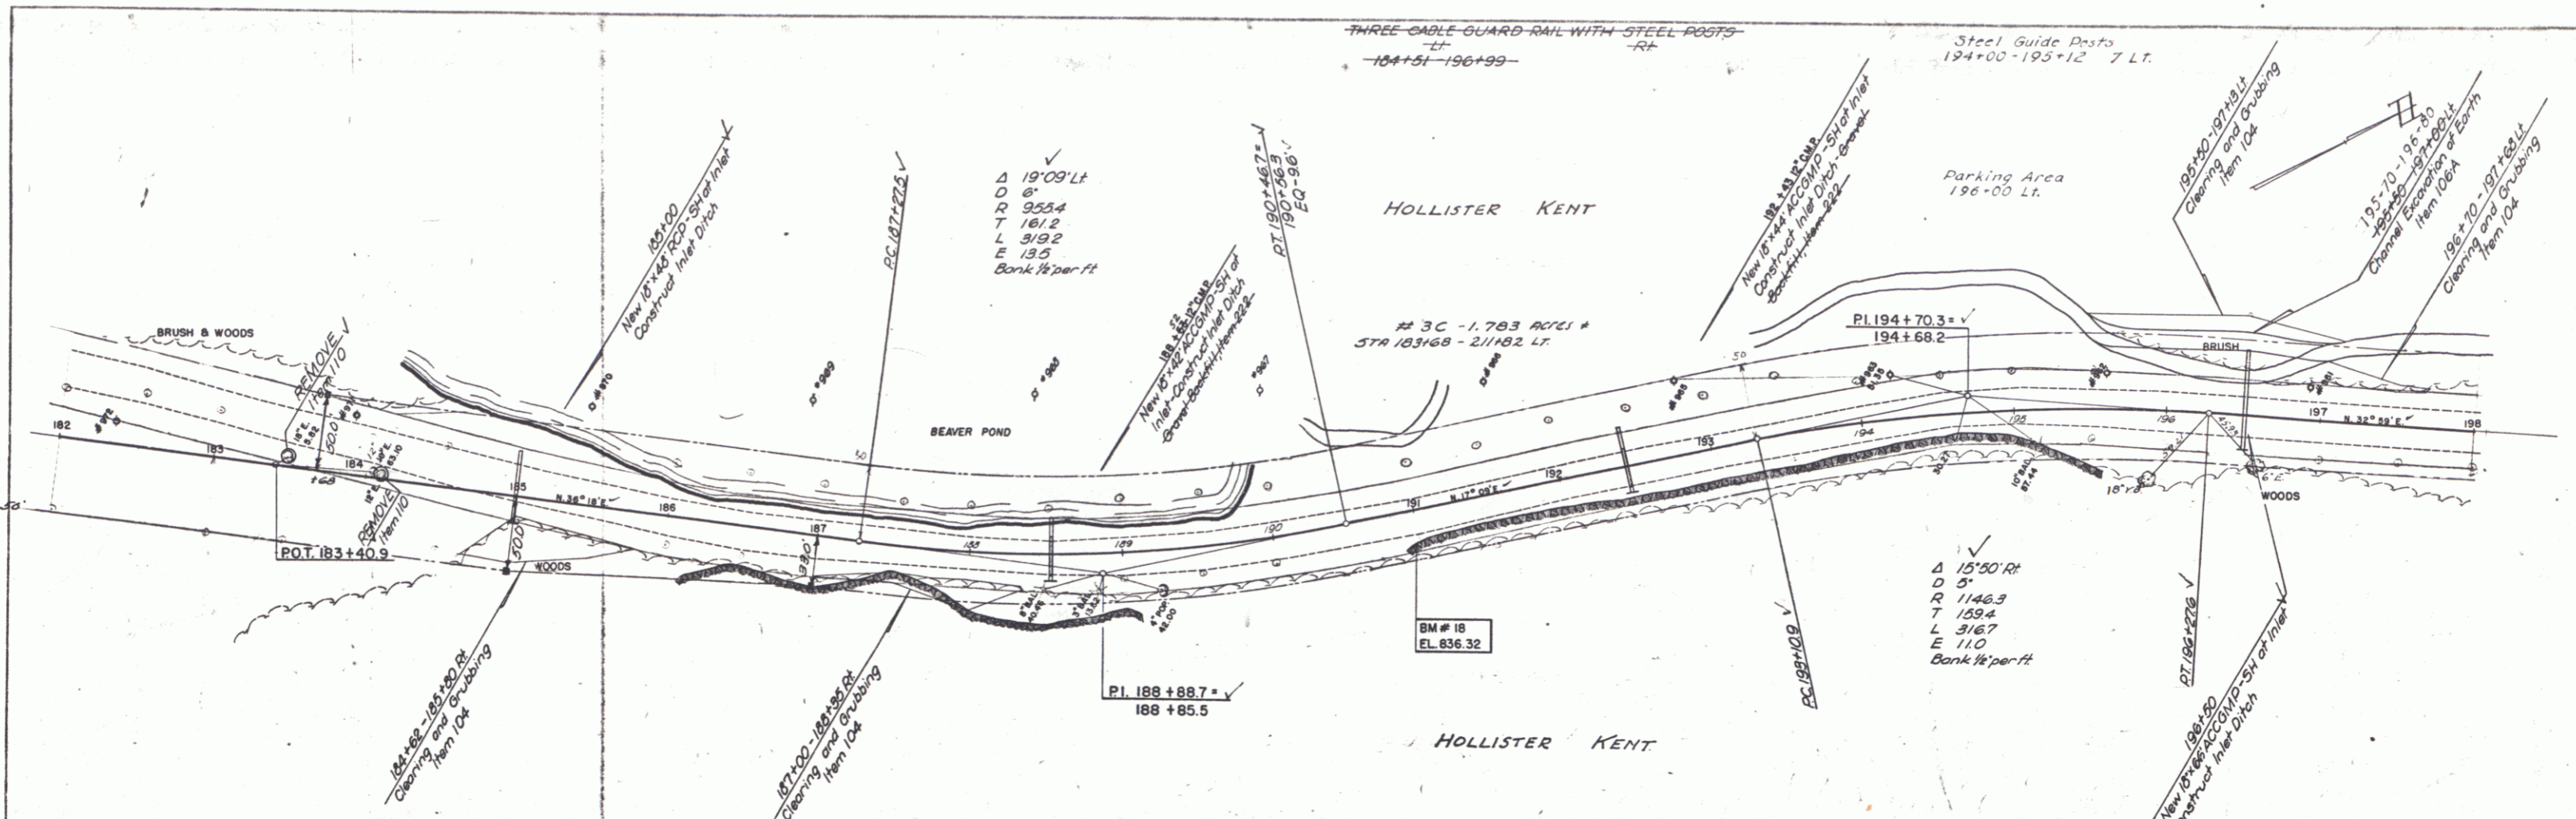

HARDWICK
PROJECT S. NO. 8 (3)
SHEET 10 OF 42