
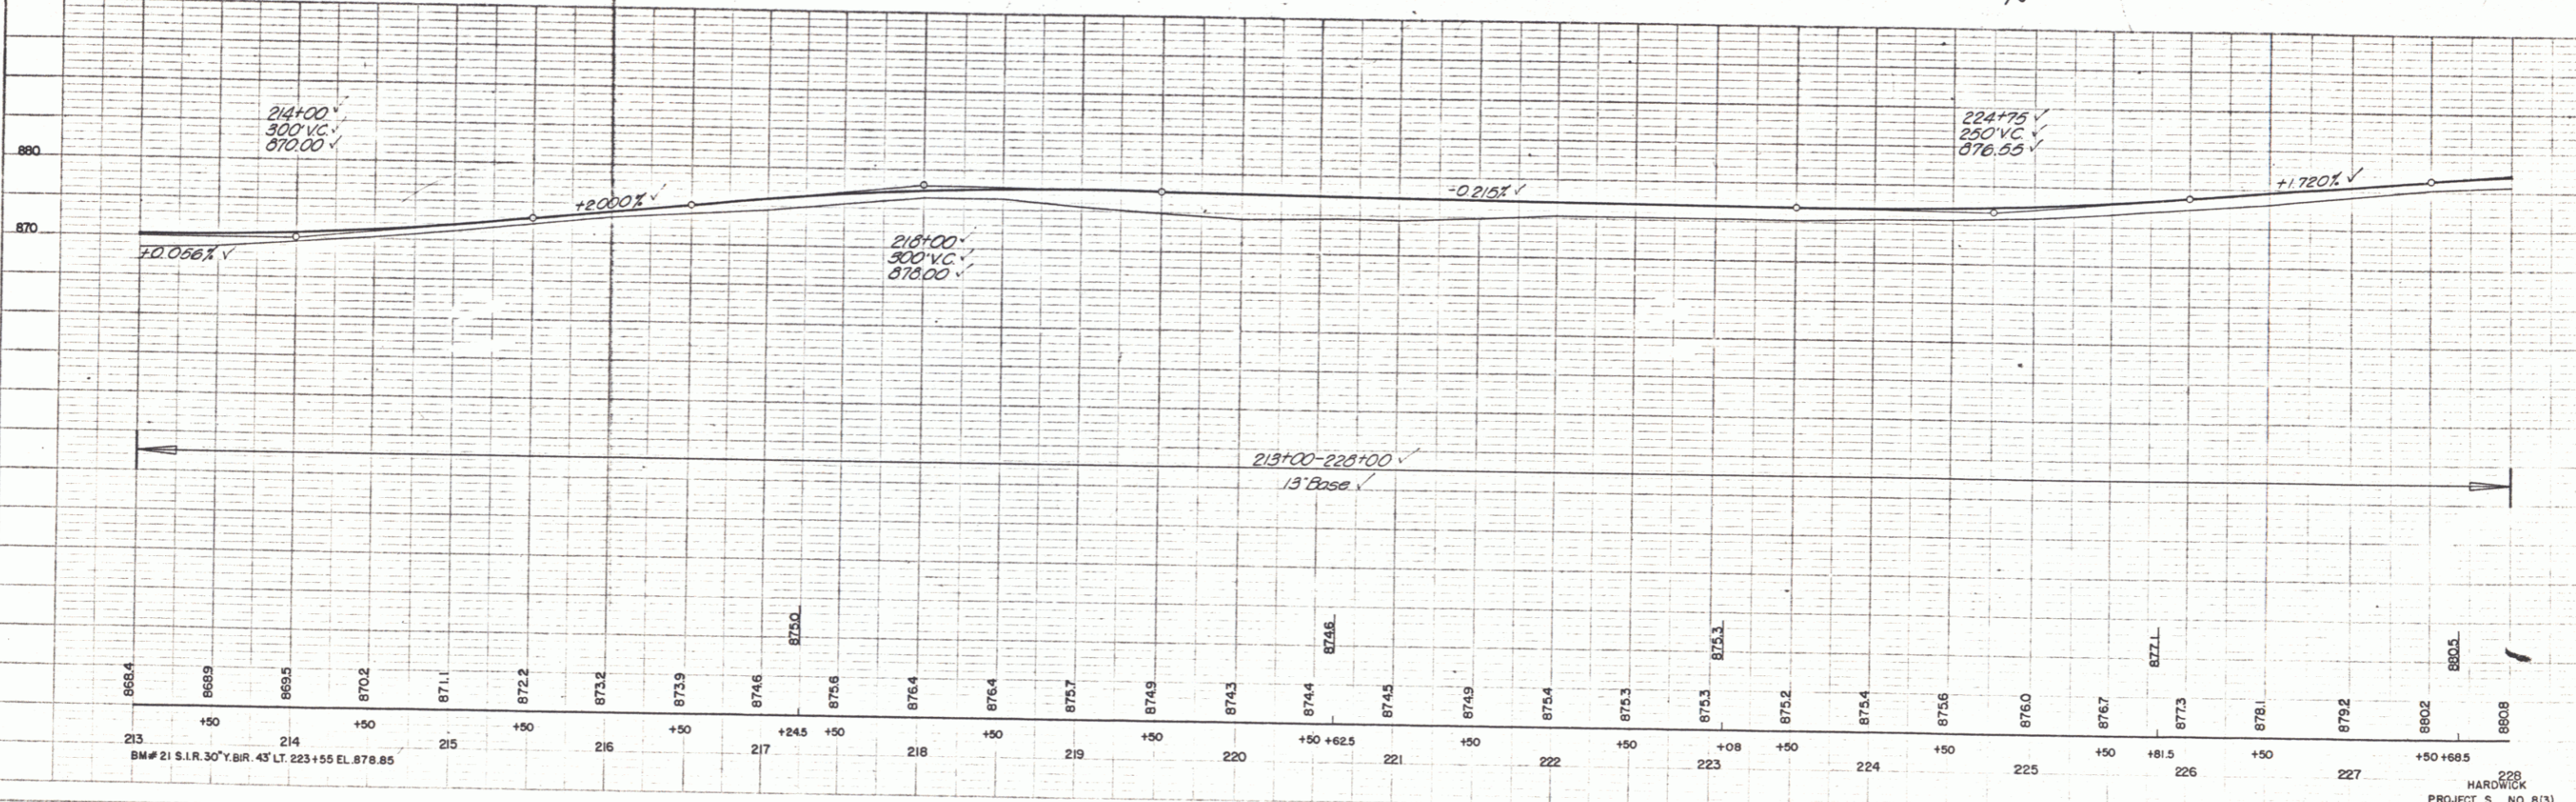


PLAN  
 DATE: 8/24/84  
 DRAWN BY: [unclear]  
 CHECKED BY: [unclear]  
 TRACED BY: [unclear]

PROJECT: [unclear]  
 DATE: 8/24/84  
 DRAWN BY: [unclear]  
 CHECKED BY: [unclear]  
 TRACED BY: [unclear]

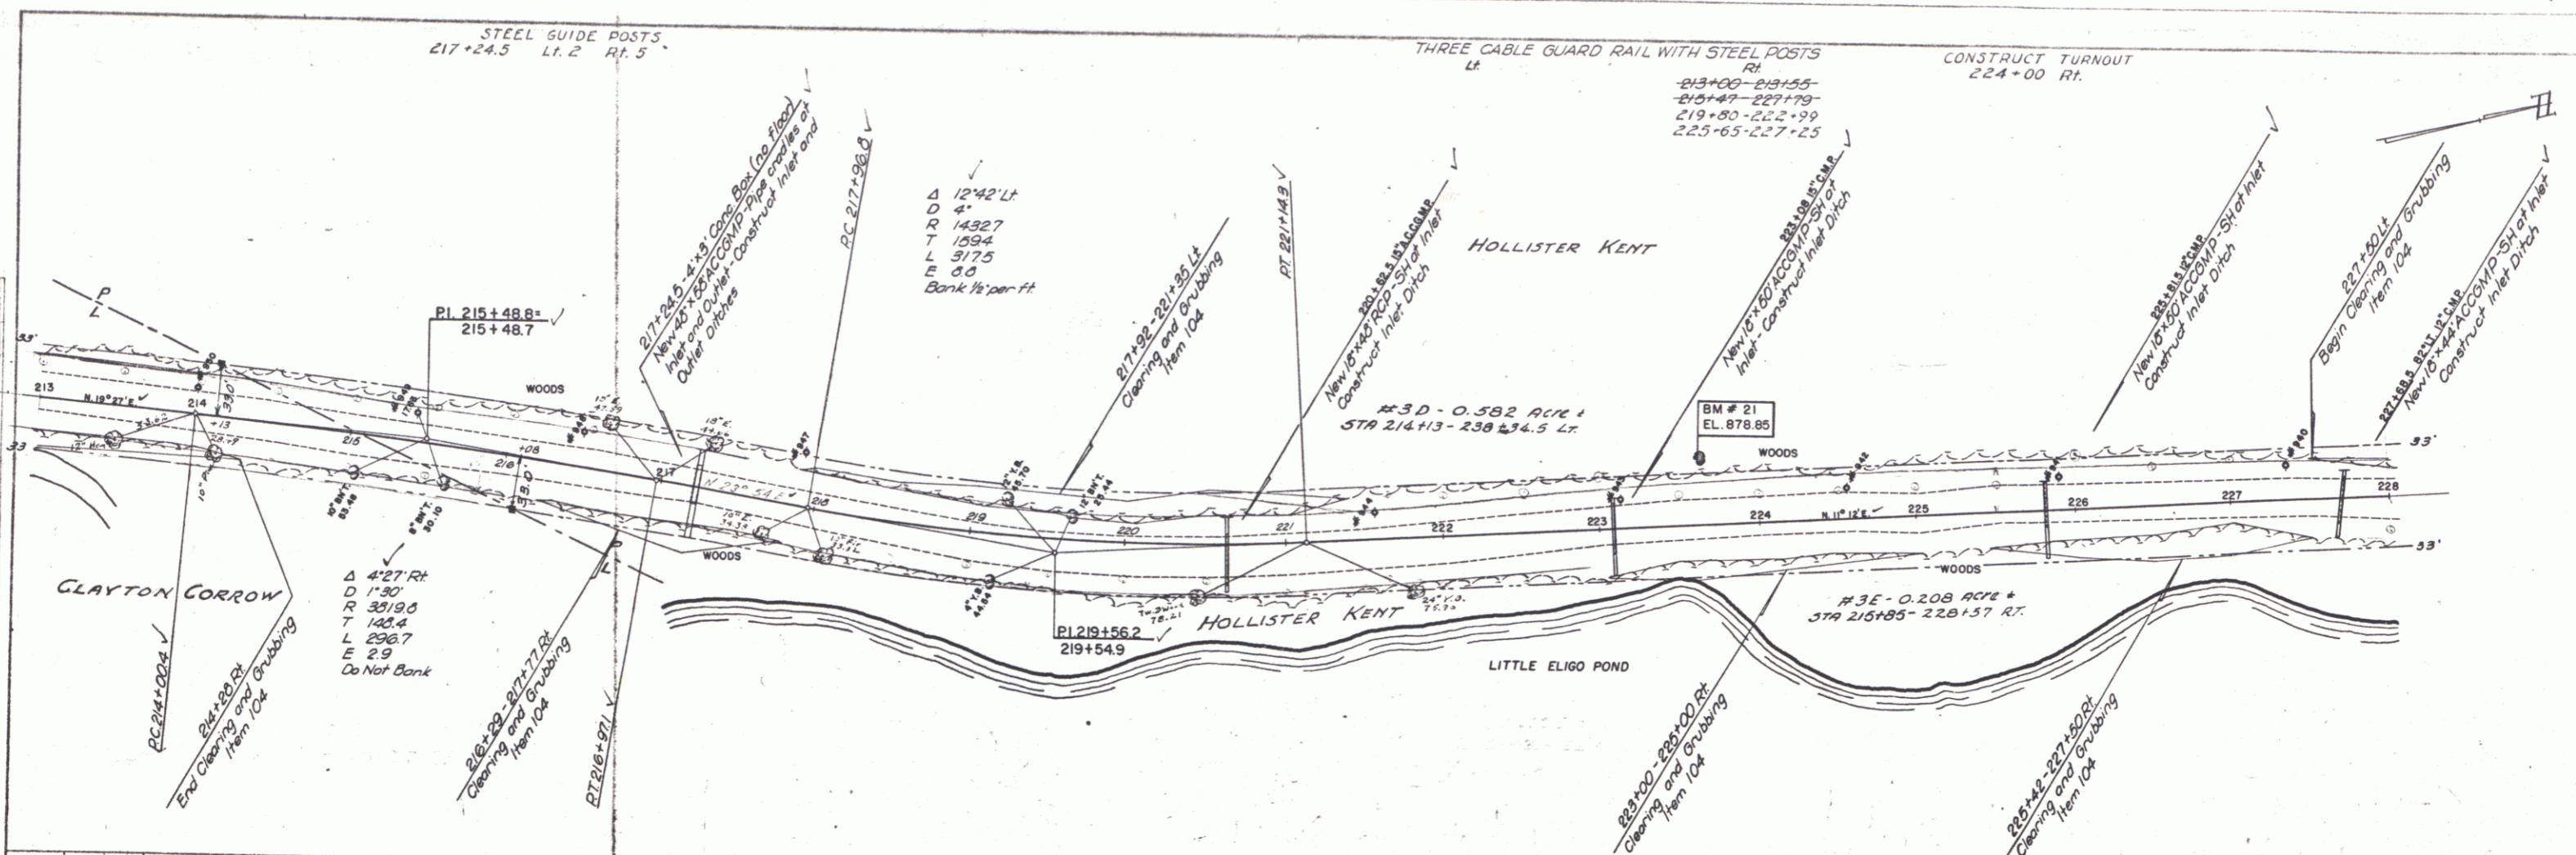

228  
 HARDWICK  
 PROJECT NO. 813  
 SHEET 18 OF 42