
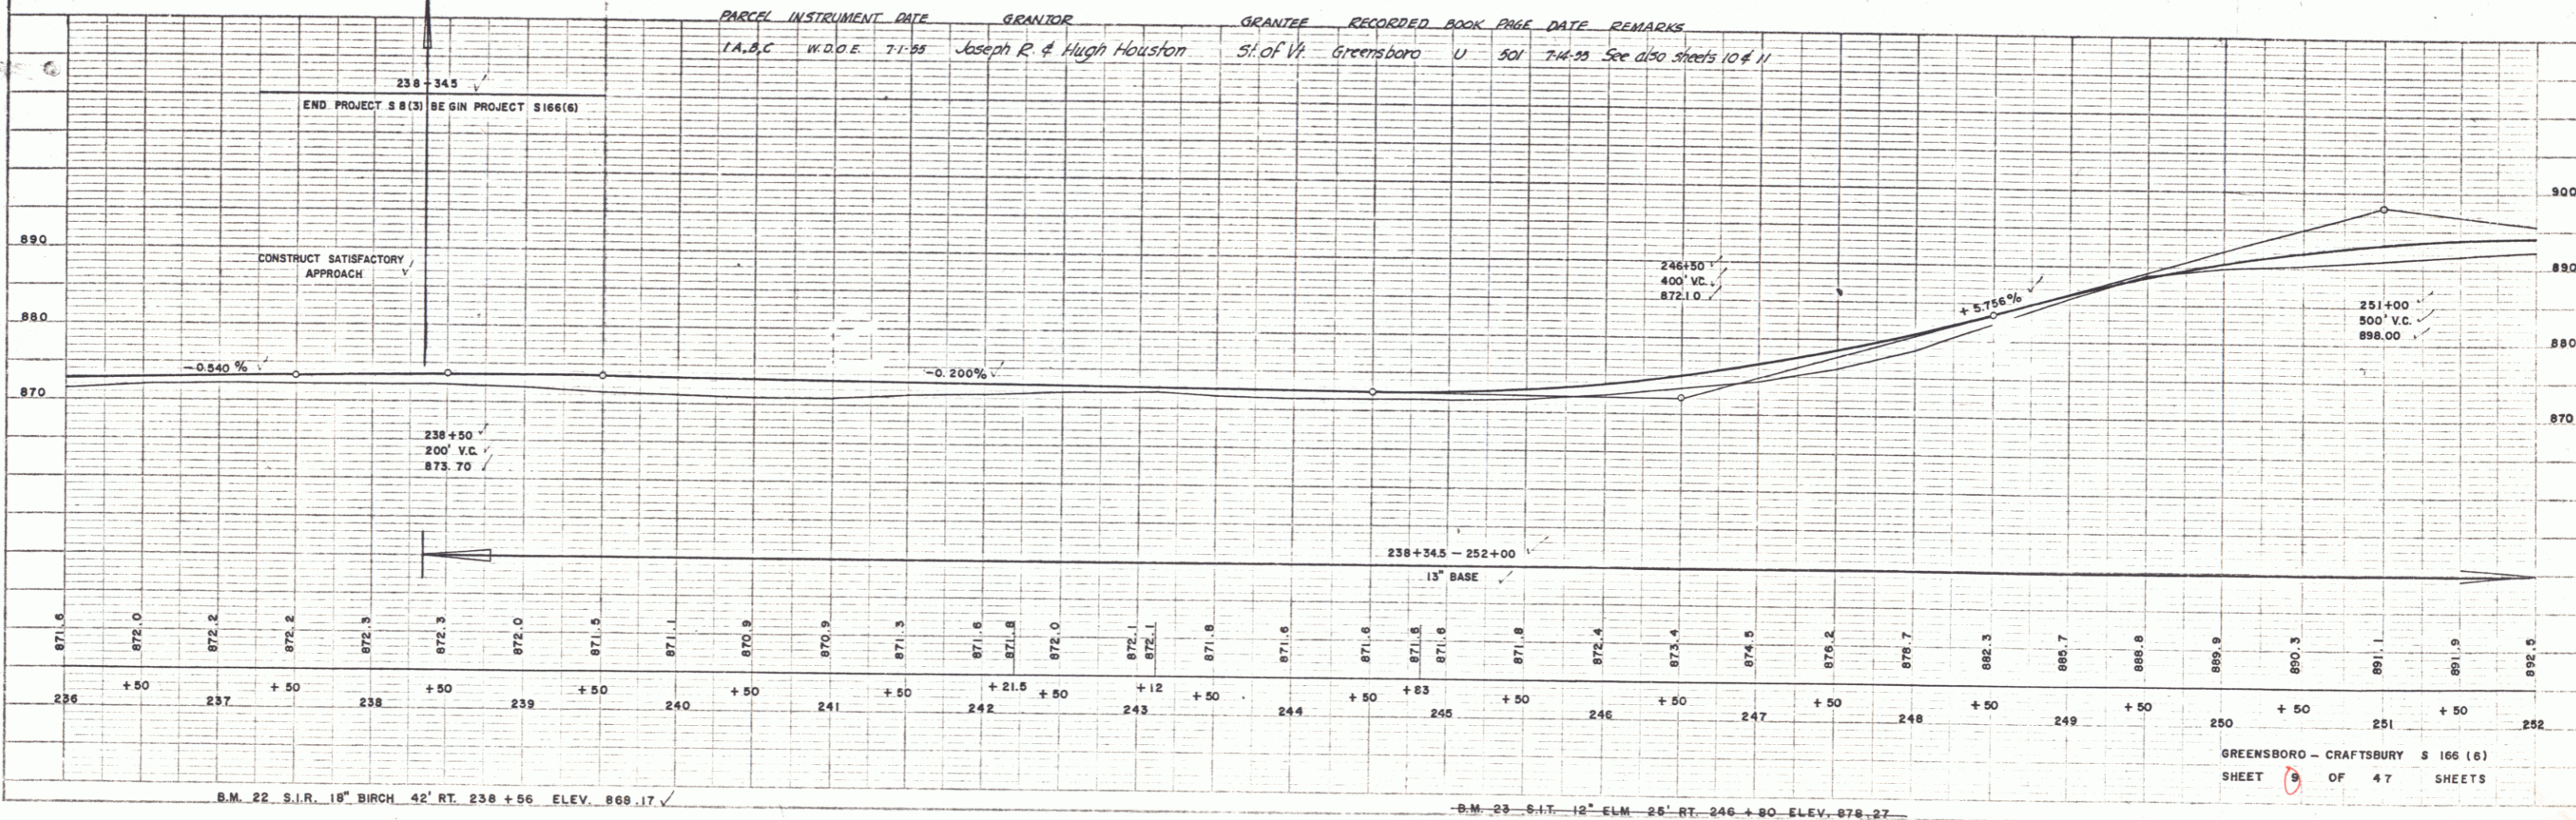


PLAN  
 DRAWN BY: BRADSHAW  
 CHECKED BY: WEBSTER-MARTIN INC. J.L.B.  
 DATE: 11-11-04  
 NO. OF SHEETS CHECKED: 47  
 NO. OF SHEETS: 47

PROFILE  
 DRAWN BY: BRADSHAW  
 CHECKED BY: WEBSTER-MARTIN INC. J.L.B.  
 DATE: 11-11-04  
 NO. OF SHEETS CHECKED: 47  
 NO. OF SHEETS: 47

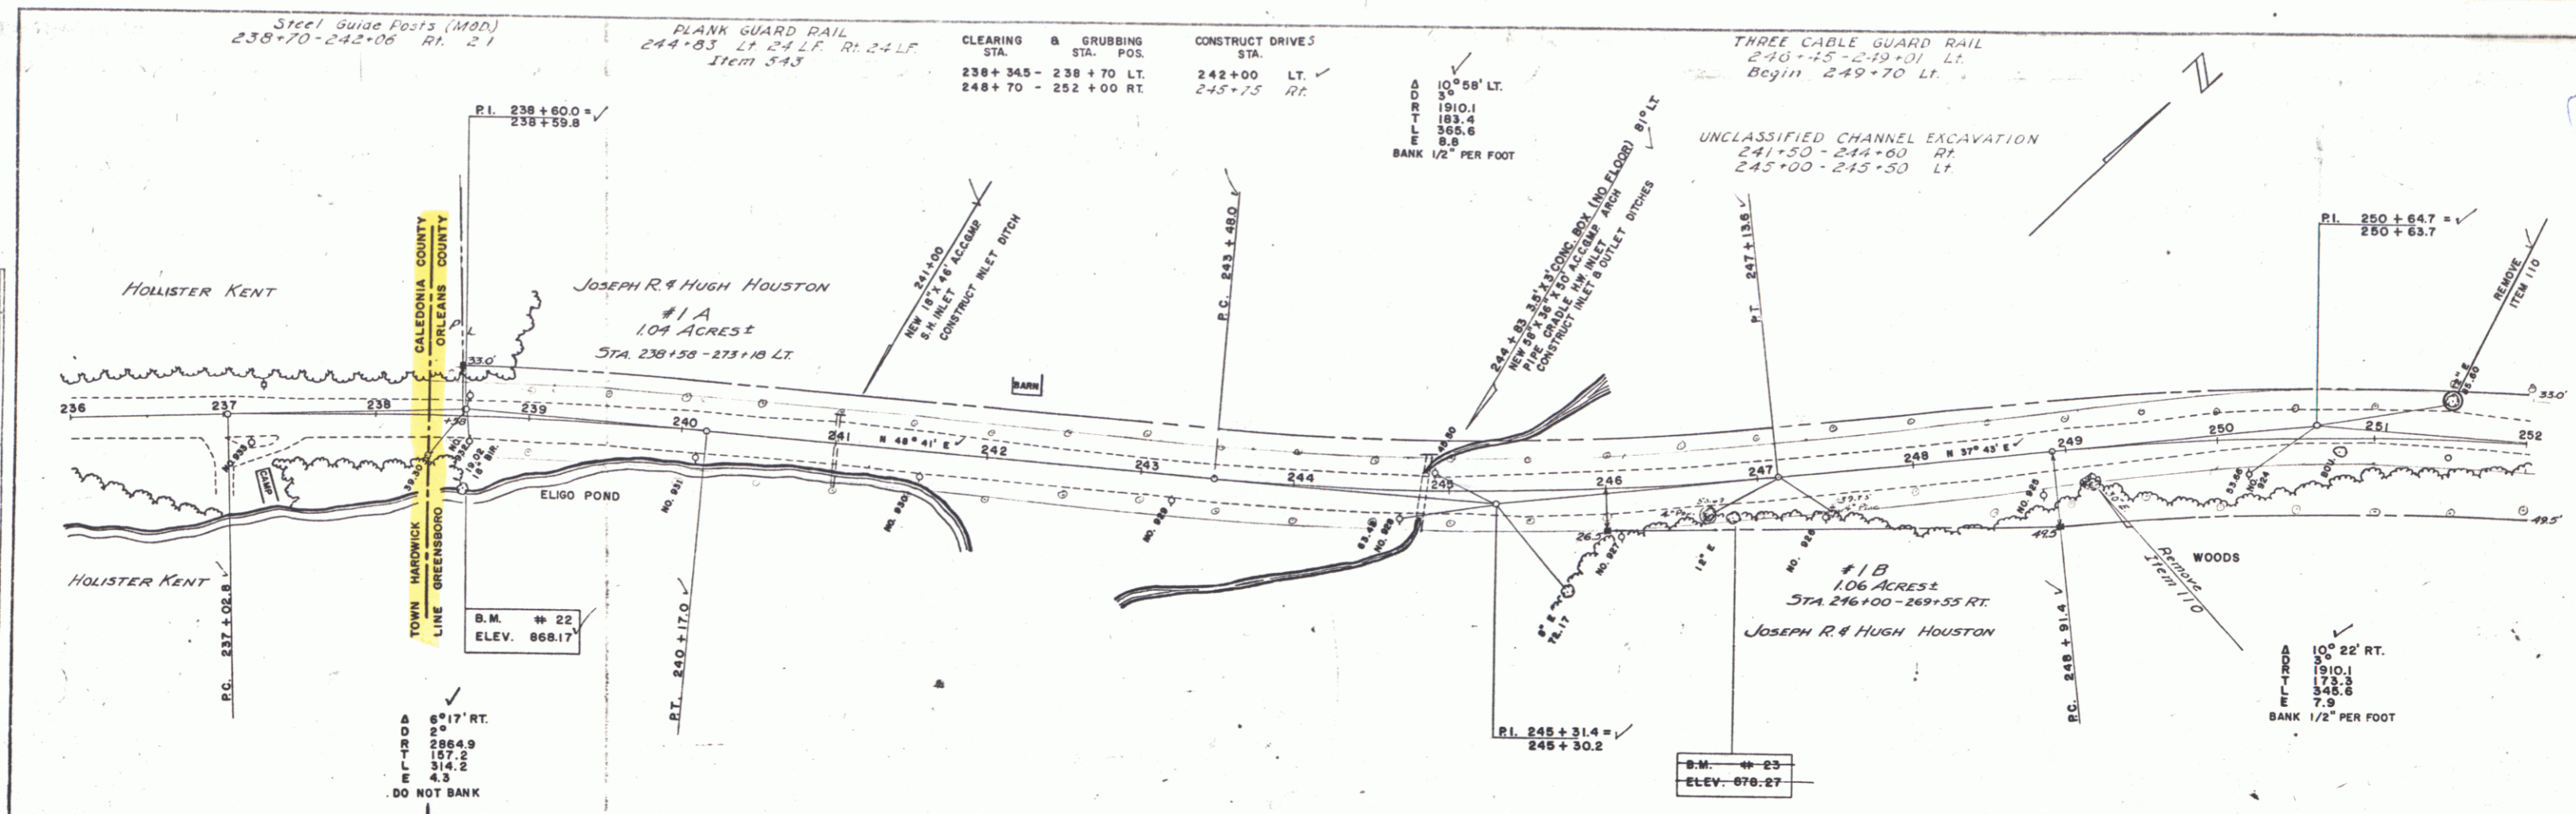

GREENSBORO - CRAFTSBURY § 166 (6)  
 SHEET 9 OF 47 SHEETS