


PARCEL	INSTRUMENT	DATE	GRANTOR	GRANTEE	RECORDED	BOOK	PAGE	DATE	REMARKS
2	W.D.O.E.	7-1-55	Merrill A. Darling	Sl of Vh	Greensboro	U	520	7-14-55	
3	W.D.O.E.	7-1-55	Dr. Raymond C. & Sarah Densmore	Sl of Vh	Greensboro	U	521	7-14-55	
4 A, B, C	W.D.O.E.	7-6-55	Thelma M. Orr	Sl of Vh	Greensboro	U	522	7-14-55	See also sheets 12 & 13

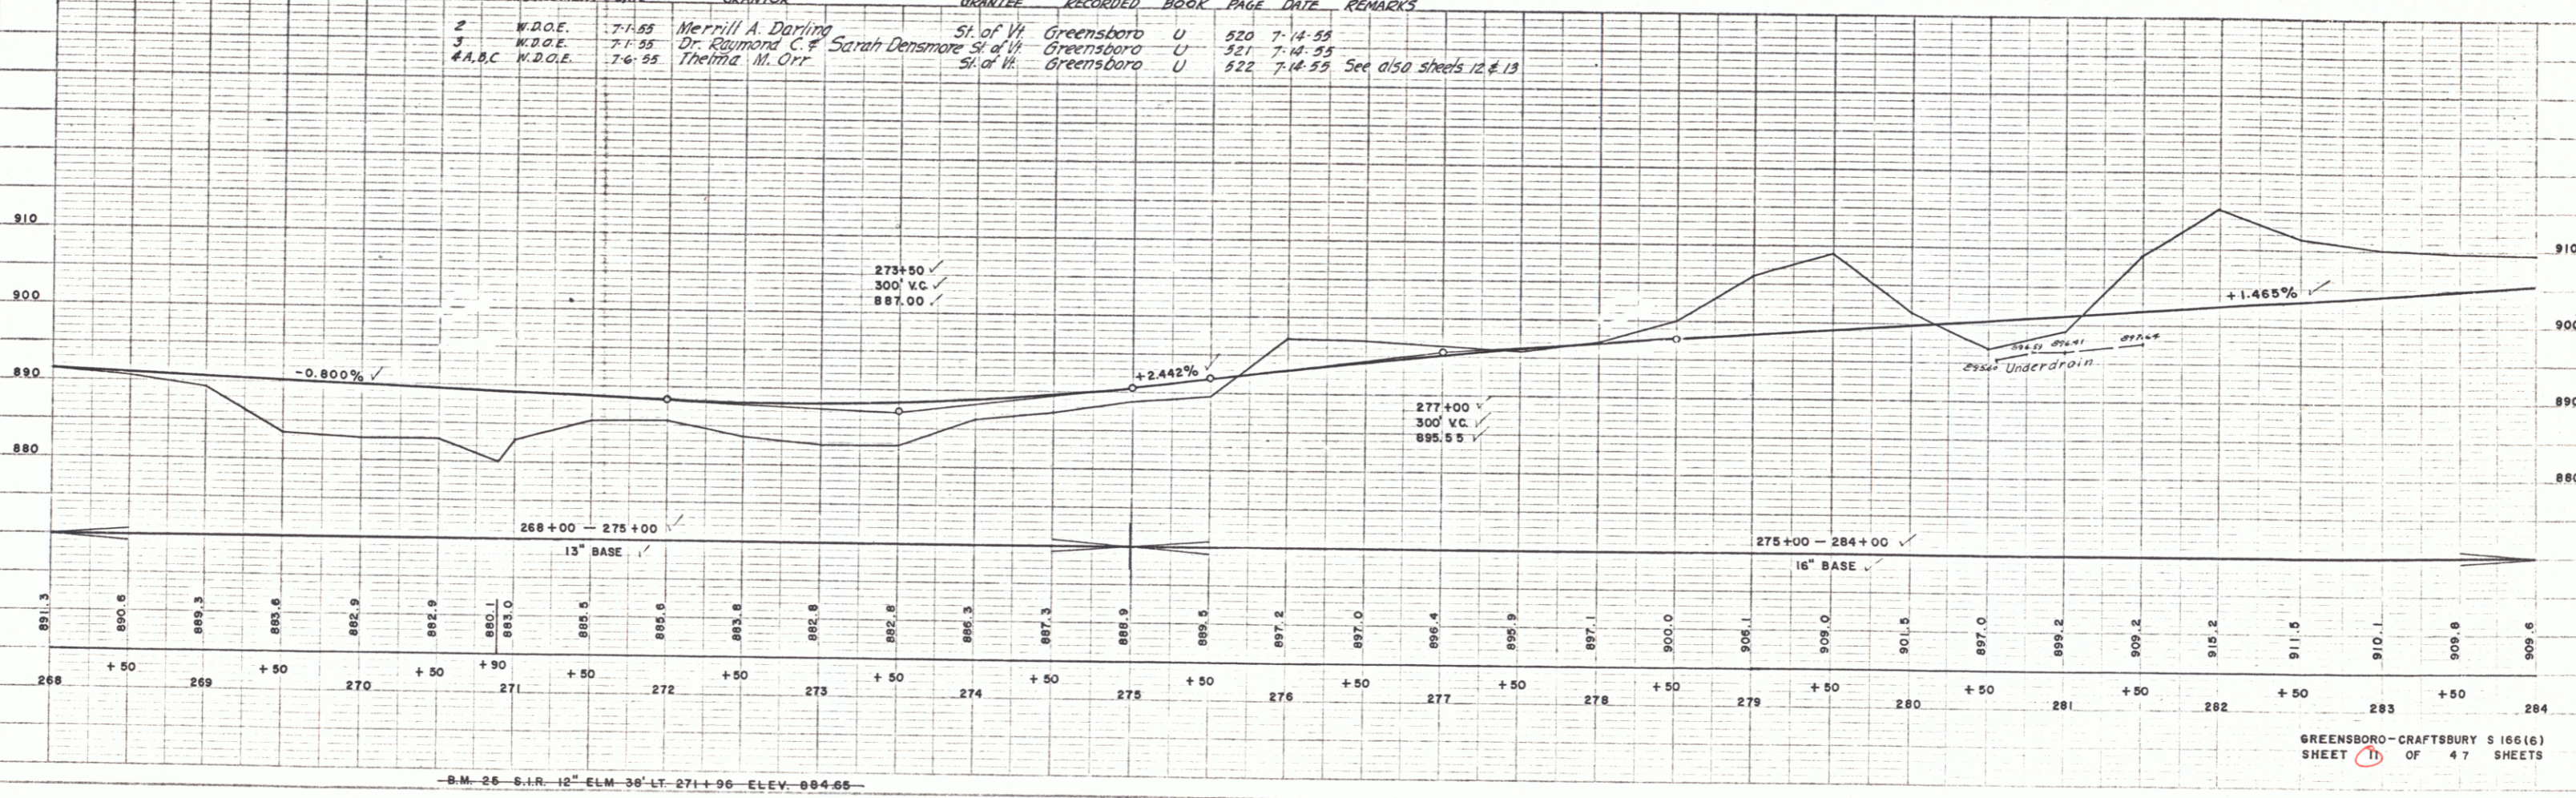

PLAN
 DRAWN BY: PAULINE W. WELLS
 CHECKED BY: WALTER W. MARTIN, INC. 11-54
 DATE: 11-54
 NOTE: BOOK NO. OF WATER-CHECKED

PROFILE
 DRAWN BY: PAULINE W. WELLS
 CHECKED BY: WALTER W. MARTIN, INC. 11-54
 DATE: 11-54
 NOTE: BOOK NO. OF WATER-CHECKED