


PLAN  
 SHEET NO. 10  
 DATE 10/1/56  
 DRAWN BY J. W. B. JR.  
 CHECKED BY J. W. B. JR.  
 PROJECT NO. 166(B)

VERTICAL  
 SHEET NO. 10  
 DATE 10/1/56  
 DRAWN BY J. W. B. JR.  
 CHECKED BY J. W. B. JR.  
 PROJECT NO. 166(B)

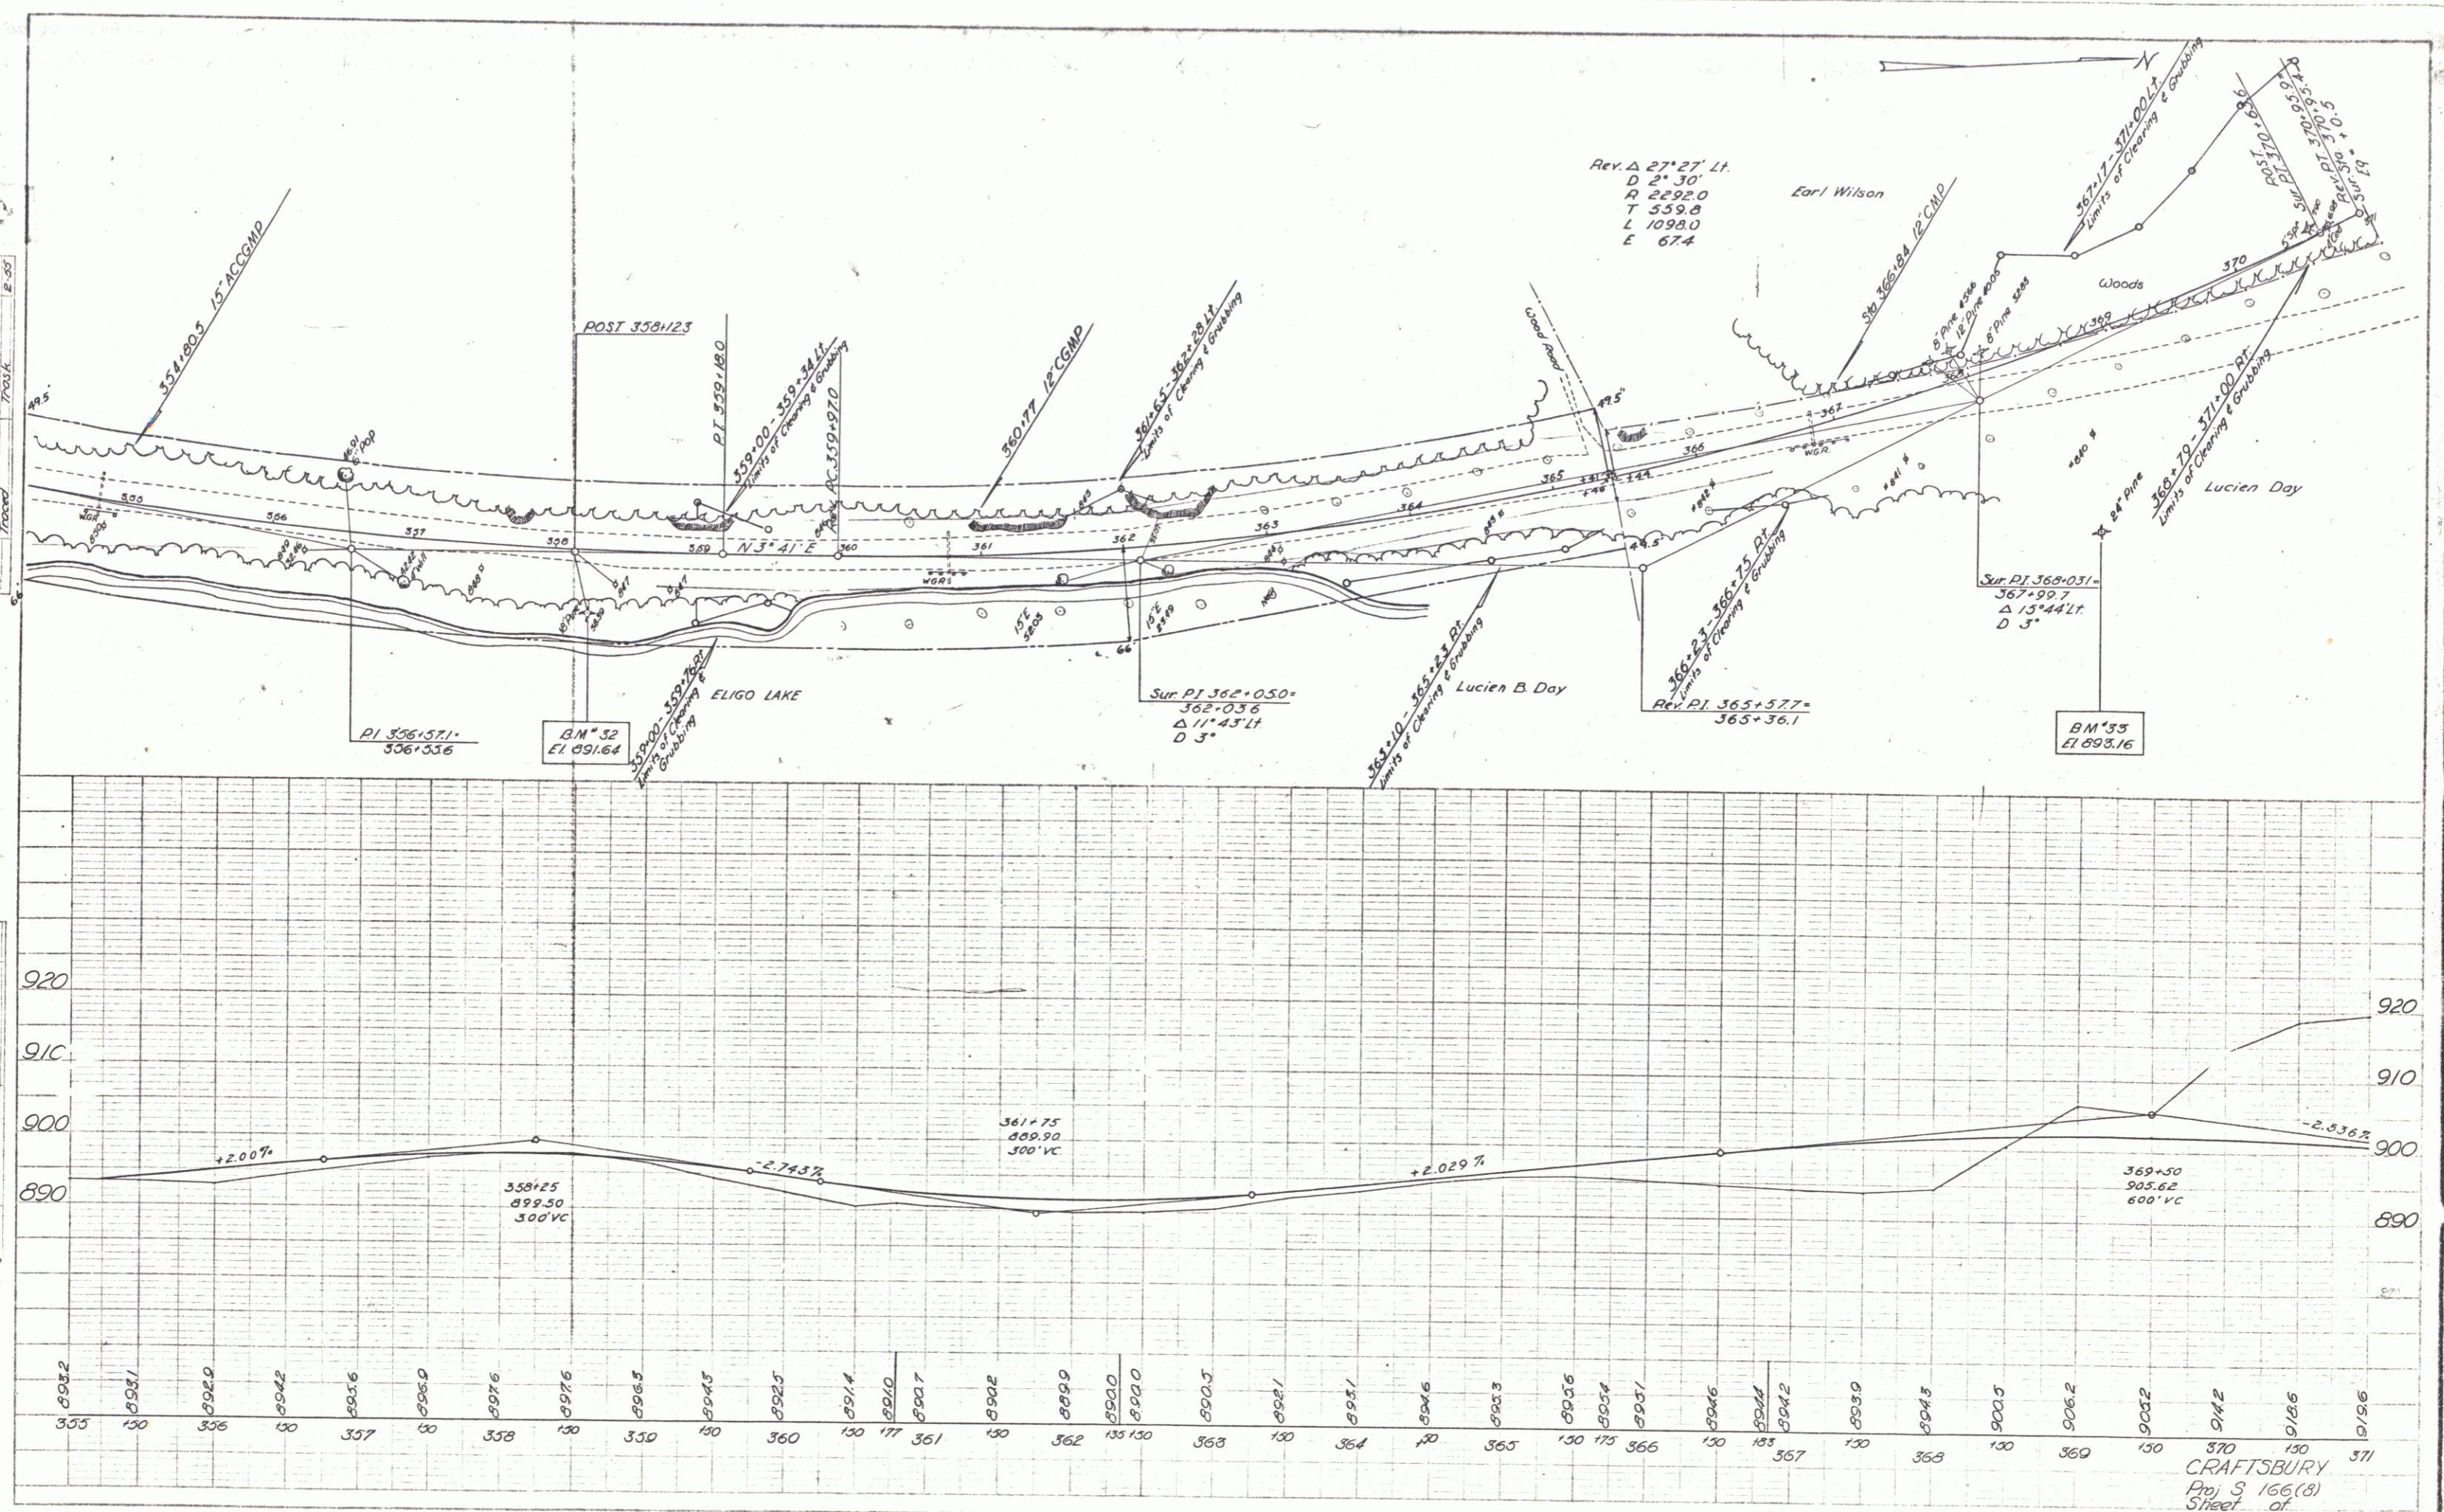

REV. Δ 27° 27' Lt.  
 D 2' 30"  
 R 2292.0  
 T 559.8  
 L 1098.0  
 E 674

Sur. PI 368+031-  
 367+99.7  
 Δ 15° 44' Lt.  
 D 3'

BM 53  
 El 893.16

CRAFTSBURY  
 Proj. S 166(B)  
 Sheet of  
 This Sheet Considered as  
 10A on Proj. S 166(B) ①

10