


WESTERN-MARTIN INC. 11-25
 WESTERN-MARTIN INC. 11-25
IIB
 0.700 Acres ±
 509 + 93 RT - 530 + 43 RT
 Winfred P. & Irene B. Brow

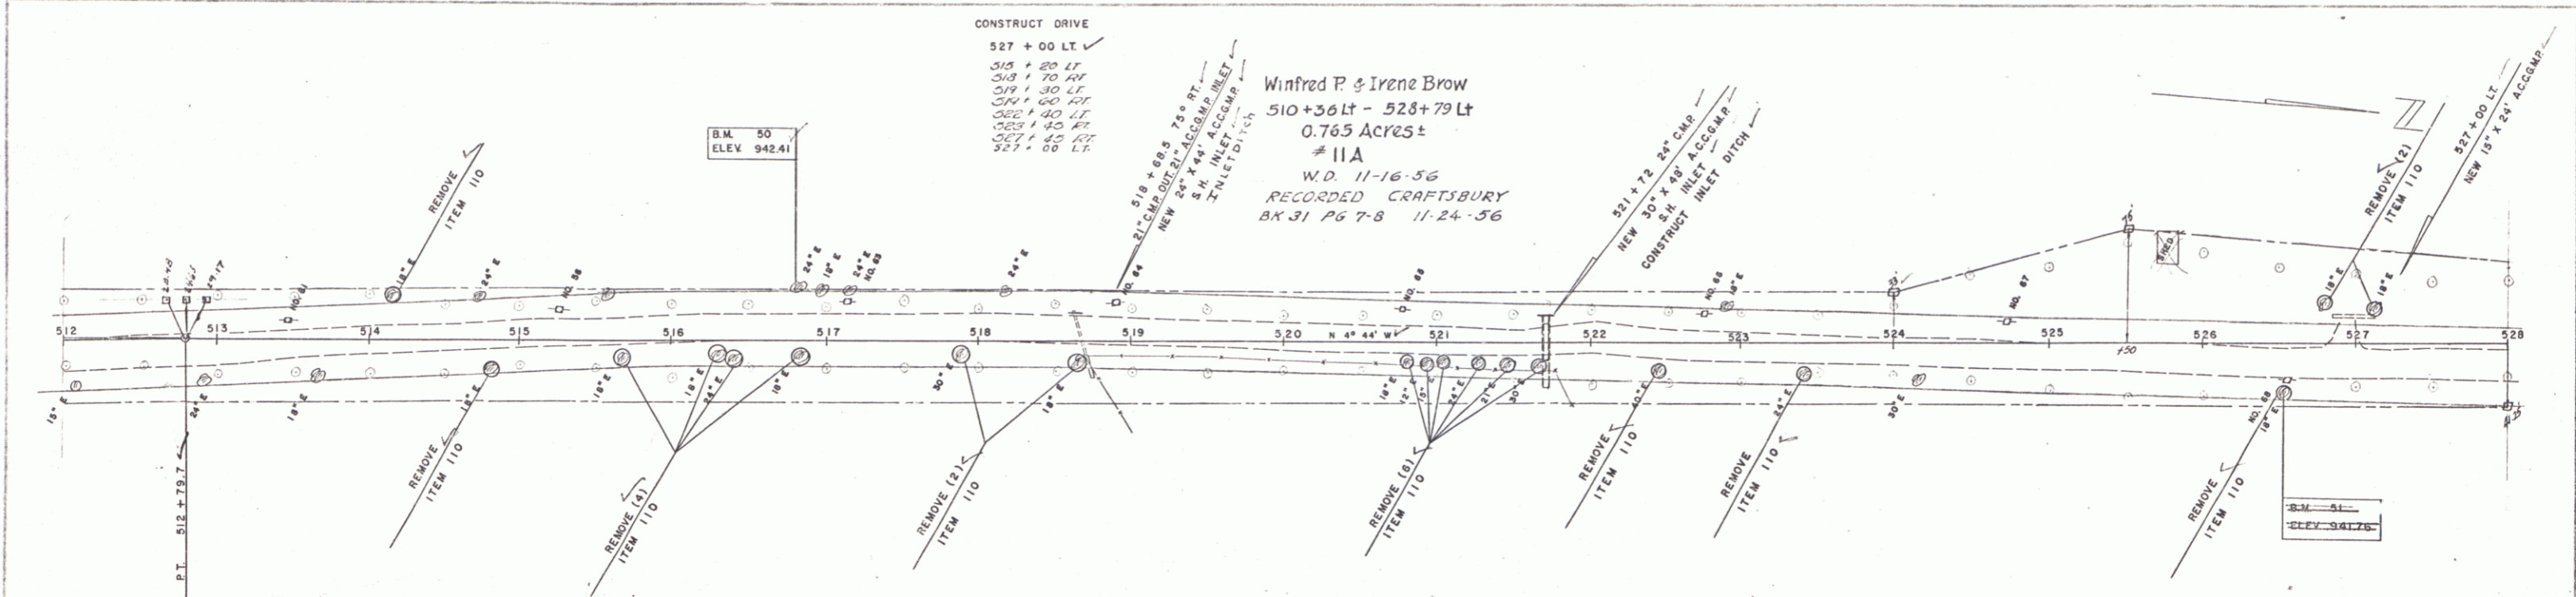