
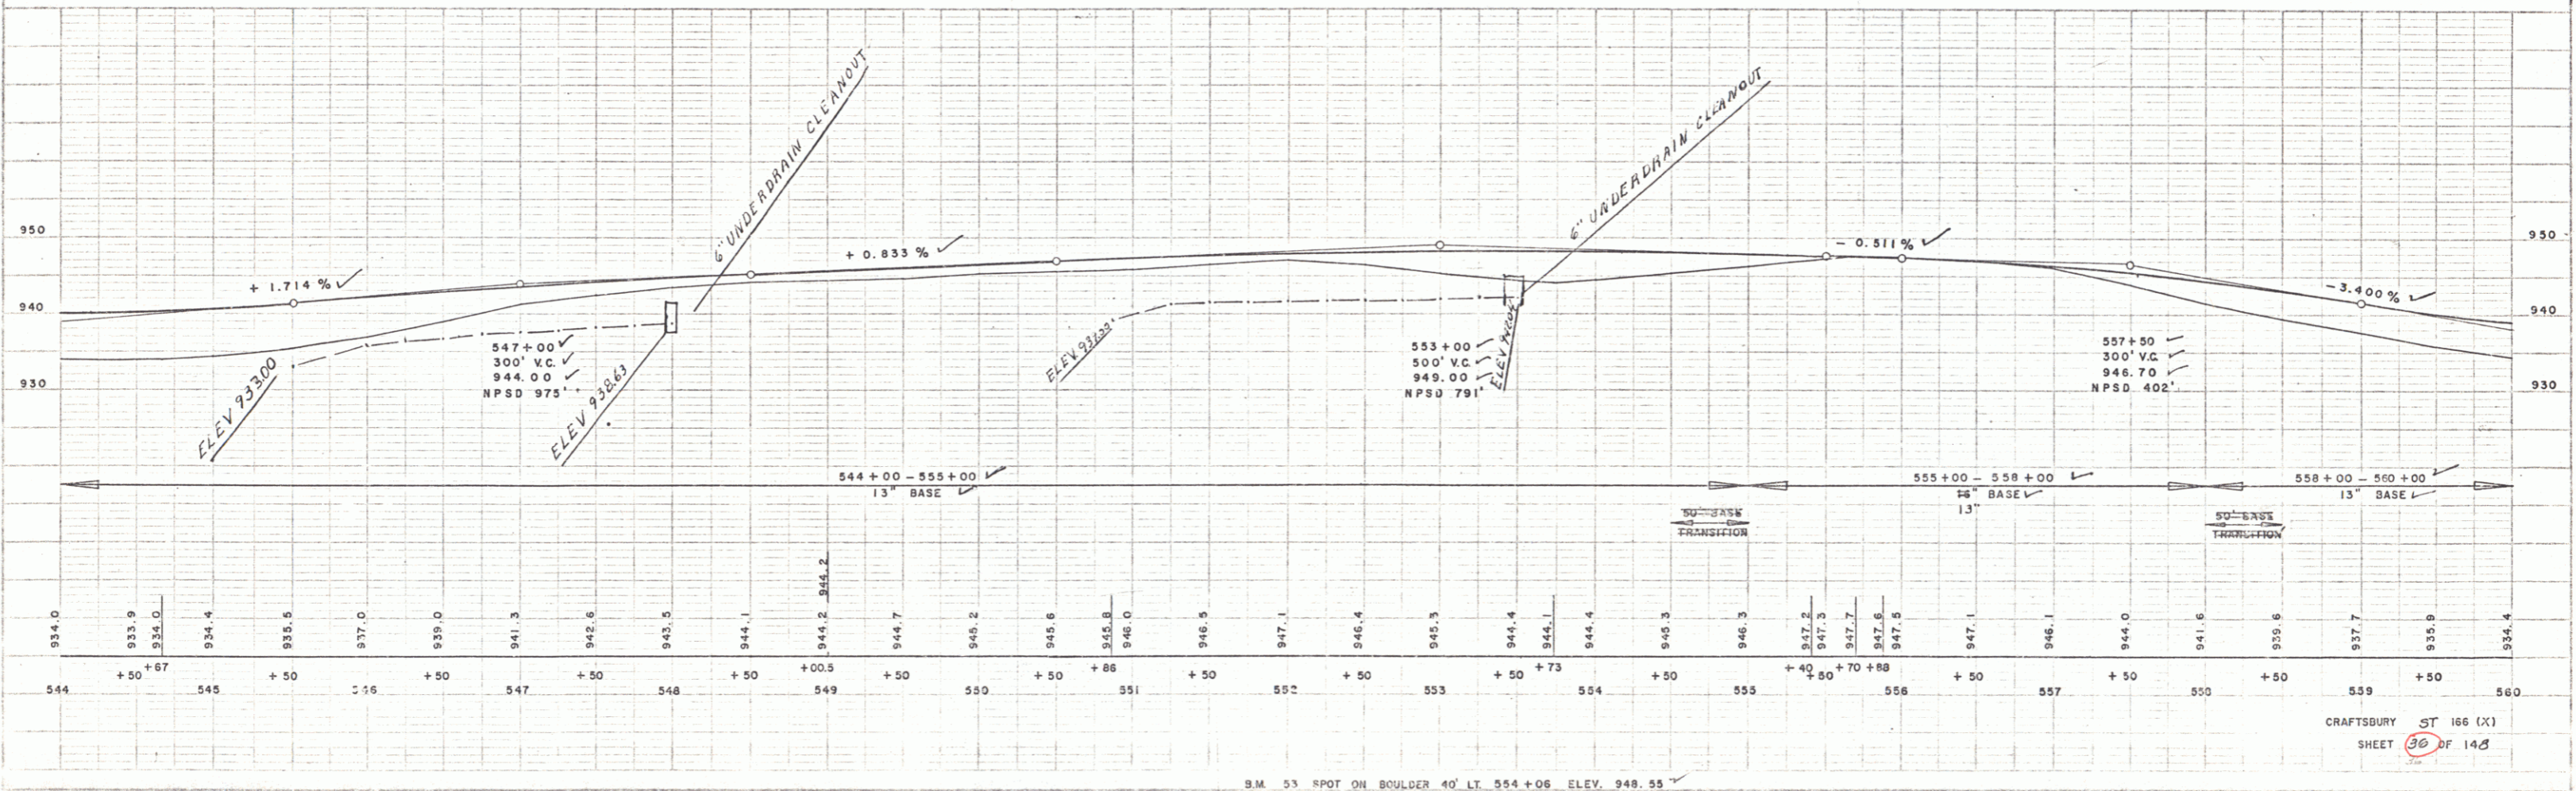


SPAWGLING  
WEBSTER-MARTIN INC. 11-56  
4-56

SPAWGLING  
WEBSTER-MARTIN INC. 11-56  
7-56

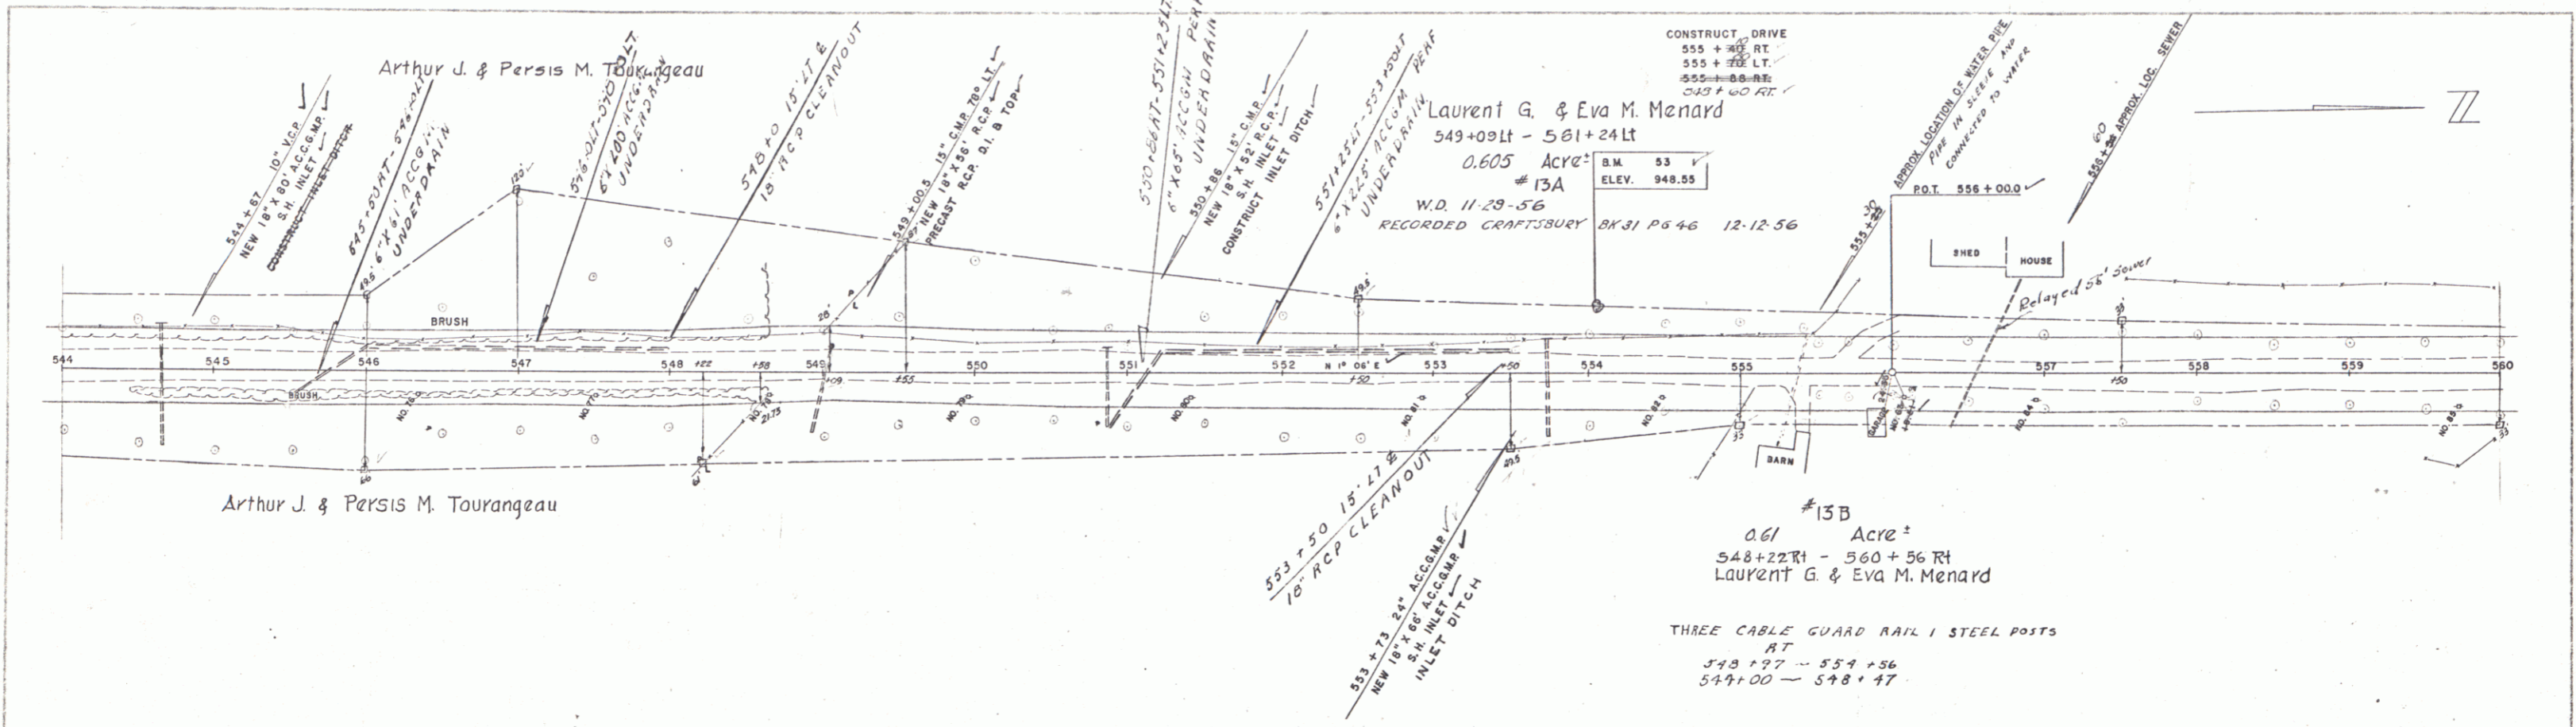

CRAFTSBURY ST 166 (X)  
SHEET 30 OF 148