


PLAN
 SPANGLONG
 WESTER-MARTIN INC. 11-56
 NO. 1000
 1000
 1000
 1000

THREE CABLE GUARD RAIL | STEEL POSTS
 LT
 615 + 50 - 624 + 00
 REMOVAL & DISPOSAL OF PRESENT GR. RAIL
 LT
 614 + 80 - 615 + 67 LT

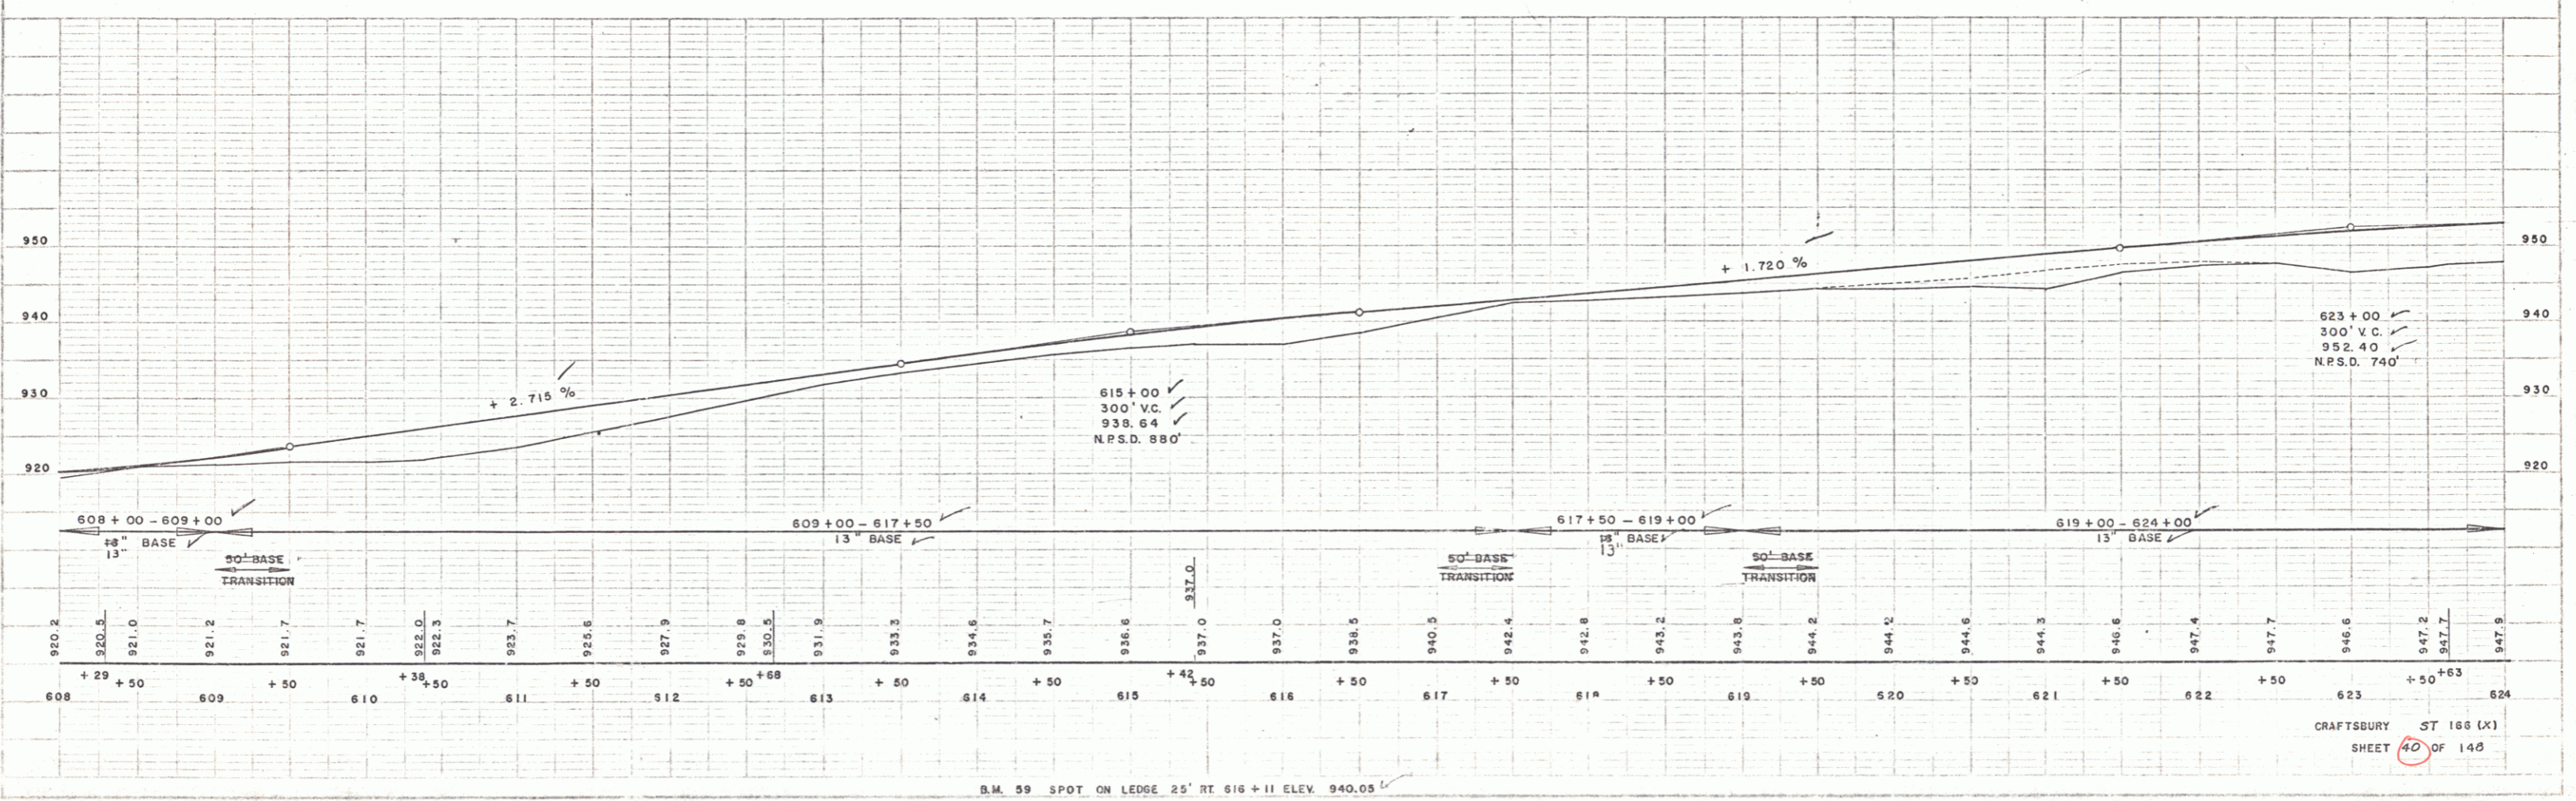

PLAN
 SPANGLONG
 WESTER-MARTIN INC. 11-56
 NO. 1000
 1000
 1000
 1000

B.M. 59 SPOT ON LEDGE 25' RT. 616 + 11 ELEV. 940.05

CRAFTSBURY ST 166 (X)
 SHEET 40 OF 146