
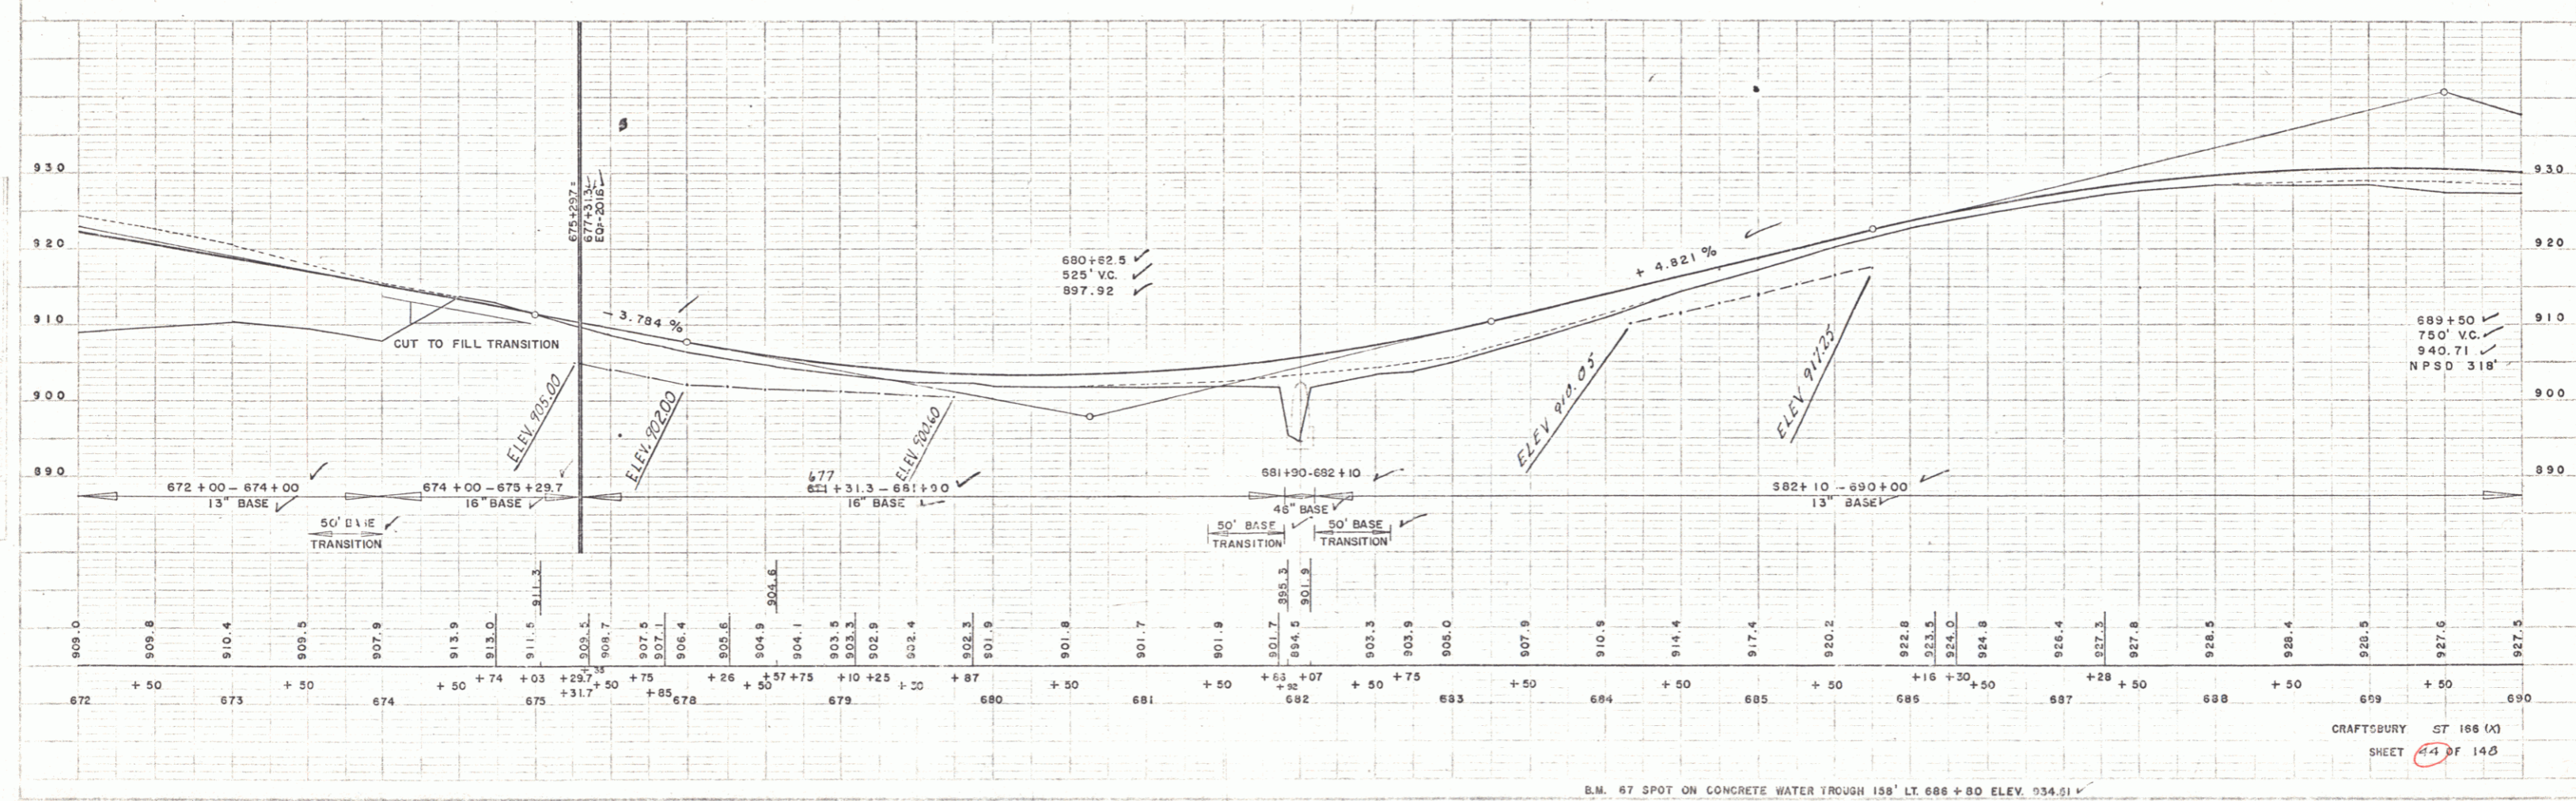


3

PLAN
SCALE 1" = 40'
WESTERN-MARTIN INC. 11-25

SECTION
SCALE 1" = 40'
WESTERN-MARTIN INC. 11-25

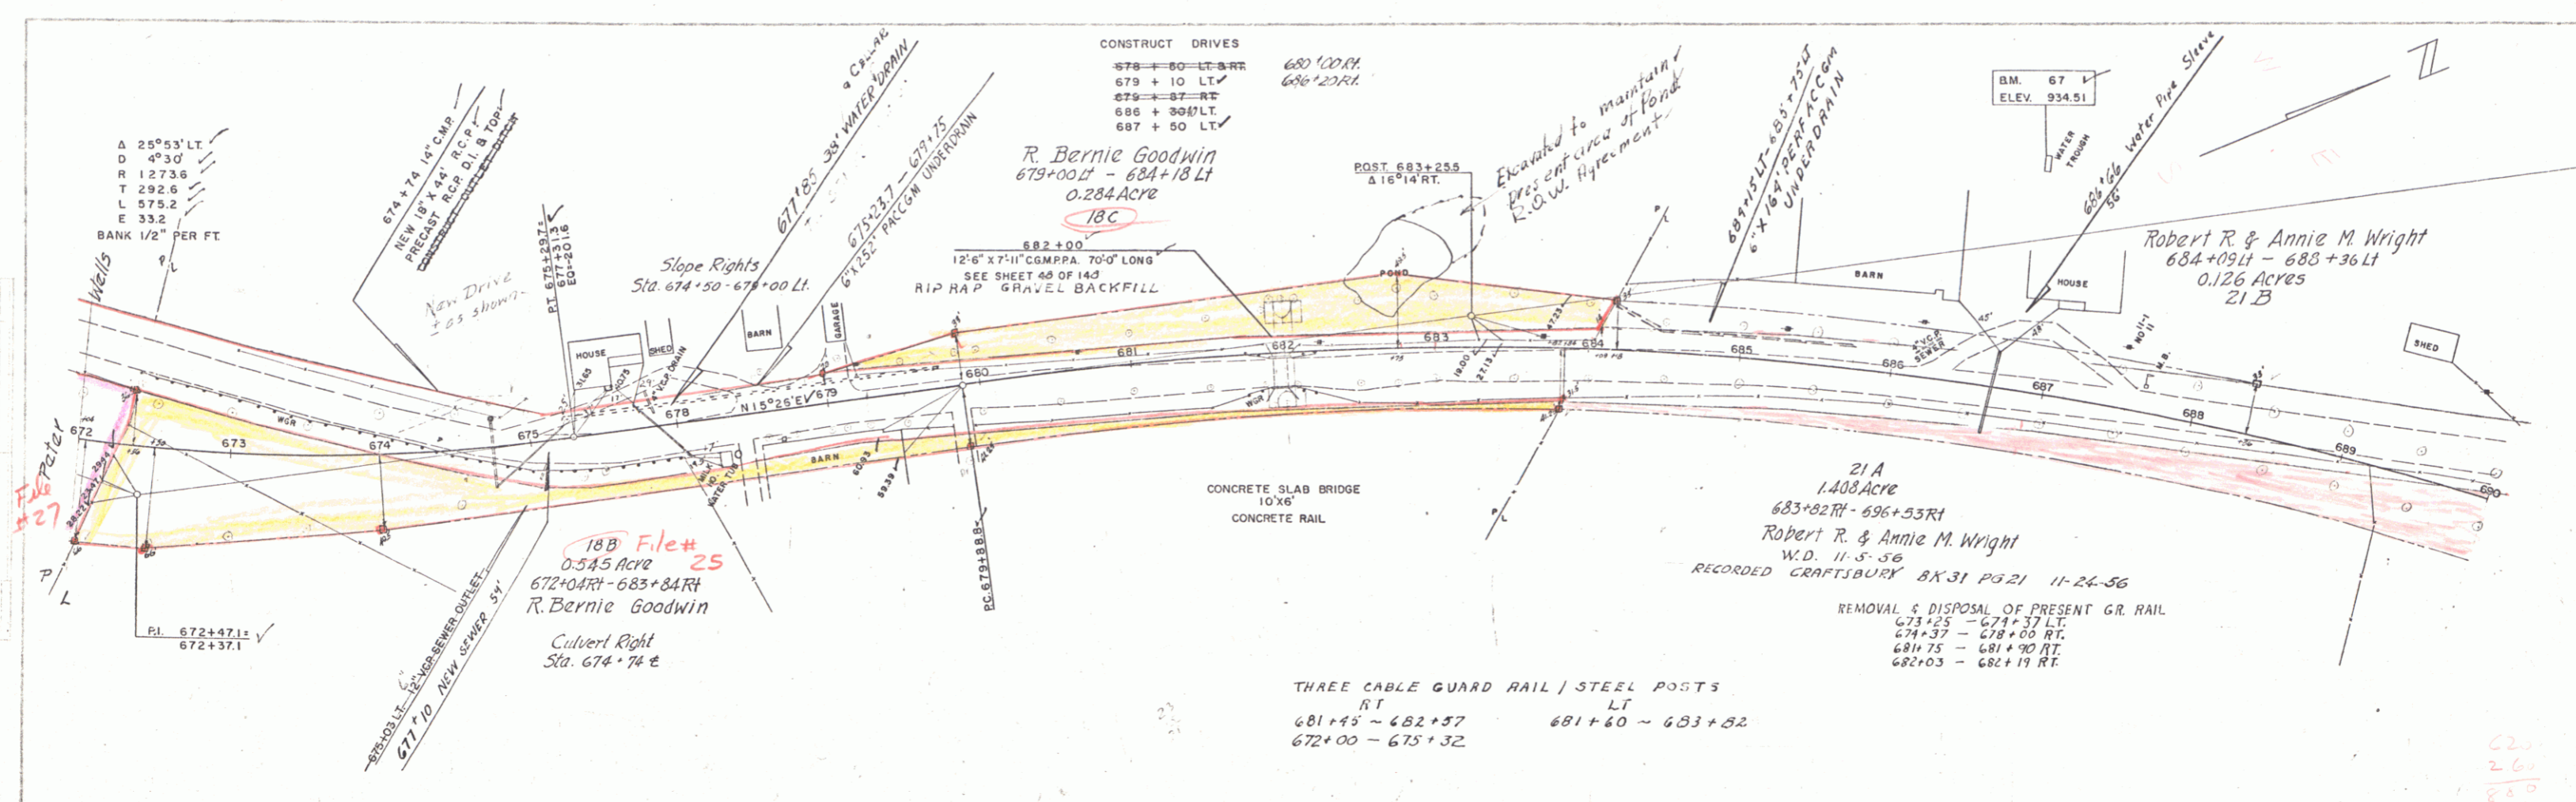

26
26
26

CRAFTSBURY ST 166 (X)
SHEET 41 OF 146

B.M. 67 SPOT ON CONCRETE WATER TROUGH 158' LT. 688 + 00 ELEV. 934.51'