


6-15  
 6-15  
 11-25  
 SPANGLING  
 WEBSTER-JARVIN INC.

6-15  
 6-15  
 11-25  
 SPANGLING  
 WEBSTER-JARVIN INC.

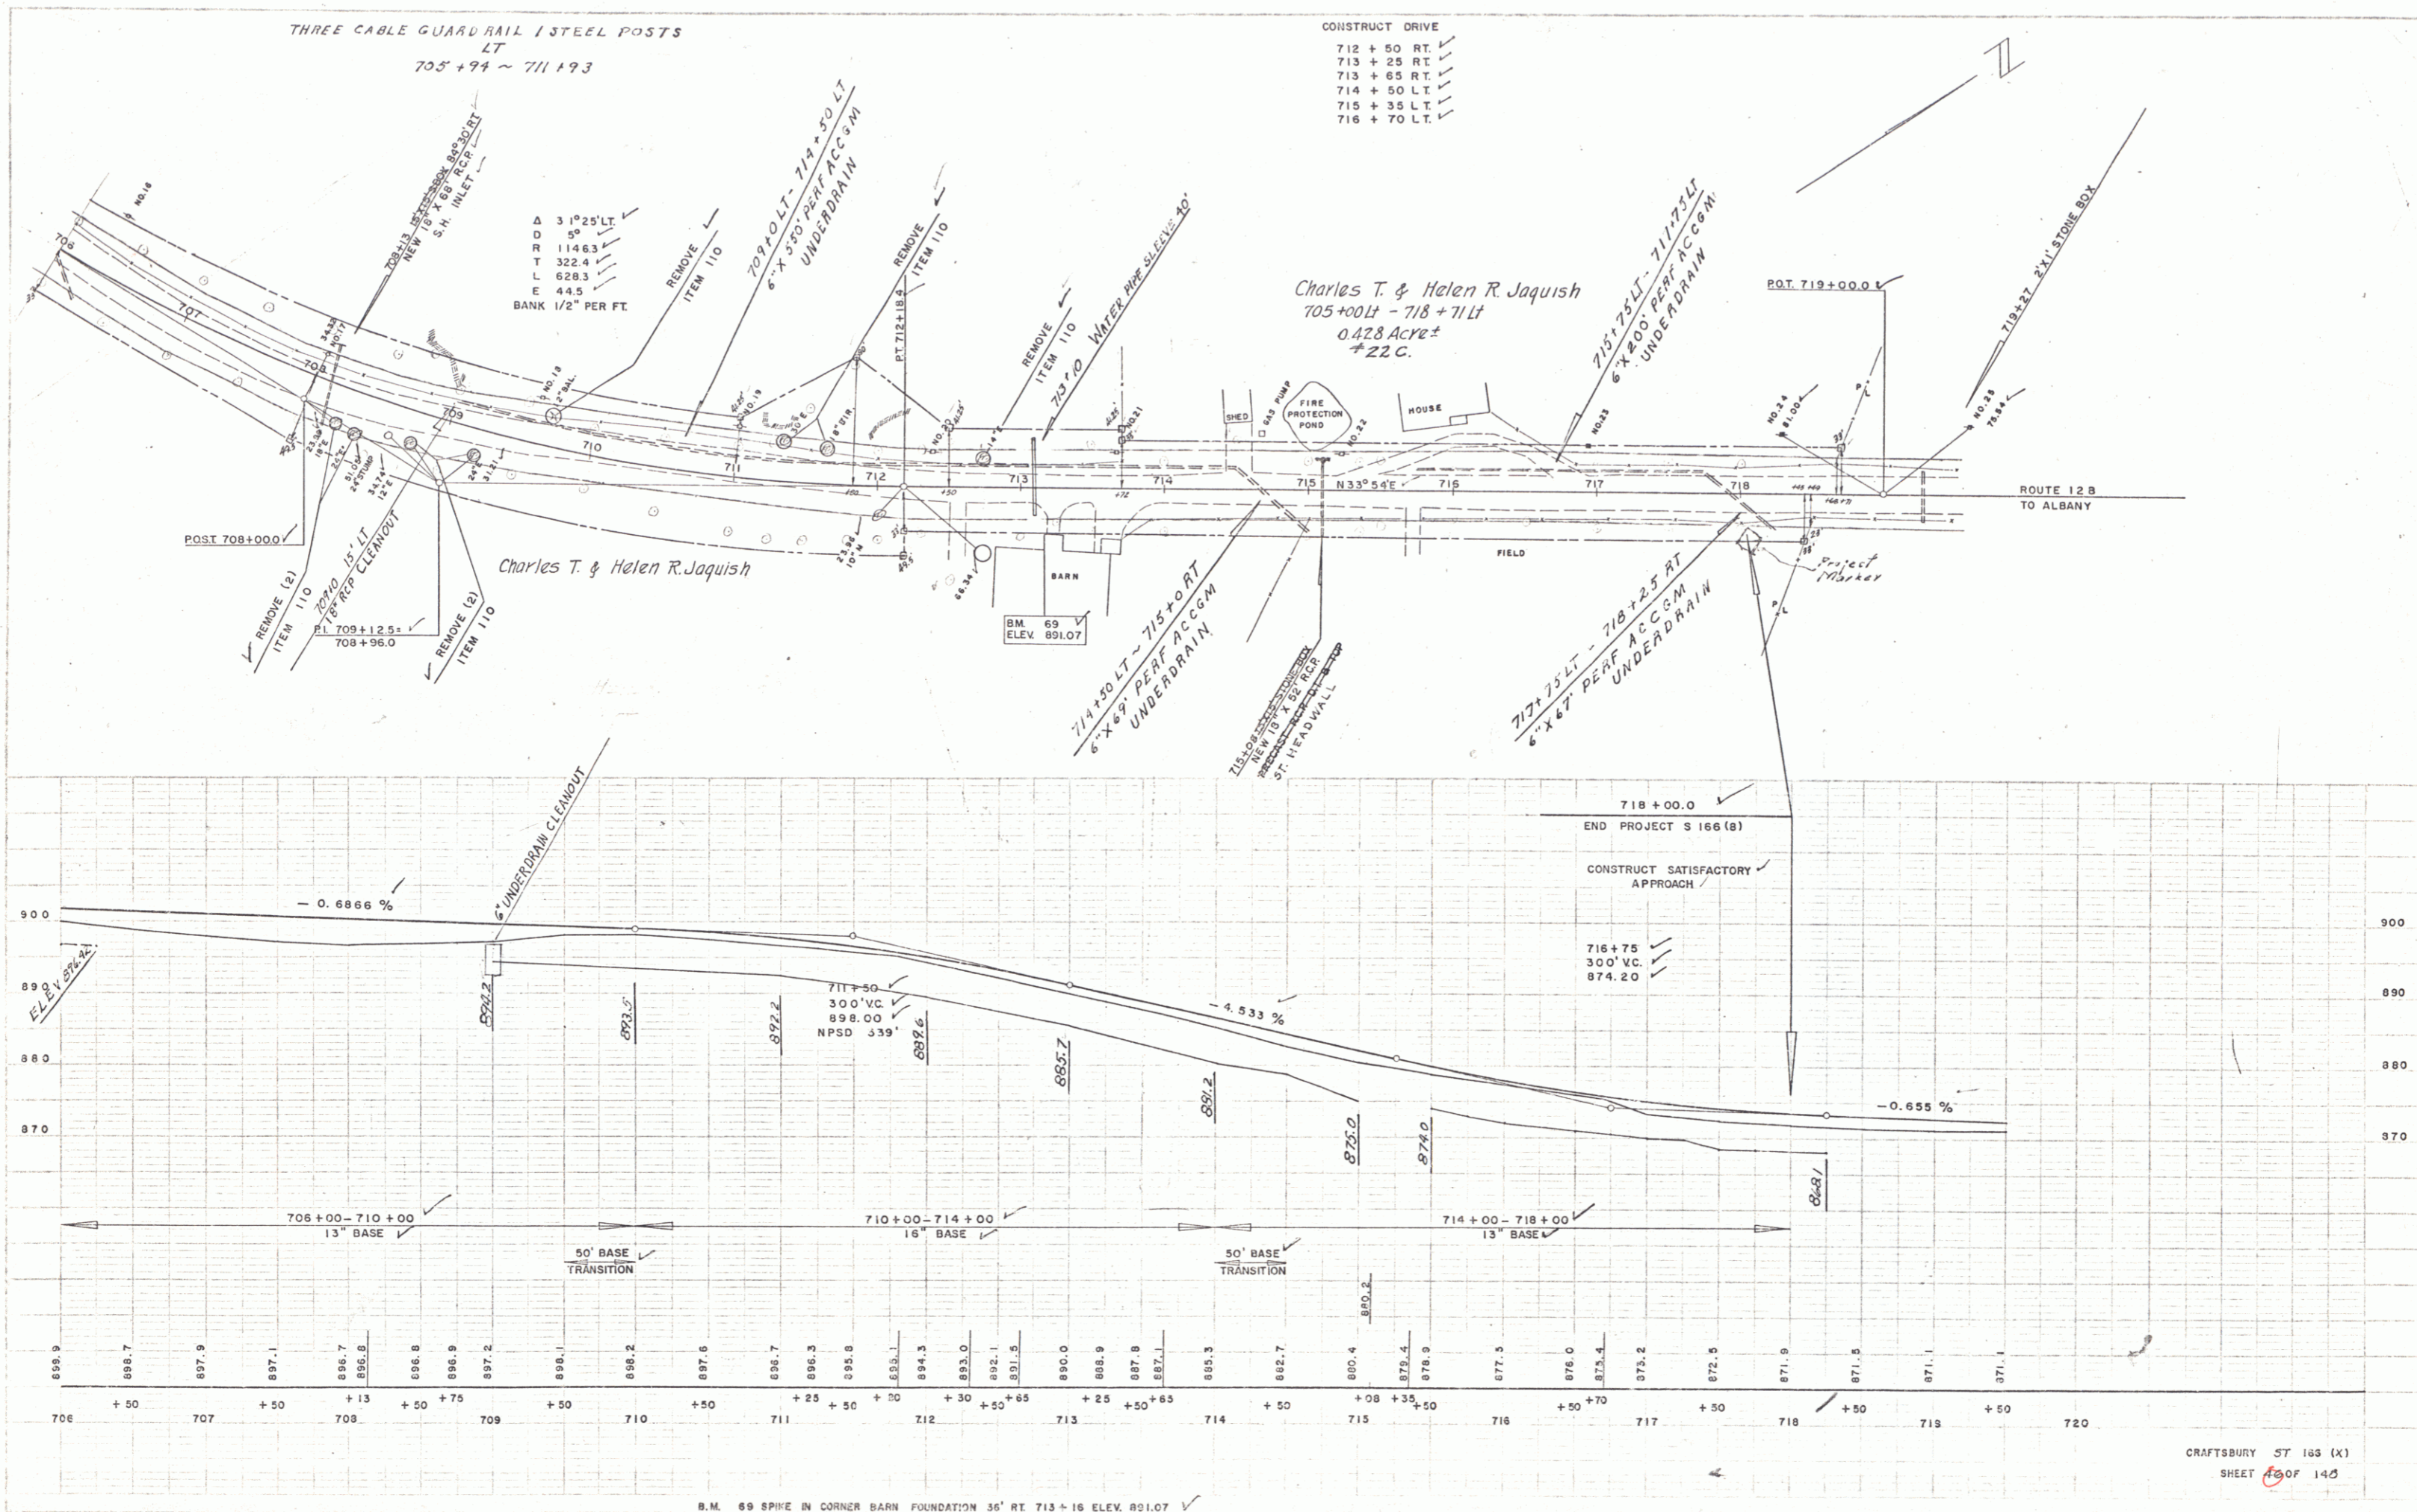

CRAFTSBURY ST 145 (X)  
 SHEET 145 OF 145