

PLAN	DATE	BY
REVISIONS		
NO.	DATE	BY
1		

PROFILE	DATE	BY
REVISIONS		
NO.	DATE	BY
1		

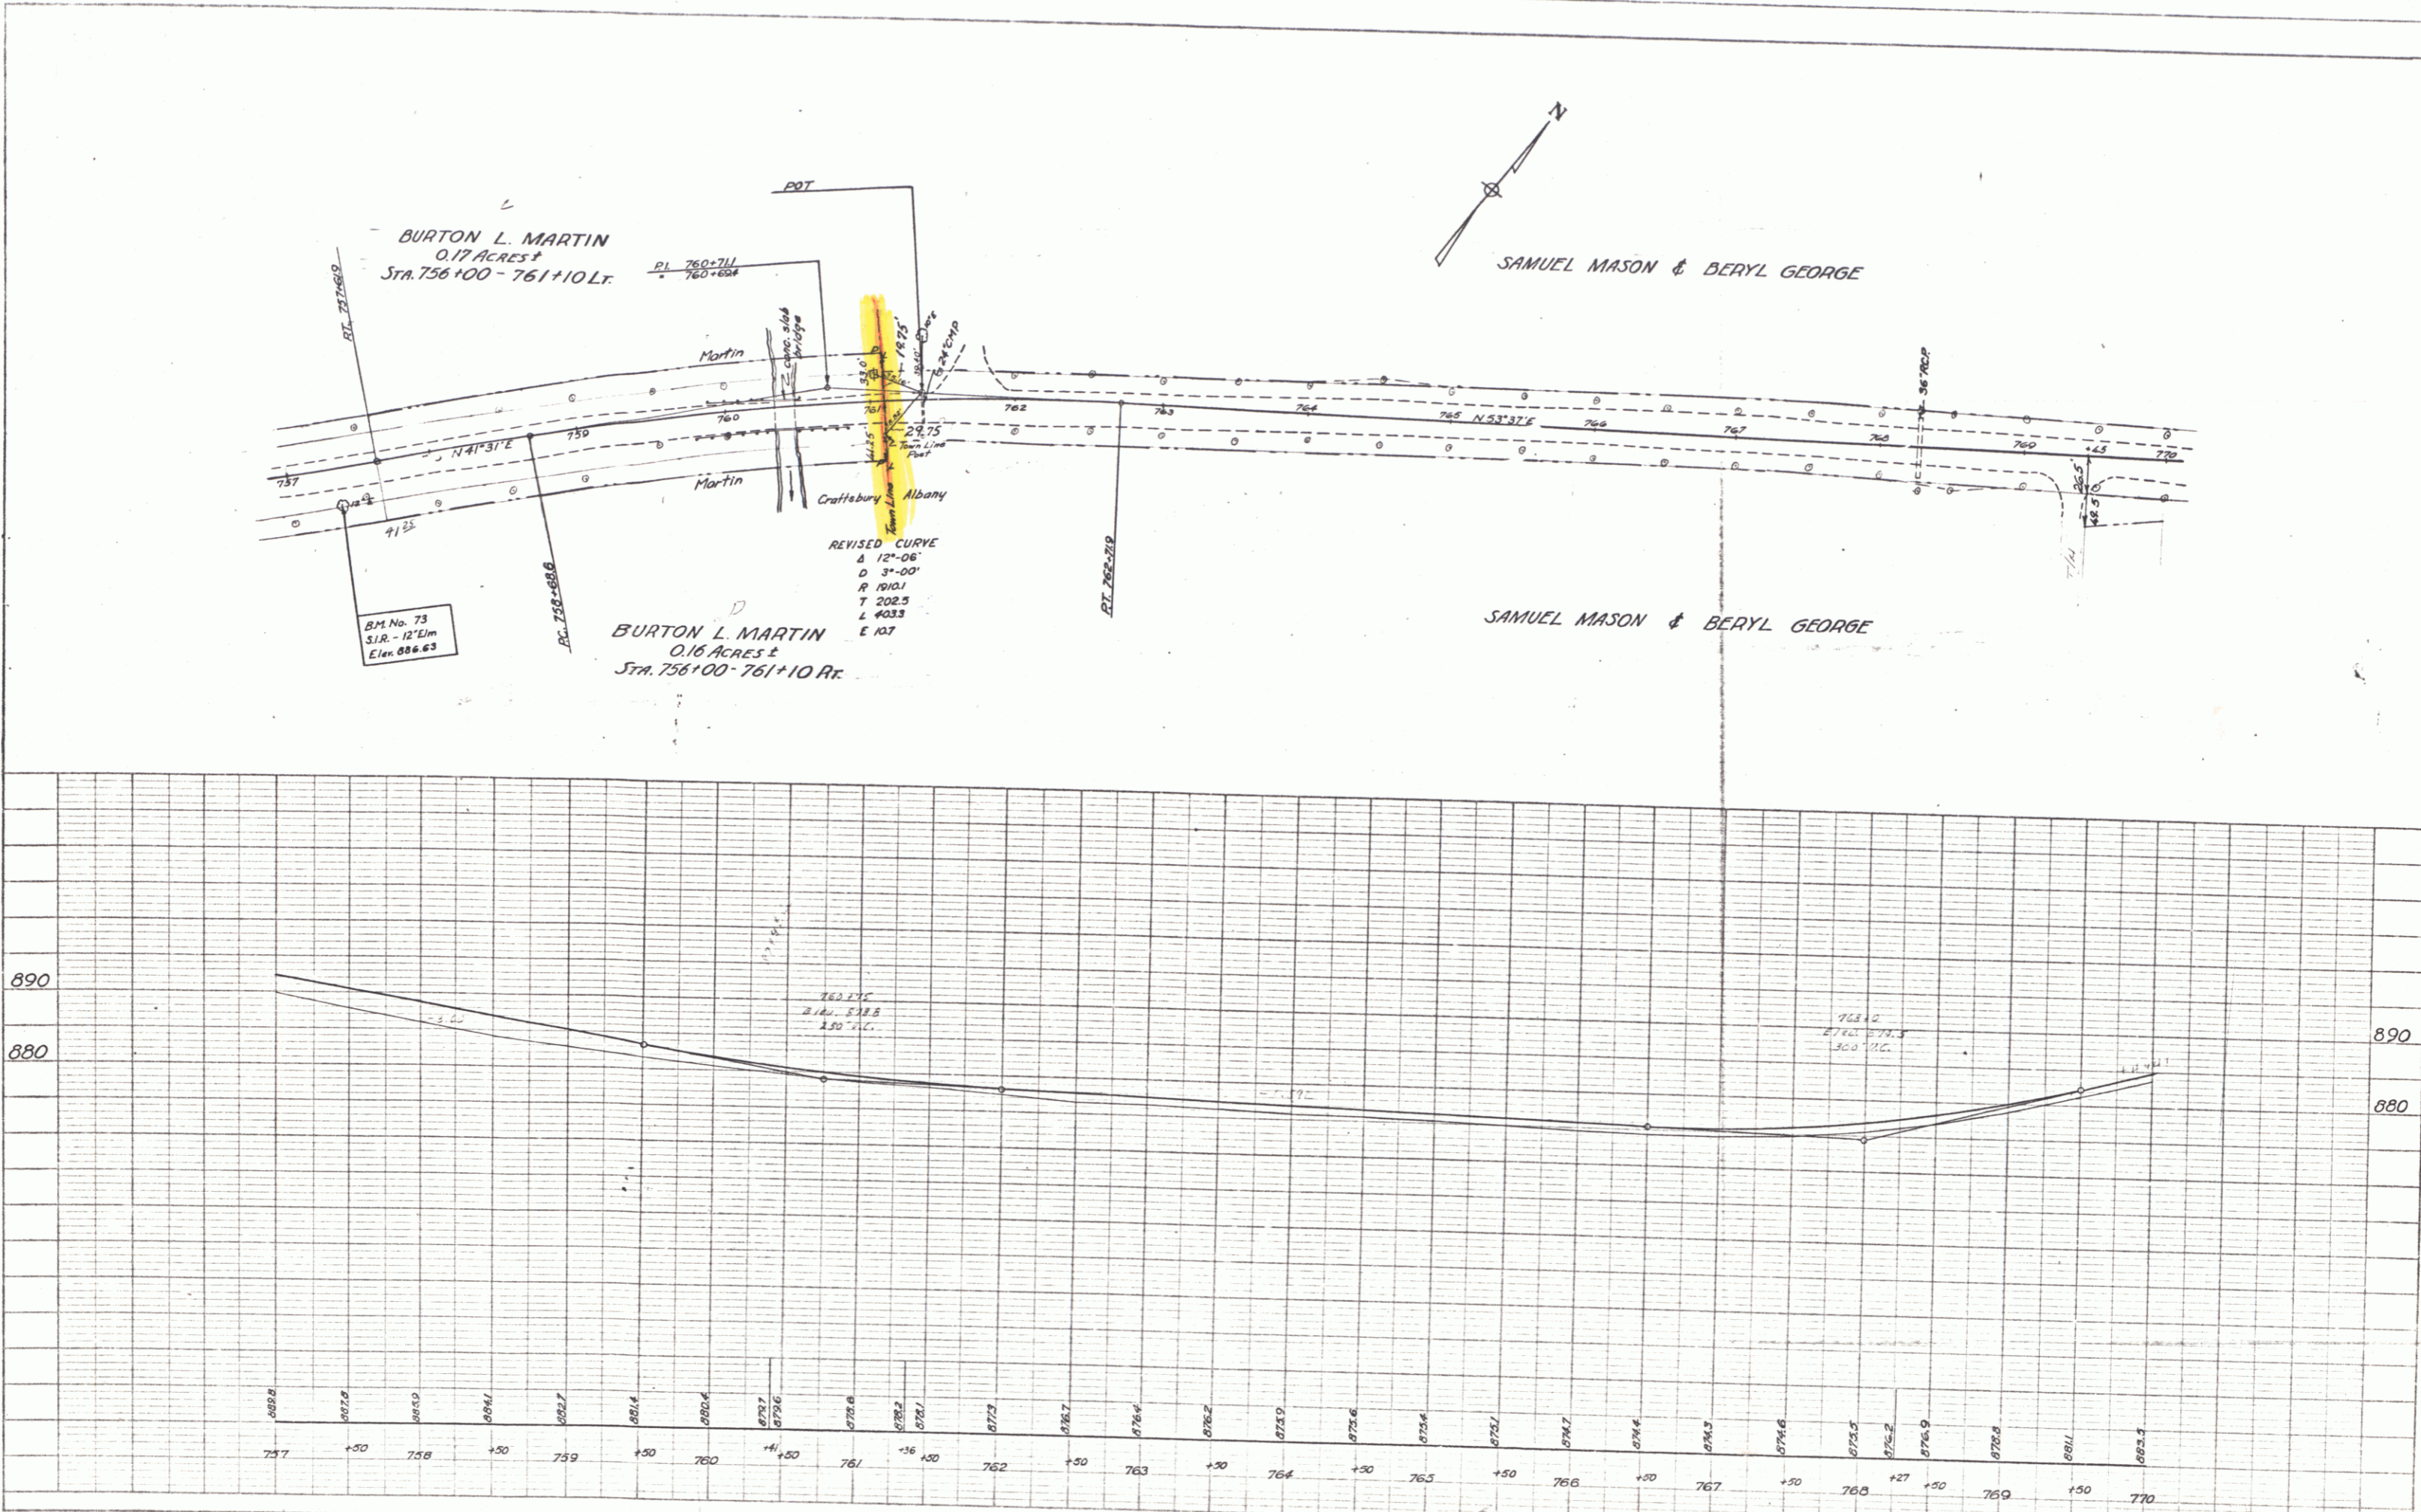


PLATE 1 - PLAN-PROFILE OF R.R. & E. STANDARD
SCALE: 1" = 40' HORIZ. 1" = 10' VERT.

5