

PLAN	DATE	BY
REVISION		
NOTES		
NO.		

PROFILE	DATE	BY
REVISION		
NOTES		
NO.		

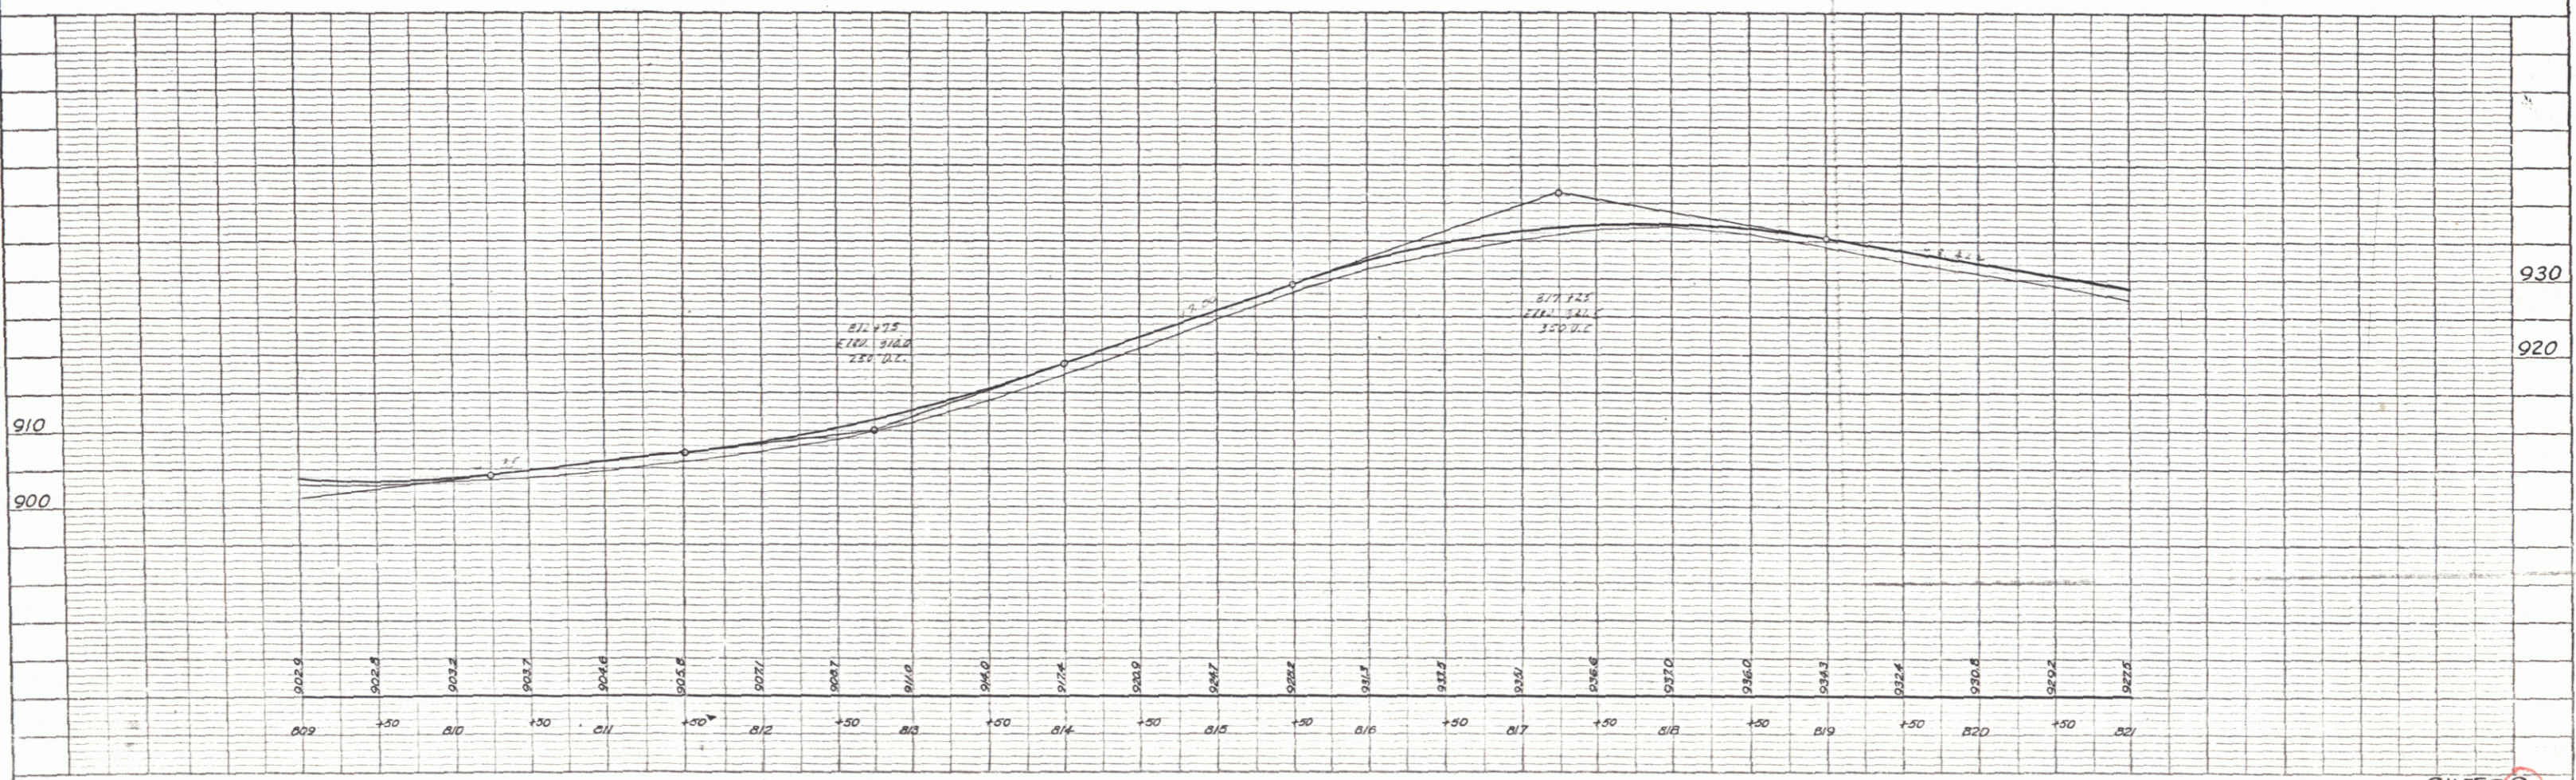
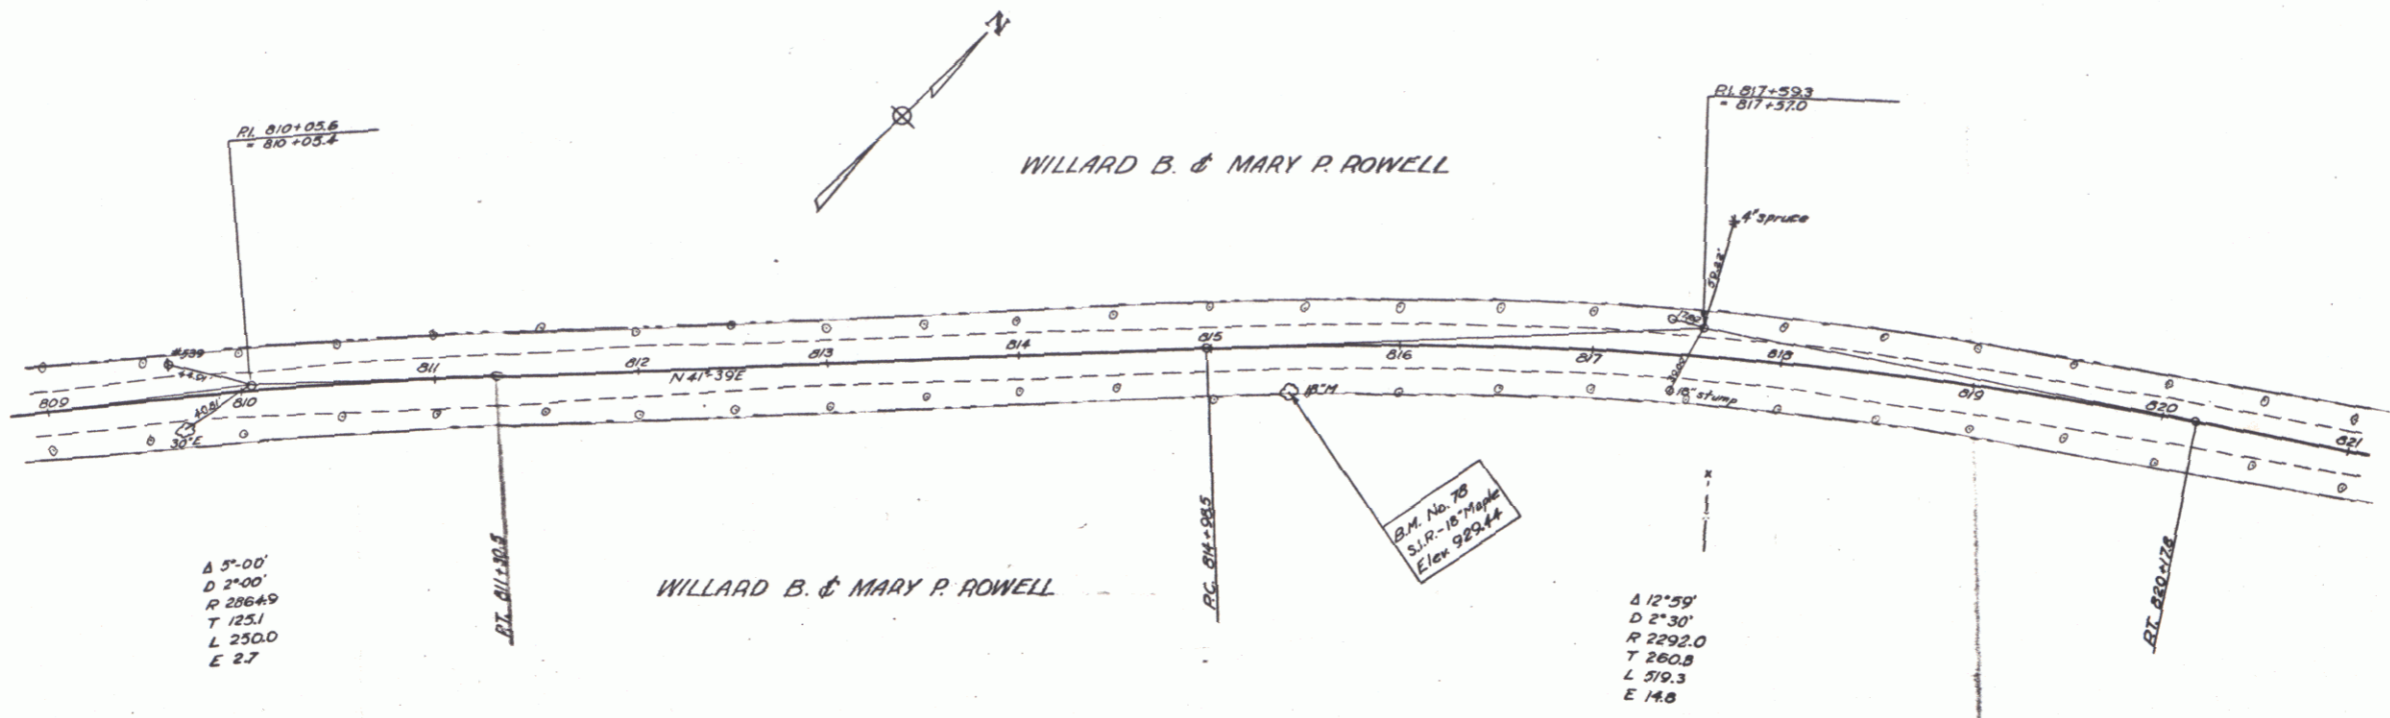


PLATE 1—PLAN—PROFILE OF F. A. & S. STAMM  
SCOTT & ESSEX CO., NEW YORK