


PLAN
 DRAWN BY: []
 CHECKED BY: []
 DATE: []

PROFILE
 DRAWN BY: []
 CHECKED BY: []
 DATE: []

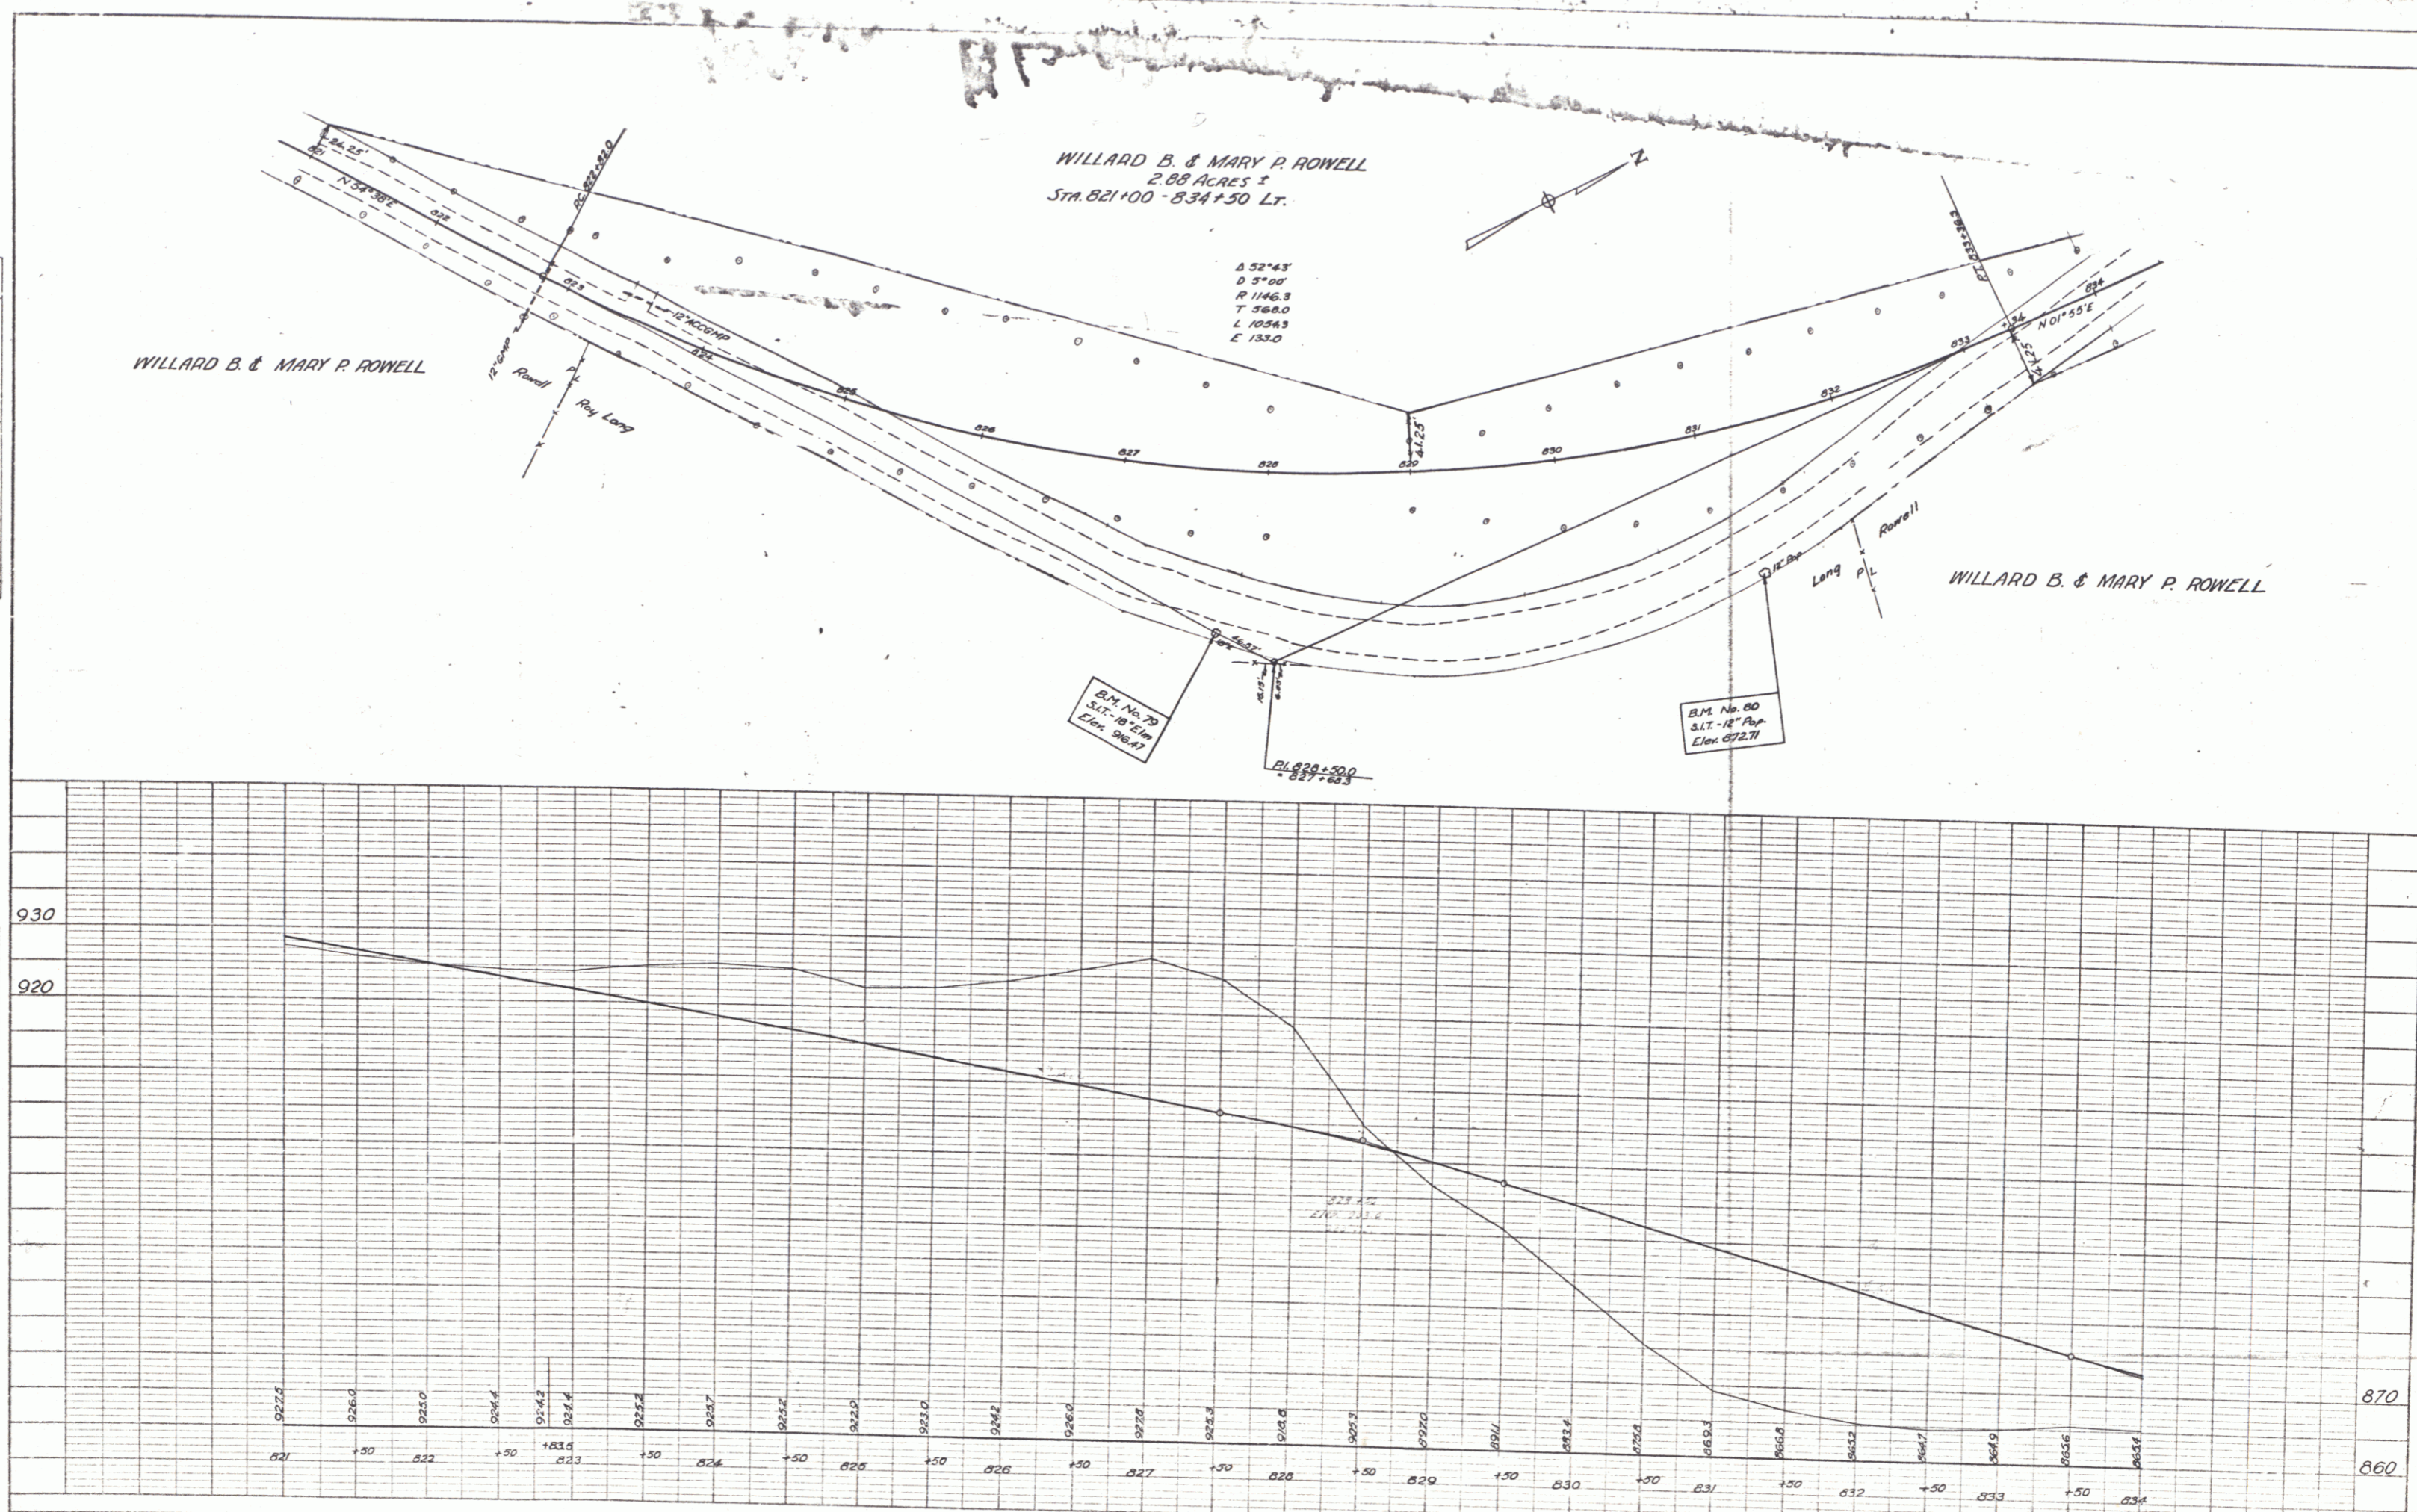

B.M. No. 70
 3 1/2" x 18" Pipe
 Elev. 916.42

B.M. No. 80
 3 1/2" x 18" Pipe
 Elev. 922.71

PLATE 1 - PLAN-PROFILE OF P.A.R.E. STANDARD
 NEWTON & ESTER CO., NEW YORK
 P.E. 1011-2450

SHEET 10
 Craftsbury Albany 166 V

10