


PLAN
 DRAWN BY
 CHECKED BY
 DATE

PROFILE
 DRAWN BY
 CHECKED BY
 DATE

ARCHIE L. & LAURA J. STONE

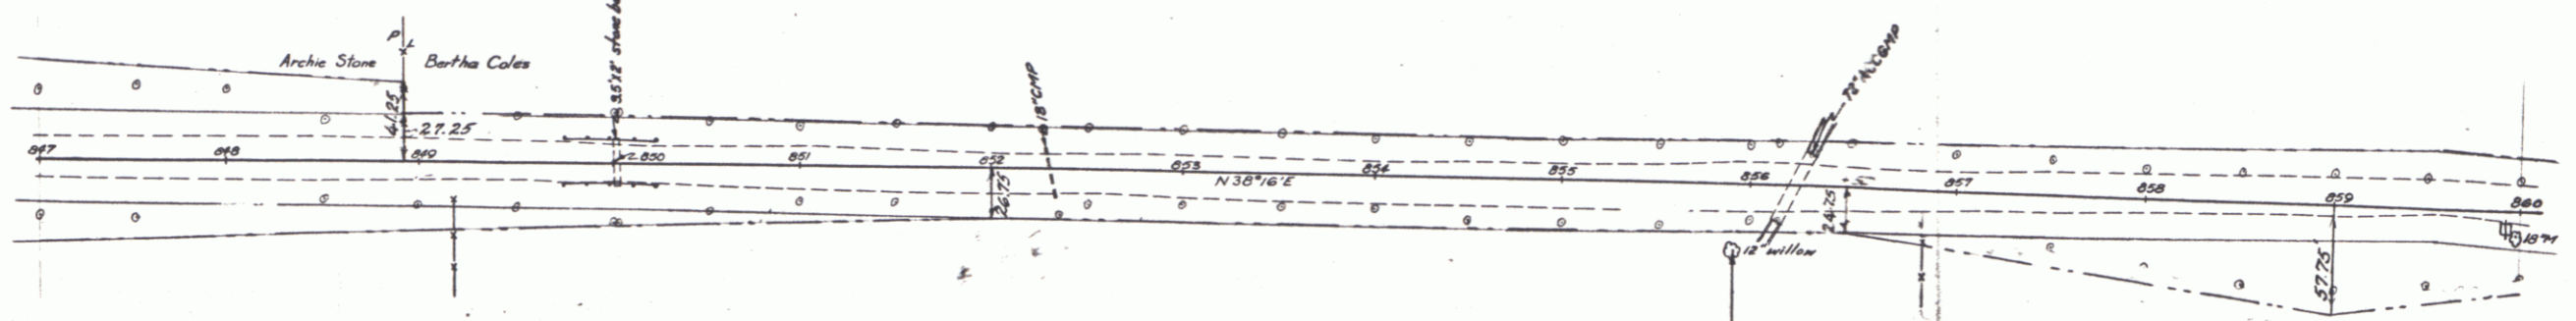

ROY L. LONG & CHARLES L. LONG
 0.25 ACRES ±
 STA. 856+50 - 861+50 RT.

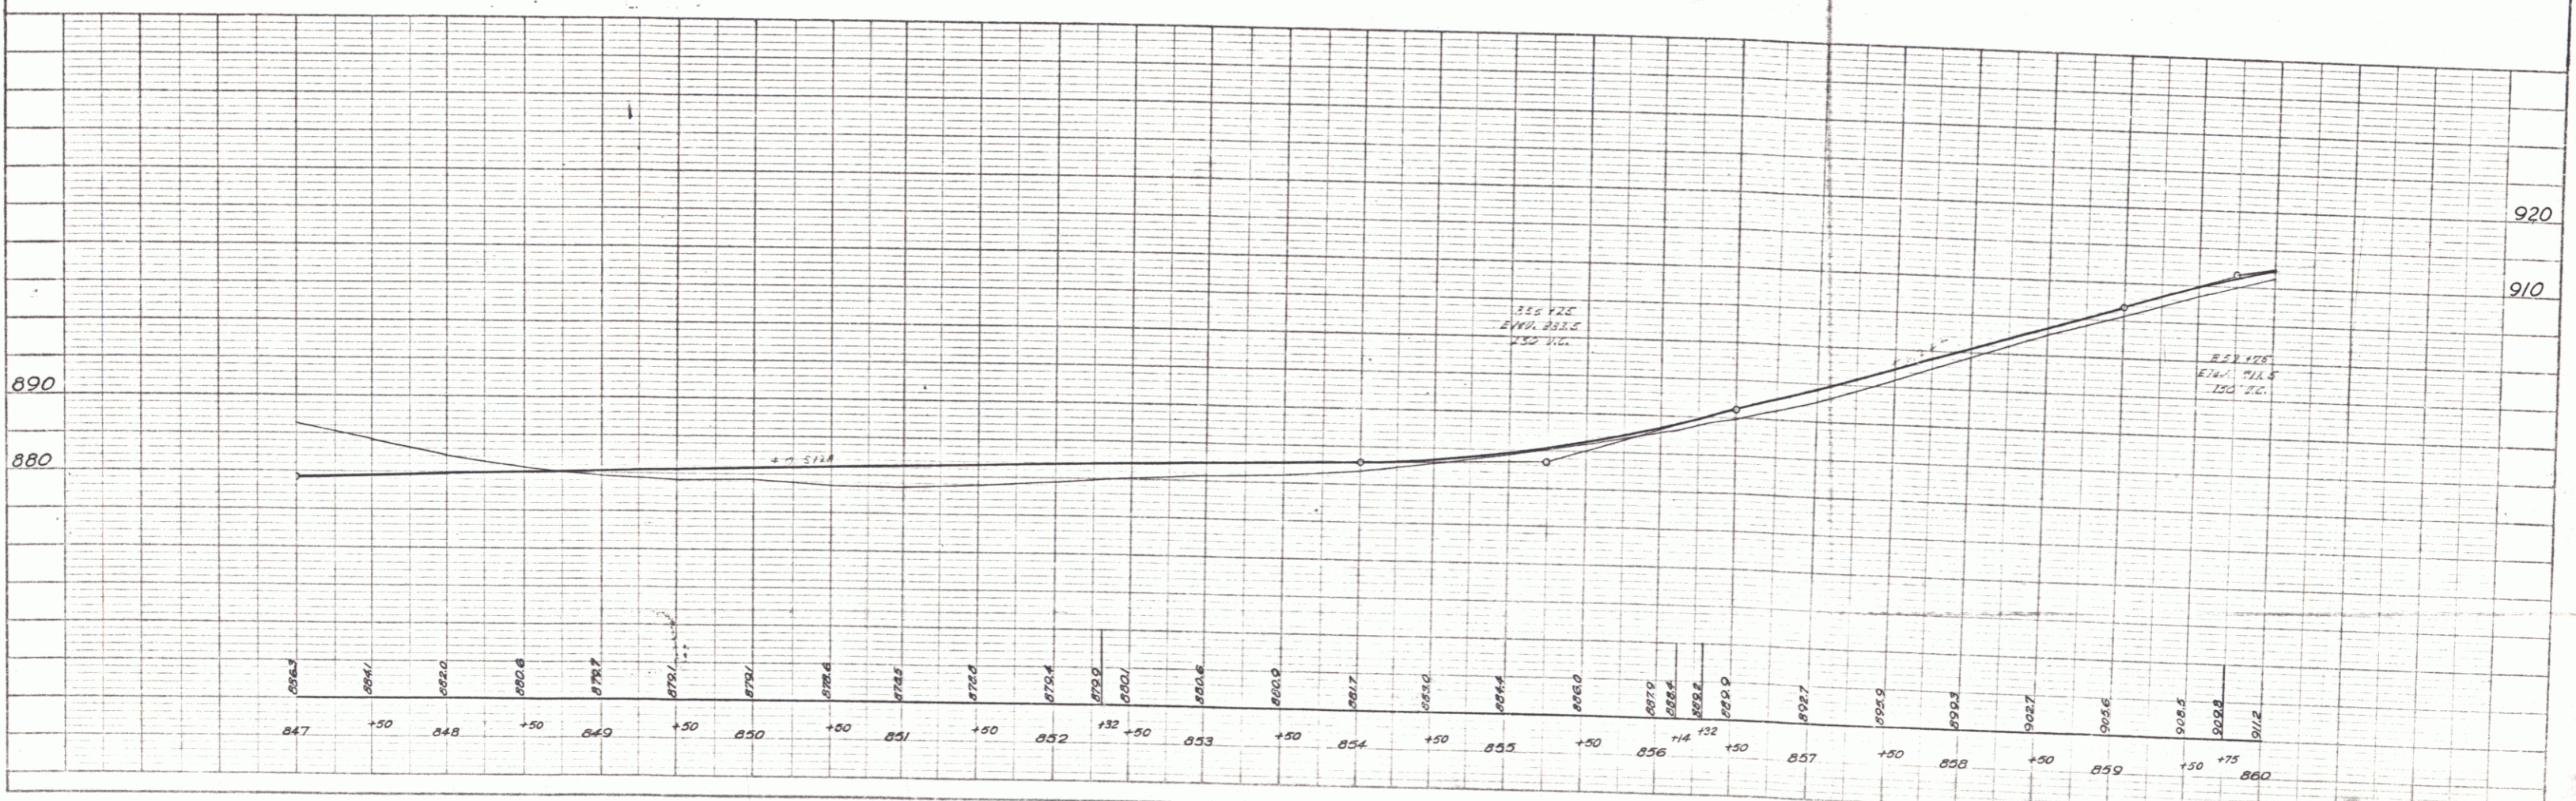


PLATE 1 - PLAN, PROFILE, & GRADE
 DRAWN BY
 CHECKED BY
 DATE

SHEET 12
 Croftsbury Albany 166V

12