

PLAN
 DATE: _____
 DRAWN BY: _____
 CHECKED BY: _____
 NO. _____

PROFILE
 DATE: _____
 DRAWN BY: _____
 CHECKED BY: _____
 NO. _____

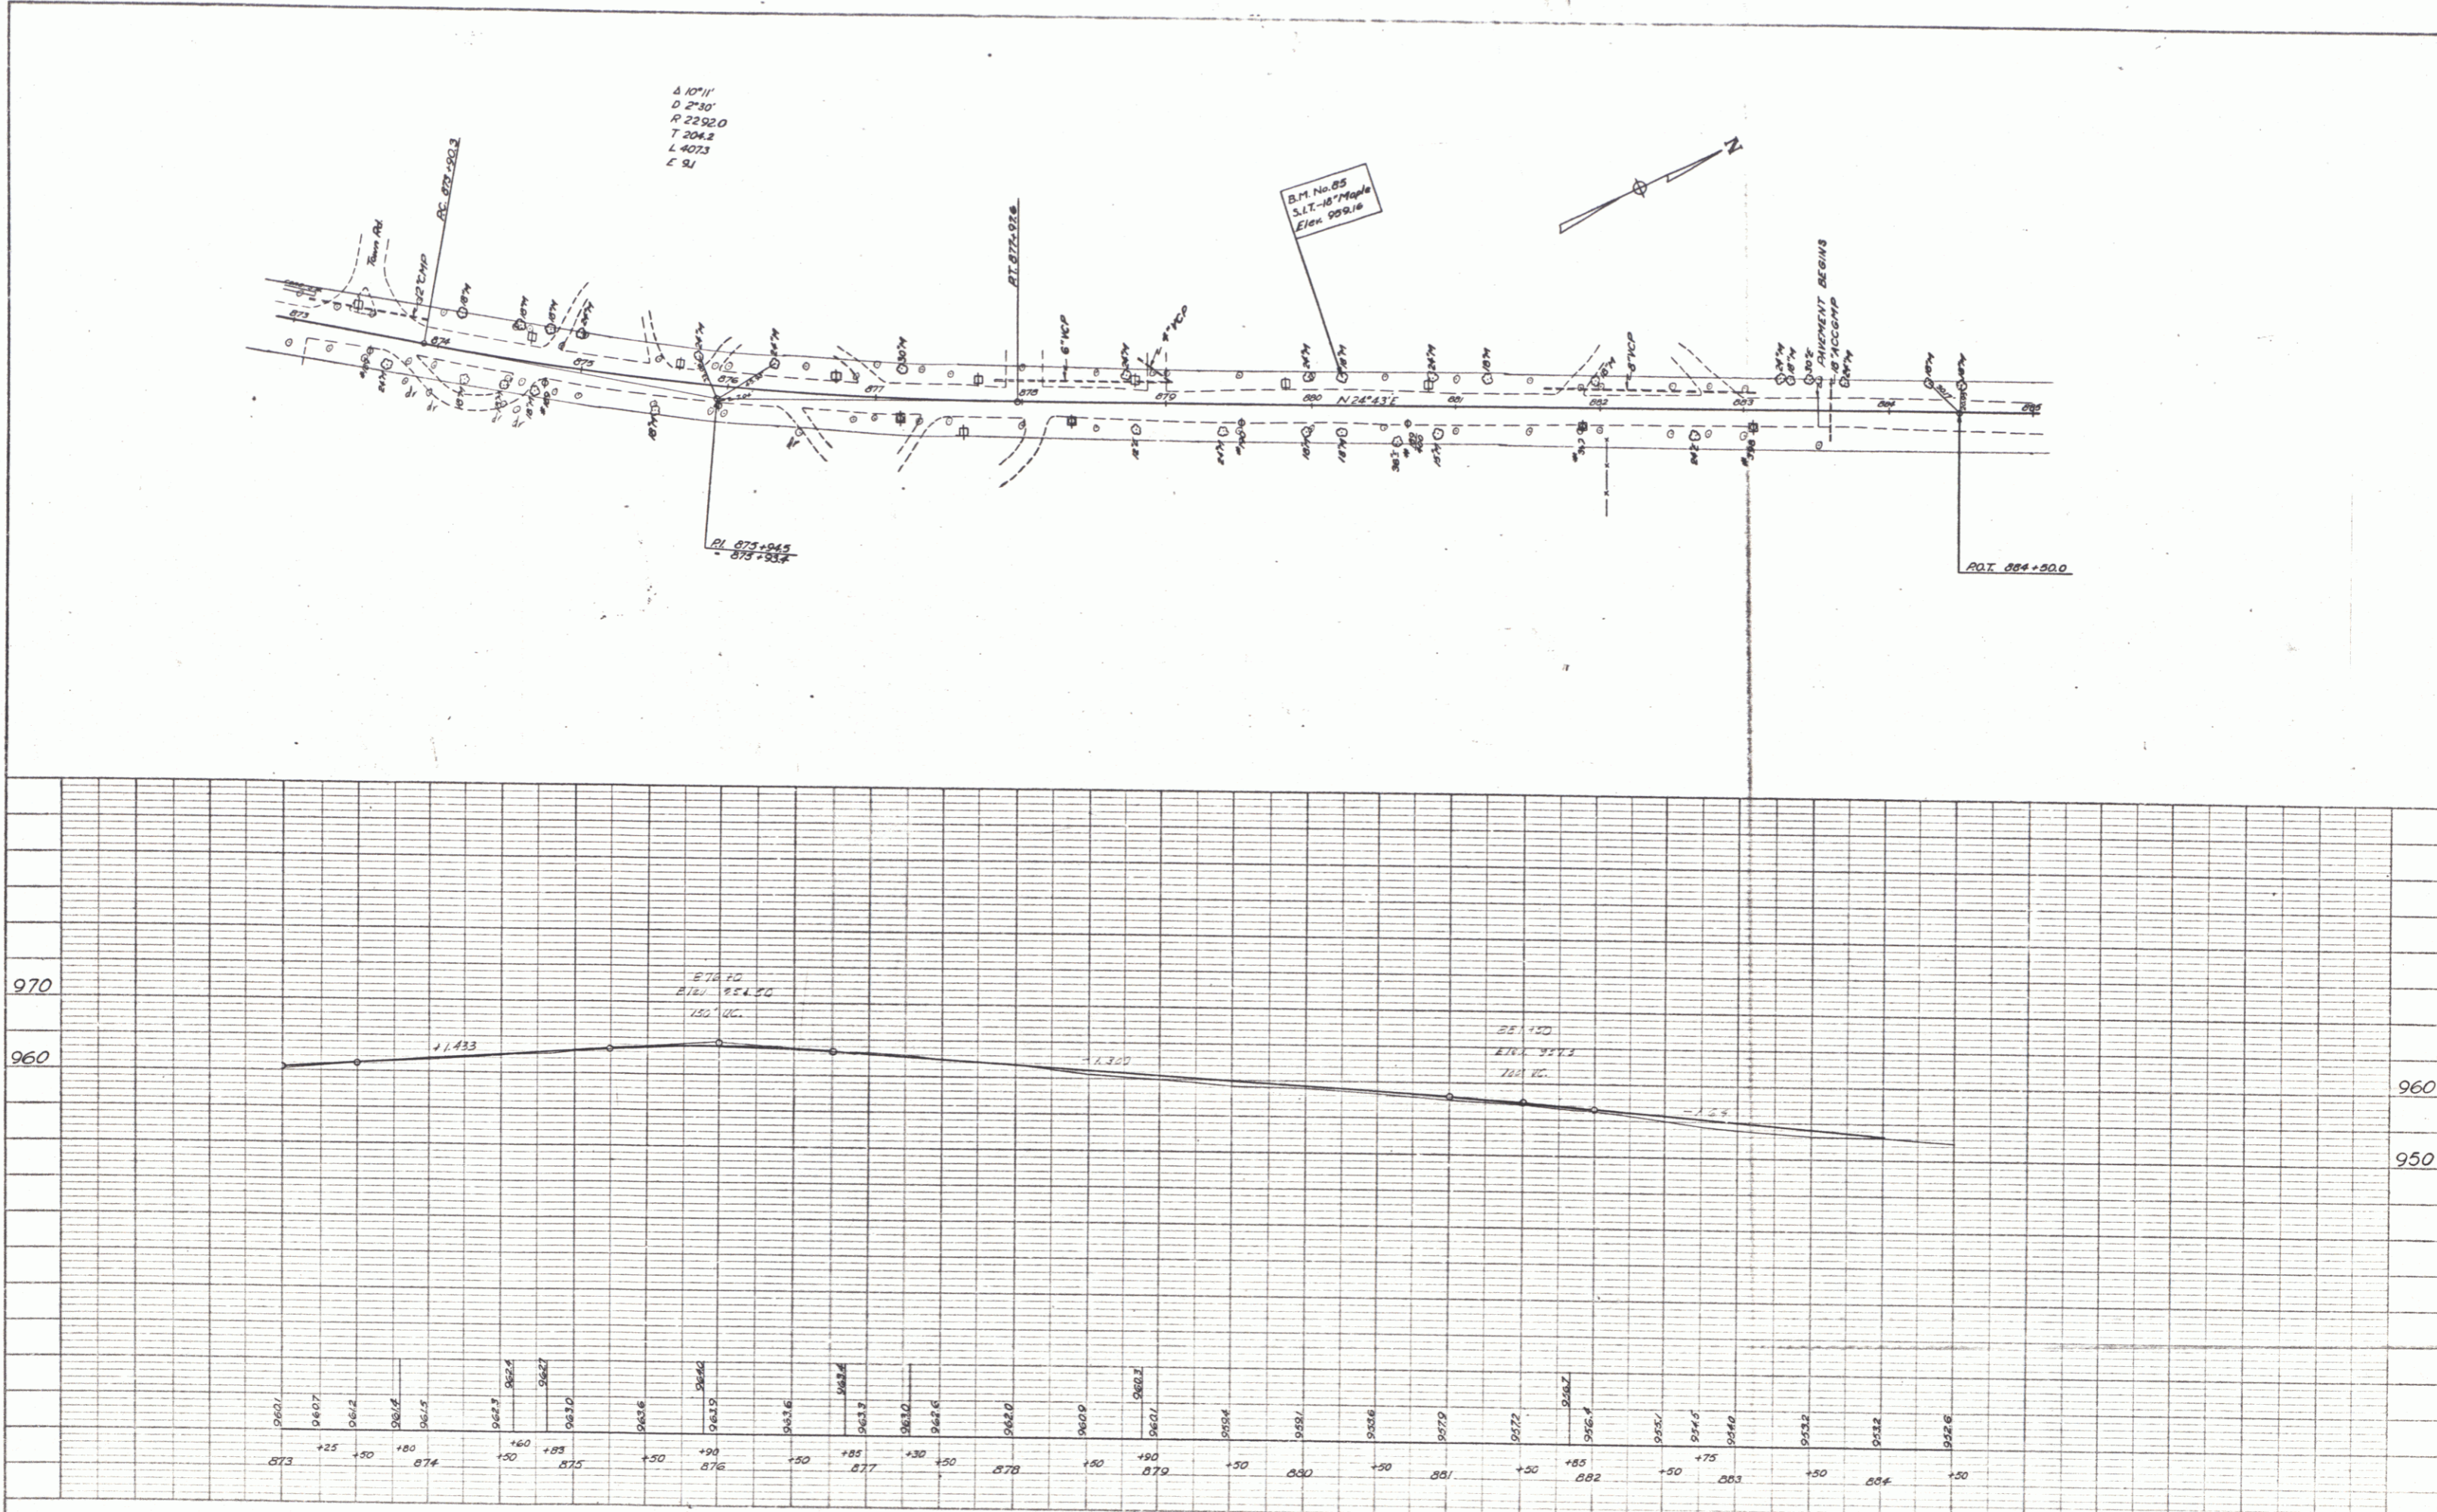


PLATE 1 - PLAN-PROFILE OF P. & K. E. STURRO
 RUFFEL & EYER CO., NEW YORK
 MADE IN U.S.A.

SHEET 14
 Craftsbury Albany 166 v

14