


Parcel	Kind of Instrument	Date of Instrument	Grantor	Grantee	Recorded	Remarks
A	Q.C.D.	12-2-35	Jesse Kimball	Staff	22 168	12-35

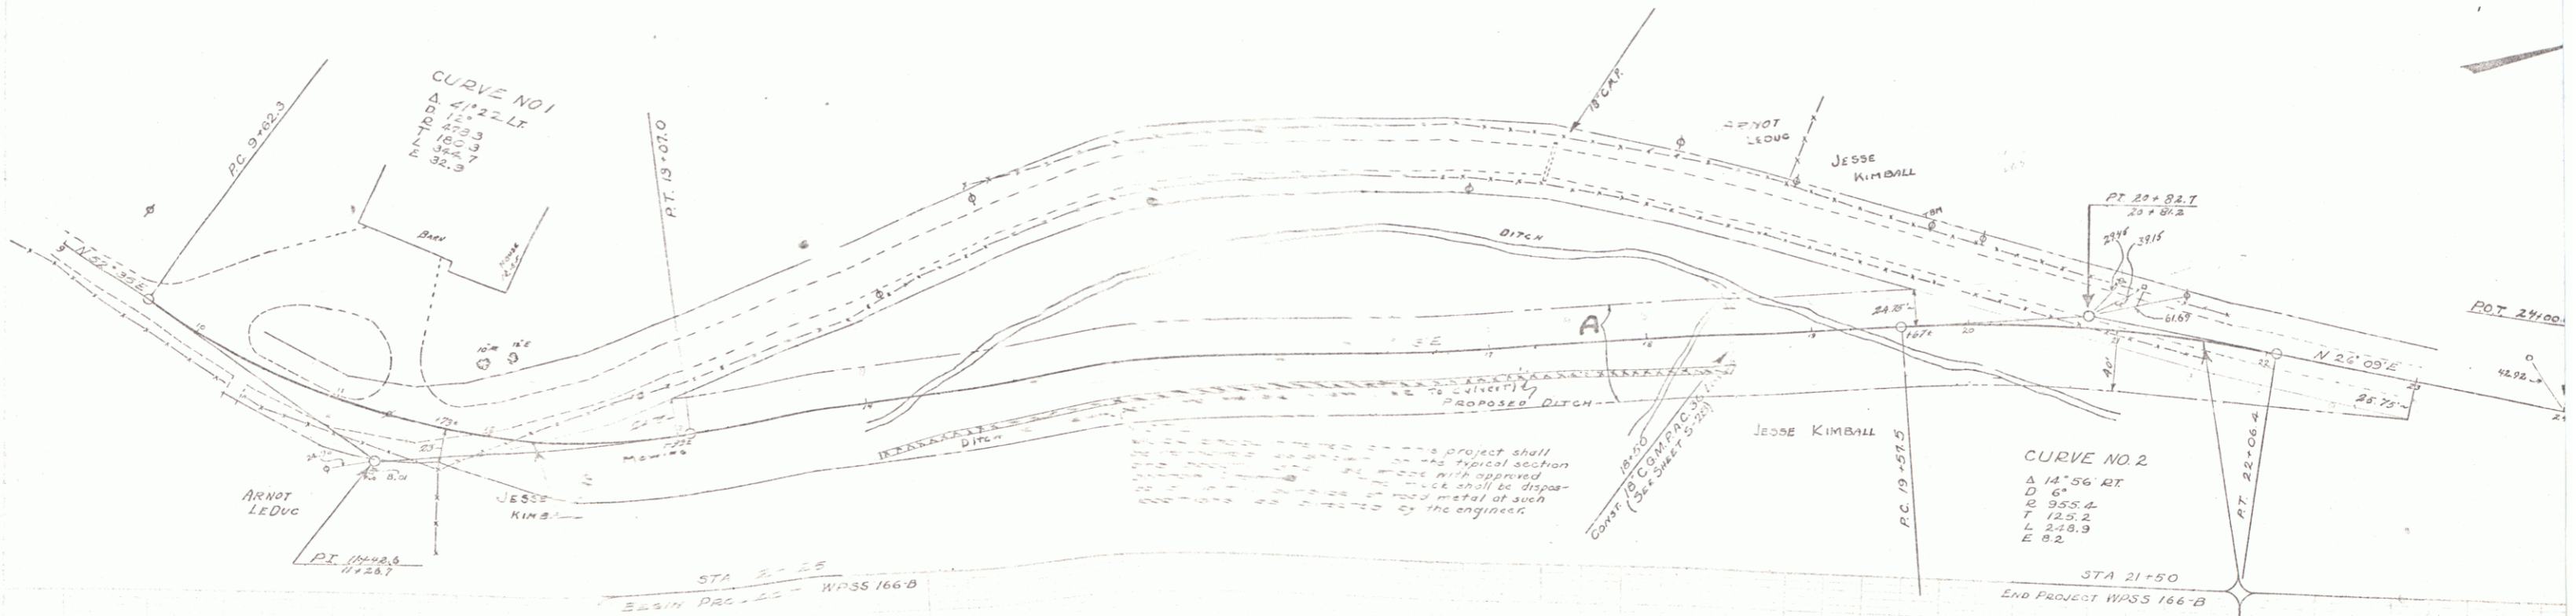

Station	Elevation	Station	Elevation	Station	Elevation
9	108.78	12	118.95	15	108.00
10	116.75	13	118.00	16	107.00
11	118.00	14	117.00	17	106.00
12	116.52	15	116.00	18	105.00
13	115.22	16	115.00	19	104.00
14	114.00	17	114.00	20	103.00
15	113.00	18	113.00	21	102.00
16	112.00	19	112.00	22	101.00
17	111.00	20	111.00	23	100.00

SHEET 5