


FED. ROAD DISTRICT NO.	STATE	PROJECT NO.	SHEET NO.	TOTAL SHEETS
1	VT	5-166(7)	1	48

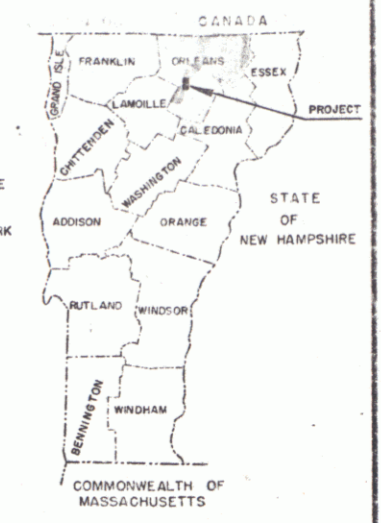

STATE OF VERMONT
DEPARTMENT OF HIGHWAYS

PROPOSED IMPROVEMENT

FEDERAL AID SECONDARY PROJECT

TOWN OF ALBANY *Pin # 00R772*

COUNTY OF ORLEANS
VERMONT ROUTE 14
ALBANY-IRASBURG ROAD

BEGINNING AT A POINT 4123.4 FT. SOUTHWEST OF THE IRASBURG-ALBANY TOWN LINE AND EXTENDING NORTHEASTERY 2601.4 FT.

LENGTH OF ROADWAY 2512.4 FT. = 0.475 MILE
LENGTH OF BRIDGE 250 FT. = 0.017 MILE

LENGTH OF PROJECT 2601.4 FT. = 0.492 MILE

PROJECT NAME & NUMBER	TYPE	PAVEMENT AREA
ALBANY - 5-166 (7)	RECORD PLANS	S.T.
MATERIALS		
REINFORCING STEEL - Vt. Struct. Steel Co.		
STRUCTURAL STEEL - Vt. Struct. Steel Co.		
R.C.P. - Vt. Concrete Pipe Corp.		
ACCOMP. - New England Metal Cut. Co.		
CABLE FOR GUARD RAIL - Am. Steel & Wire Co.		
GUARD RAIL POINT		
Grass-Paint-Bradly Lab. - Brattleboro, Vt.		
and Reynolds & Sons-Barre, Vt.		
CONTRACT - JUNE 24-1955		
CONTRACT - AUG. 10-1955		
CONTRACT - OCT. 10-1955		
CONTRACT - FEB. 2-1956		
CONTRACT - APR. 10-1956		
CONTRACT - JUN. 10-1956		
CONTRACT - AUG. 10-1956		
CONTRACT - OCT. 10-1956		
CONTRACT - DEC. 10-1956		
CONTRACT - FEB. 10-1957		
CONTRACT - APR. 10-1957		
CONTRACT - JUN. 10-1957		
CONTRACT - AUG. 10-1957		
CONTRACT - OCT. 10-1957		
CONTRACT - DEC. 10-1957		
CONTRACT - FEB. 10-1958		
CONTRACT - APR. 10-1958		
CONTRACT - JUN. 10-1958		
CONTRACT - AUG. 10-1958		
CONTRACT - OCT. 10-1958		
CONTRACT - DEC. 10-1958		
CONTRACT - FEB. 10-1959		
CONTRACT - APR. 10-1959		
CONTRACT - JUN. 10-1959		
CONTRACT - AUG. 10-1959		
CONTRACT - OCT. 10-1959		
CONTRACT - DEC. 10-1959		
CONTRACT - FEB. 10-1960		
CONTRACT - APR. 10-1960		
CONTRACT - JUN. 10-1960		
CONTRACT - AUG. 10-1960		
CONTRACT - OCT. 10-1960		
CONTRACT - DEC. 10-1960		
CONTRACT - FEB. 10-1961		
CONTRACT - APR. 10-1961		
CONTRACT - JUN. 10-1961		
CONTRACT - AUG. 10-1961		
CONTRACT - OCT. 10-1961		
CONTRACT - DEC. 10-1961		
CONTRACT - FEB. 10-1962		
CONTRACT - APR. 10-1962		
CONTRACT - JUN. 10-1962		
CONTRACT - AUG. 10-1962		
CONTRACT - OCT. 10-1962		
CONTRACT - DEC. 10-1962		
CONTRACT - FEB. 10-1963		
CONTRACT - APR. 10-1963		
CONTRACT - JUN. 10-1963		
CONTRACT - AUG. 10-1963		
CONTRACT - OCT. 10-1963		
CONTRACT - DEC. 10-1963		
CONTRACT - FEB. 10-1964		
CONTRACT - APR. 10-1964		
CONTRACT - JUN. 10-1964		
CONTRACT - AUG. 10-1964		
CONTRACT - OCT. 10-1964		
CONTRACT - DEC. 10-1964		
CONTRACT - FEB. 10-1965		
CONTRACT - APR. 10-1965		
CONTRACT - OCT. 10-2006		
CONTRACT - DEC. 10-2006		
CONTRACT - FEB. 10-2007		
CONTRACT - APR. 10-2007		
CONTRACT - JUN. 10-2007		
CONTRACT - AUG. 10-2007		
CONTRACT - OCT. 10-200		