


LT	RT
1101+81	1098+00
1102+31	1100+00
1104+00	1104+00
1104+00	

NON-GOVT PARTICIPATION
 Stas. 1100+40 and 1104+00.
 install Sleeves for Water Pipe
 across roadway. Sleeves to be
 furnished by Property Owner

THREE CABLE GUARD RAIL w/Steel Posts
 1107+26 - 1108+06 LT V 1101+46 - 1103+20 RT V
 1108+95 - 1109+91 LT V 1106+30 - 1108+06 RT V
 1108+95 - 1109+91 RT V
 Barricading Old Bridge Approach

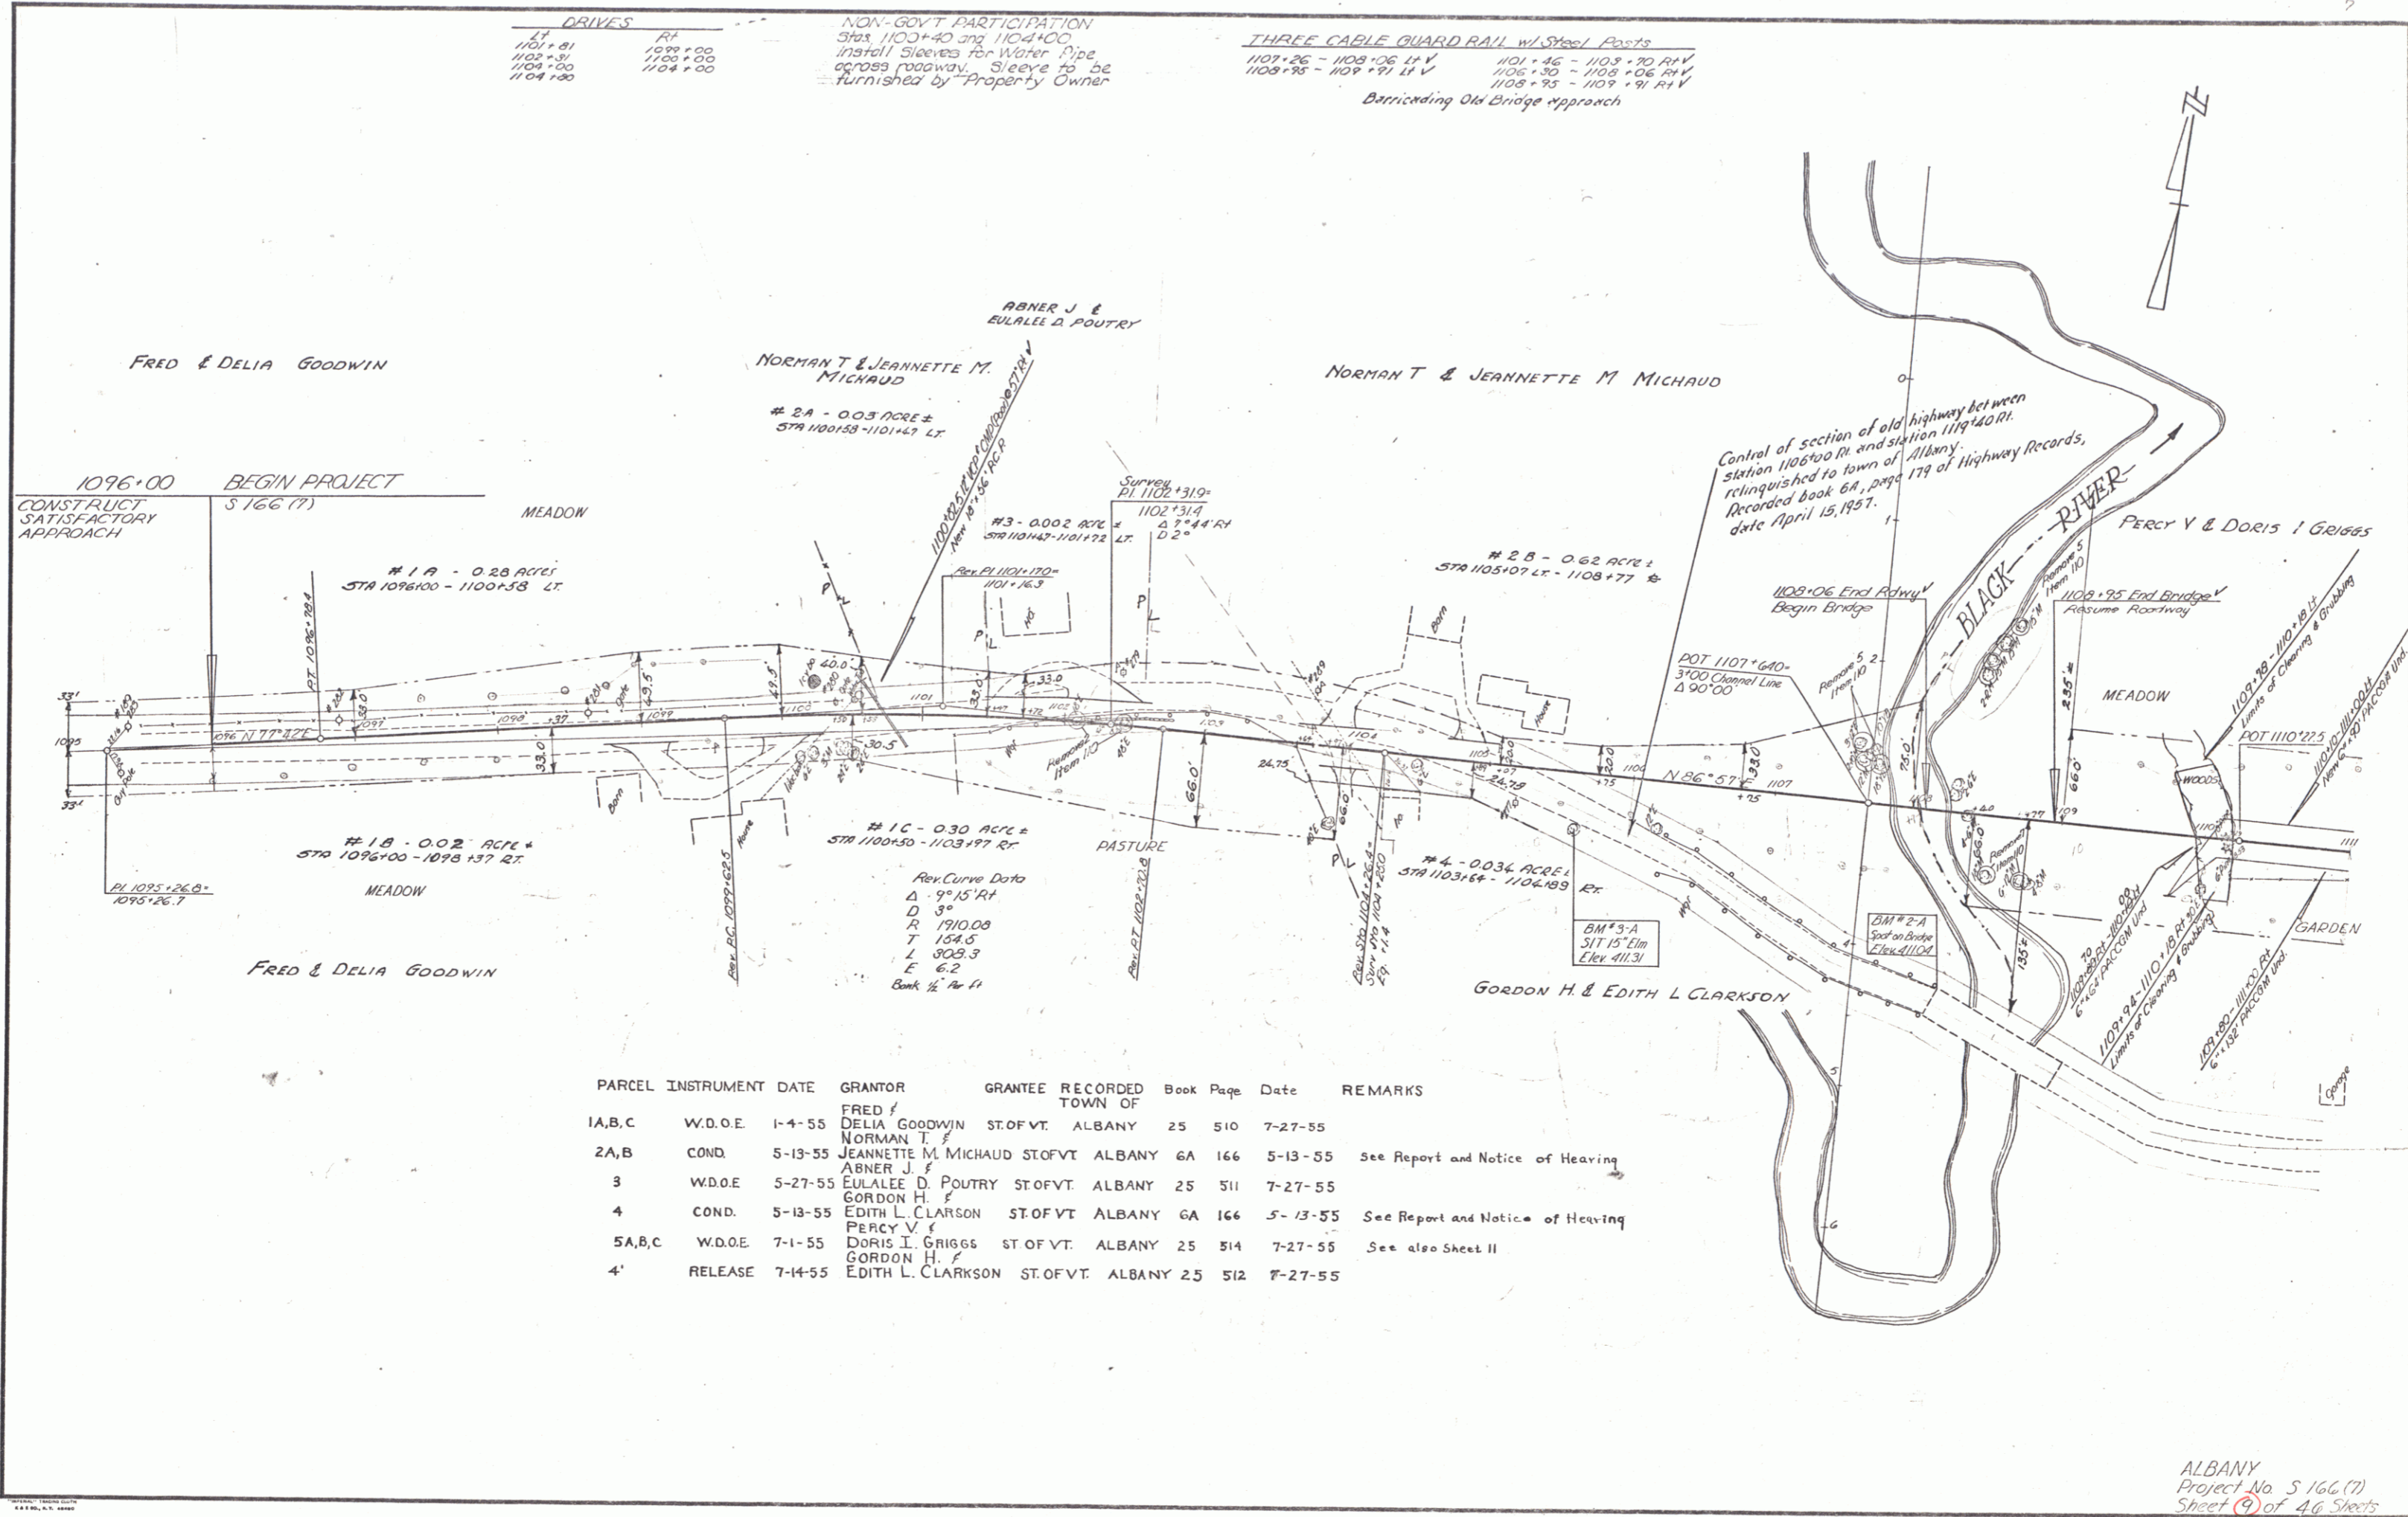

PARCEL	INSTRUMENT	DATE	GRANTOR	GRANTEE	RECORDED TOWN OF	Book	Page	Date	REMARKS
1A,B,C	W.D.O.E.	1-4-55	FRED & DELIA GOODWIN	ST. OF VT.	ALBANY	25	510	7-27-55	
2A,B	COND.	5-13-55	JEANNETTE M. MICHAUD	ST. OF VT.	ALBANY	6A	166	5-13-55	See Report and Notice of Hearing
3	W.D.O.E.	5-27-55	EULALEE D. POUTRY	ST. OF VT.	ALBANY	25	511	7-27-55	
4	COND.	5-13-55	EDITH L. CLARKSON	ST. OF VT.	ALBANY	6A	166	5-13-55	See Report and Notice of Hearing
5A,B,C	W.D.O.E.	7-1-55	PERCY V & DORIS I. GRIGGS	ST. OF VT.	ALBANY	25	514	7-27-55	See also Sheet II
4'	RELEASE	7-14-55	EDITH L. CLARKSON	ST. OF VT.	ALBANY	25	512	7-27-55	

ALBANY
 Project No. 5 166 (7)
 Sheet (9) of 46 Sheets