



PLAN  
 DATE 1-32  
 DRAWN BY Spillings Palmer  
 CHECKED BY [Signature]  
 TITLE ALBANY-TRASBURG  
 SHEET NO. 63

PROFILE  
 DATE 1-32  
 DRAWN BY Spillings Palmer  
 CHECKED BY [Signature]  
 TITLE ALBANY-TRASBURG  
 SHEET NO. 63

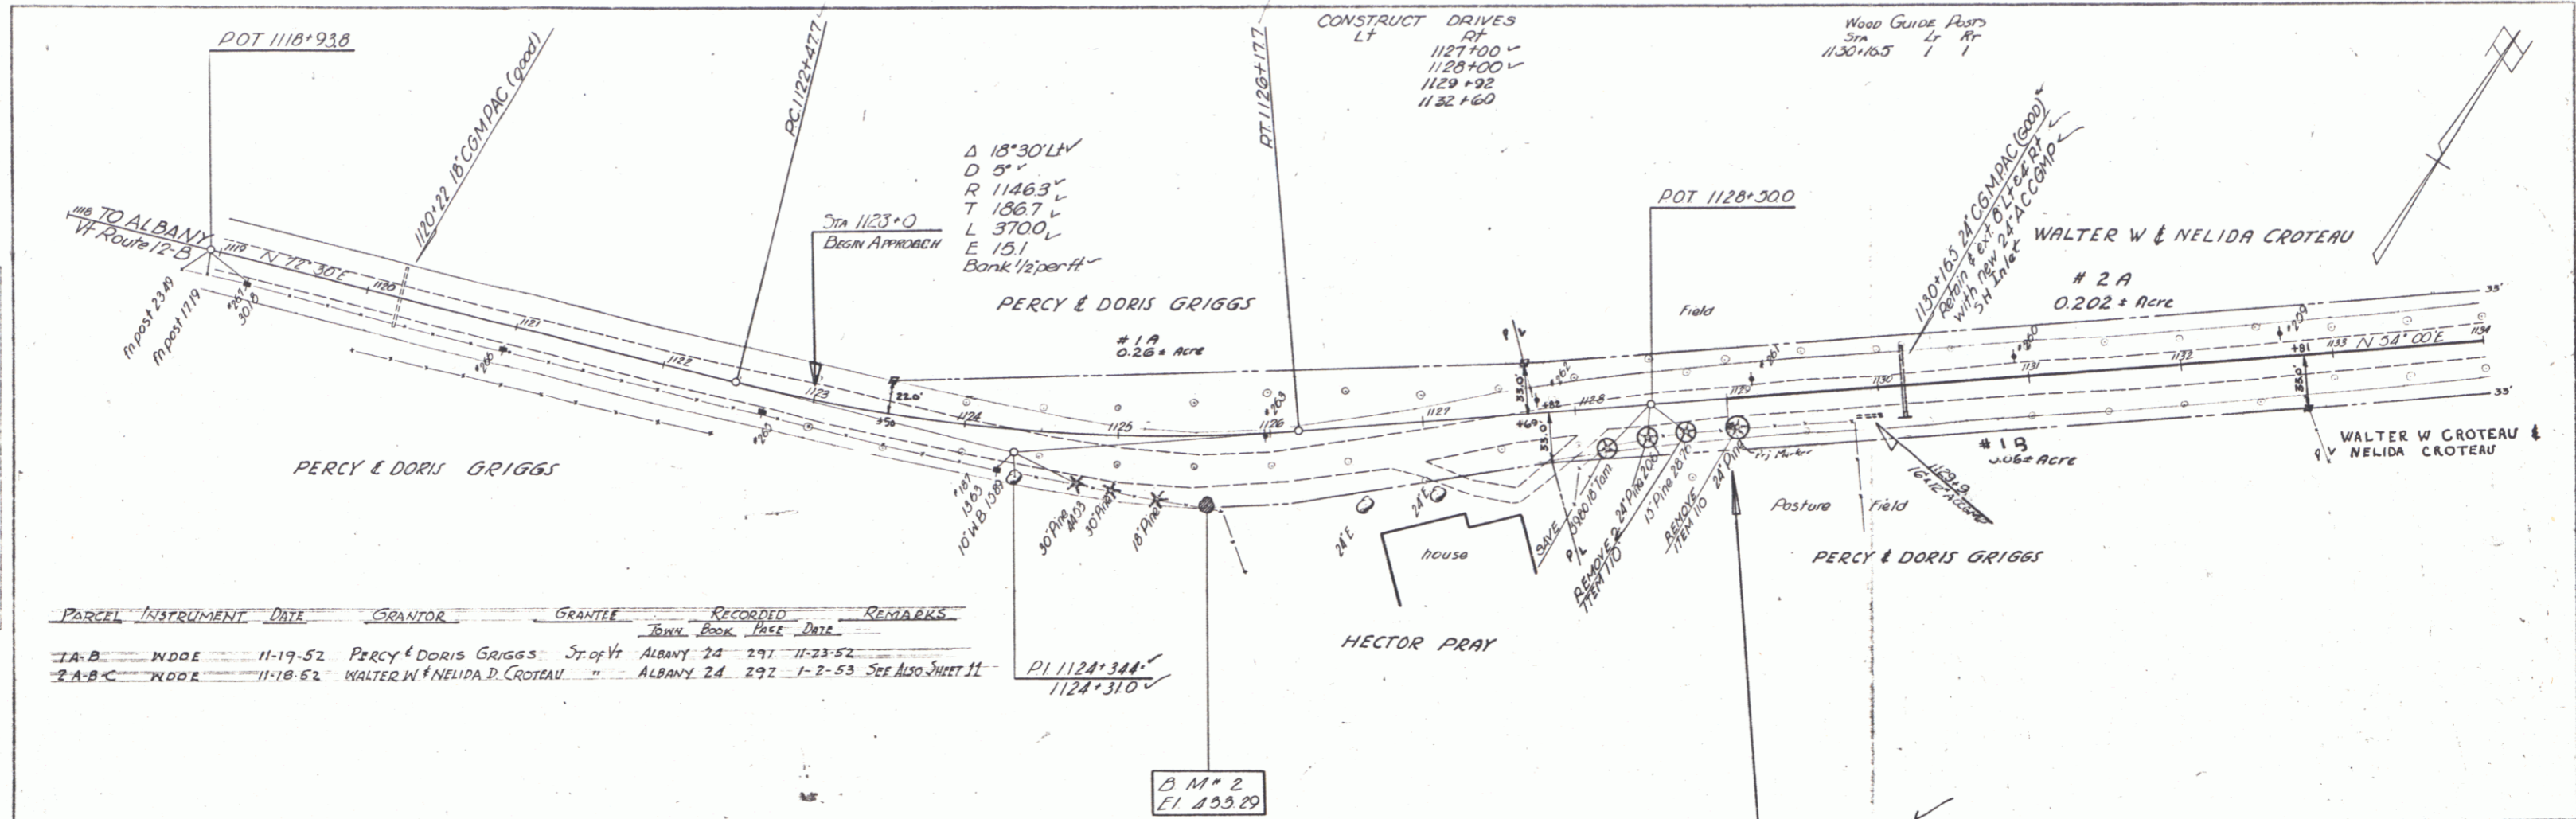

PARCEL	INSTRUMENT	DATE	GRANTOR	GRANTEE	RECORDED	REMARKS
					Book Page	
1A-B	WDOE	11-19-52	Percy & Doris Griggs	St of Vt	ALBANY 24 291	11-23-52
2A-B	WDOE	11-18-52	WALTER W & NELIDA D. CROTEAU	"	ALBANY 24 292	1-2-53 See Also Sheet 11

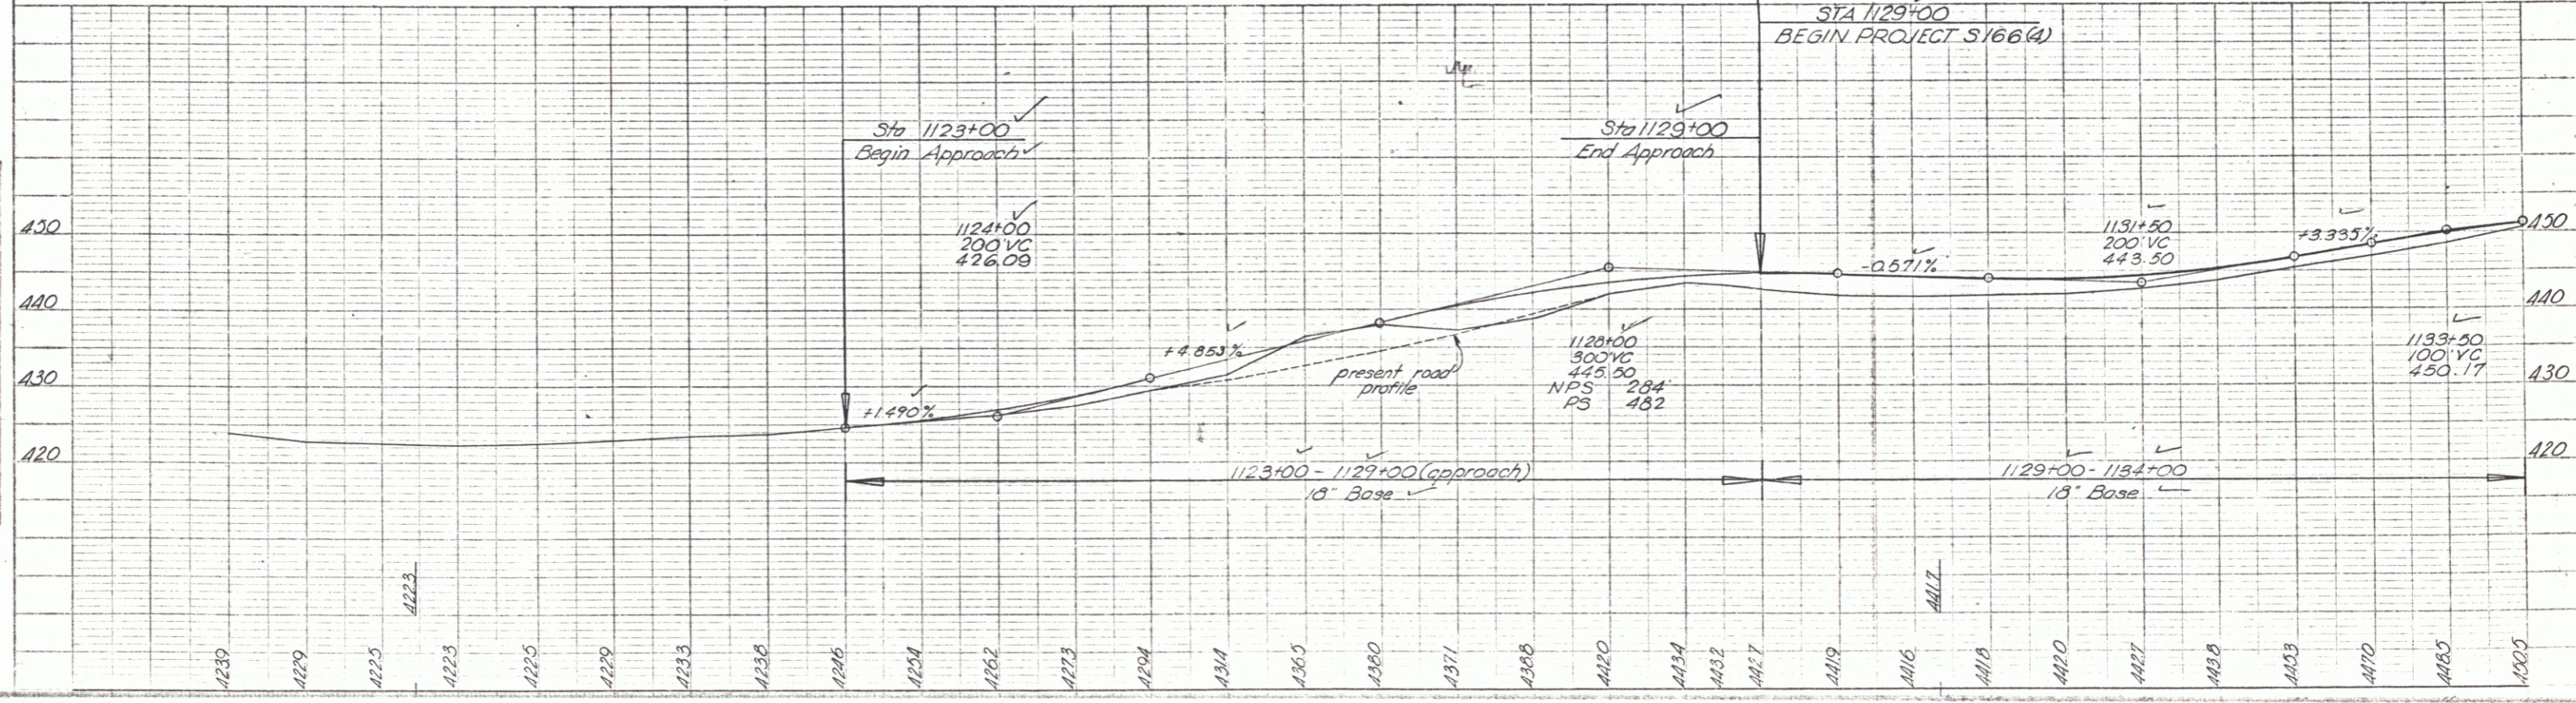

1118 B.M. 1 S1R 13' Pine 25' Ft. Rt Sta 1116+93 Elev 436.10  
 1120 B.M. 2 S1R 24' Elm 46' Ft. Rt Sta 1125+09 Elev 493.29

ALBANY-TRASBURG  
 Project S No 166(4)  
 Sheet 63 of 63