
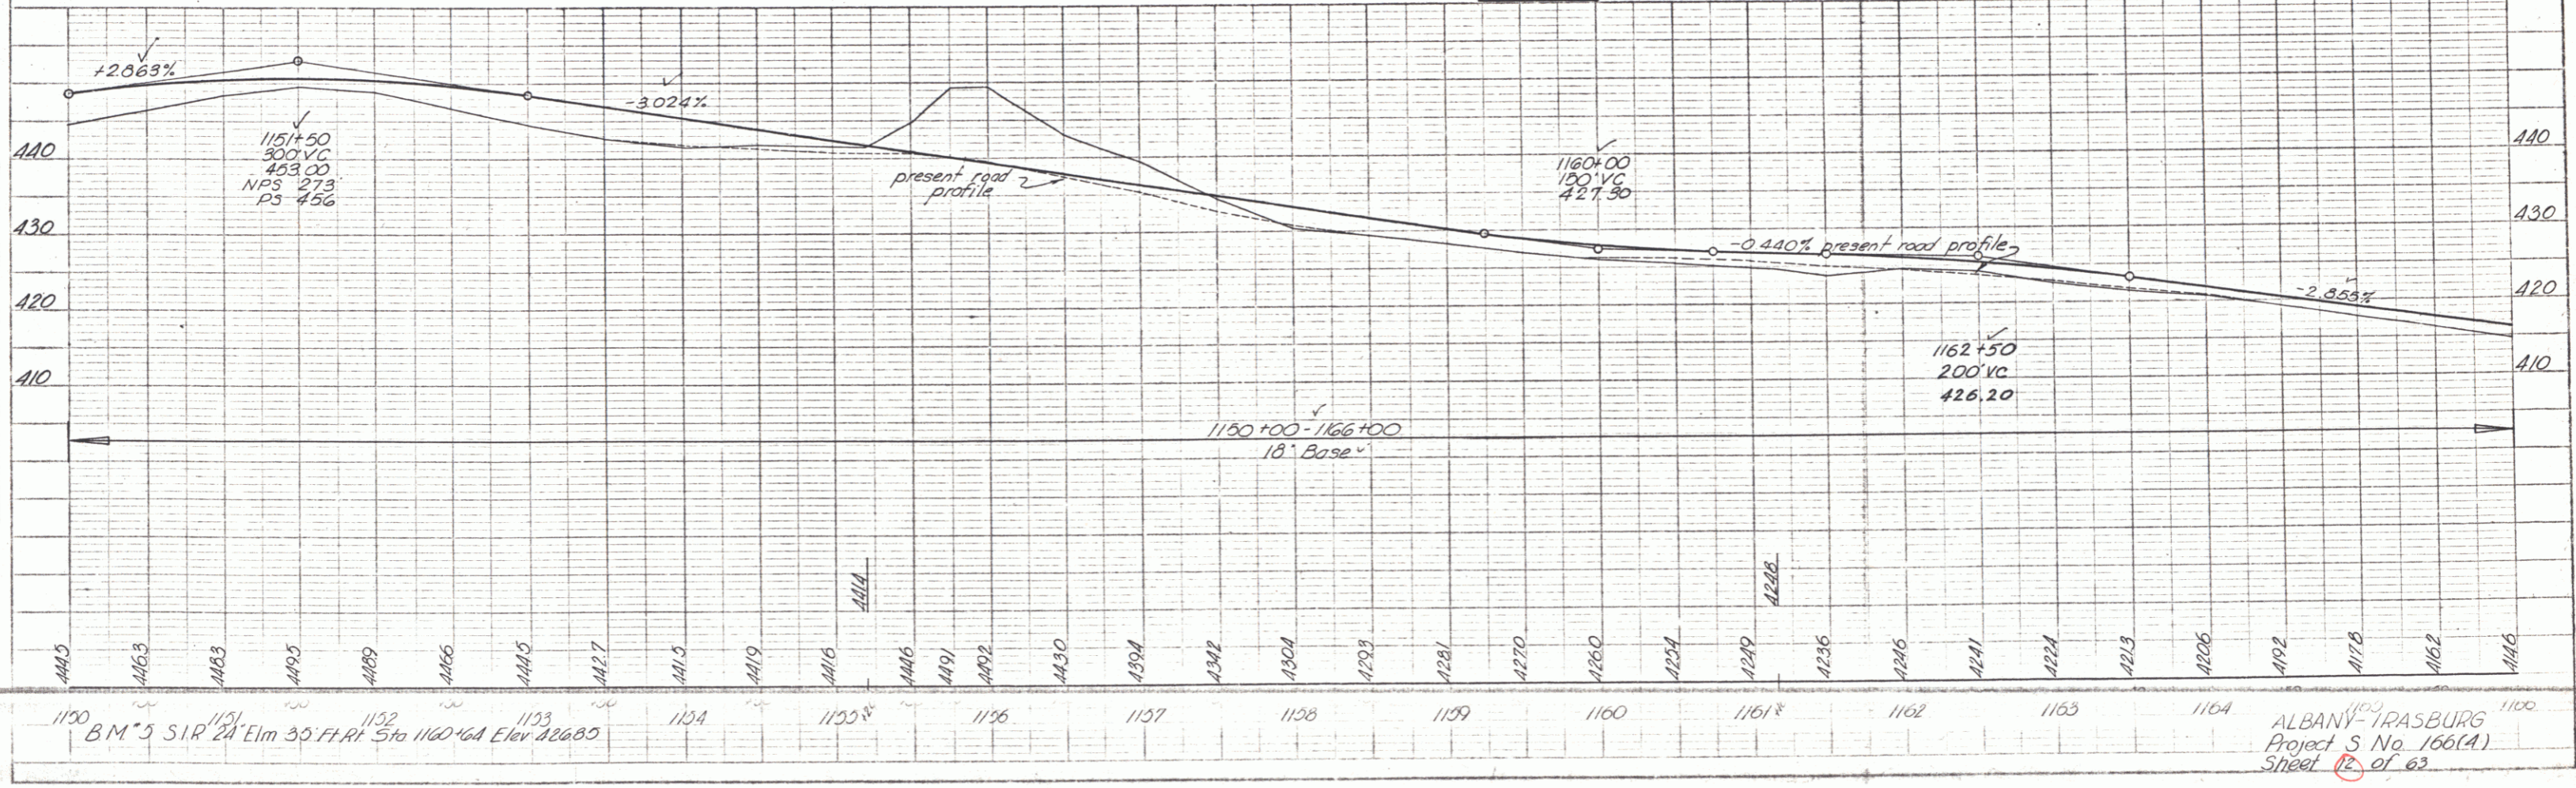


Parcel	Instr	Date	Grantor	Grantee	Recorded	Book	Page	Date	Remarks
#3A,B	W.D.O.E.	11-18-52	Clare C. & Barbara G. Phillips	St. of Vt.	Irishburg	22	281	11-21-52	See Sheet 11
#4	W.D.O.E.	11-18-52	Roy C. & Ruby Phillips	St. of Vt.	"	22	285	11-21-52	See Sheet 11
#5A,B,C,D	W.D.O.E.	11-18-52	Ernest & Doria Houle	St. of Vt.	"	22	279	11-21-52	See Sheet 13

Wood Guide Posts
Sta 1154+25 L 1 R 1

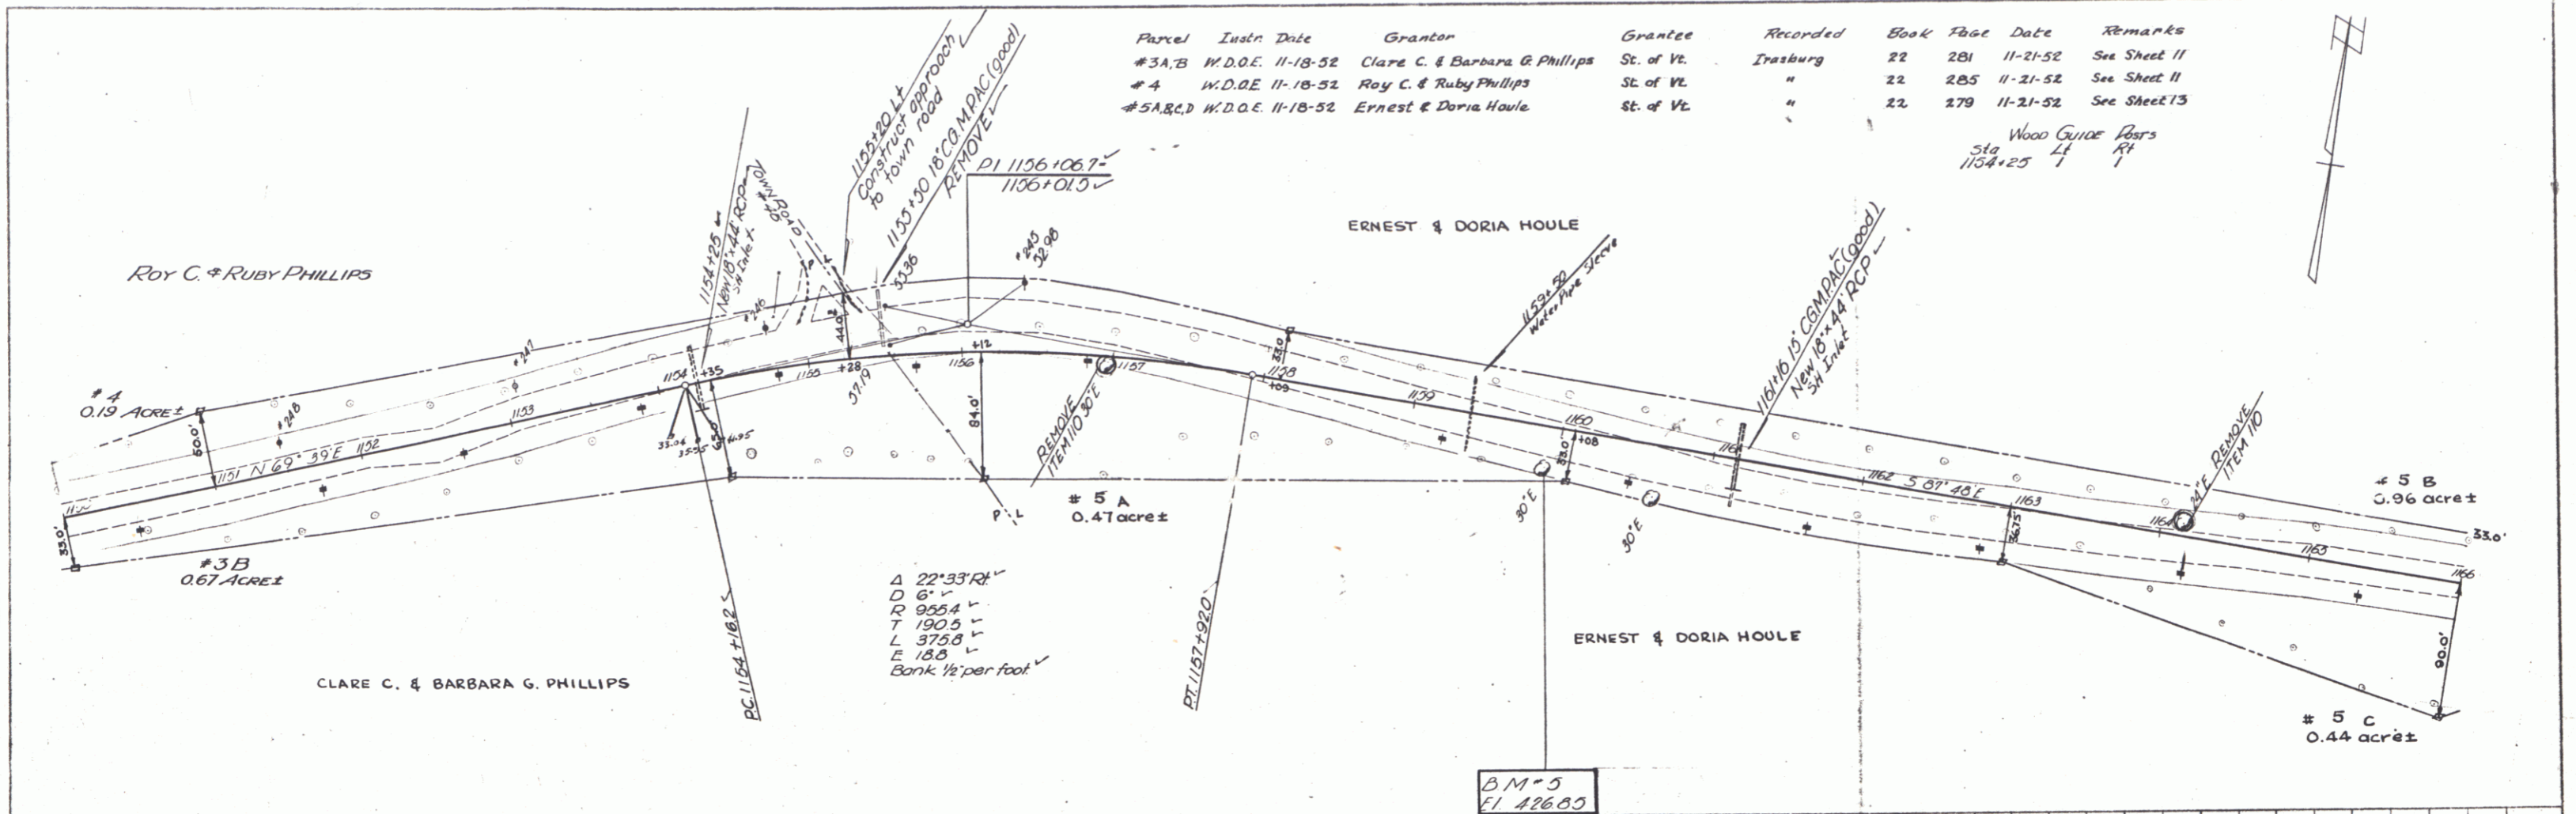

PLAN
Scale 1" = 30'
1-28

PROFILE
Scale 1" = 30'
1-28

ALBANY-IRASBURG
Project S No 166(A)
Sheet 17 of 63