



PLAN
 DATE: 1-31-52
 DRAWN BY: S. Palmer
 CHECKED BY: S. Palmer

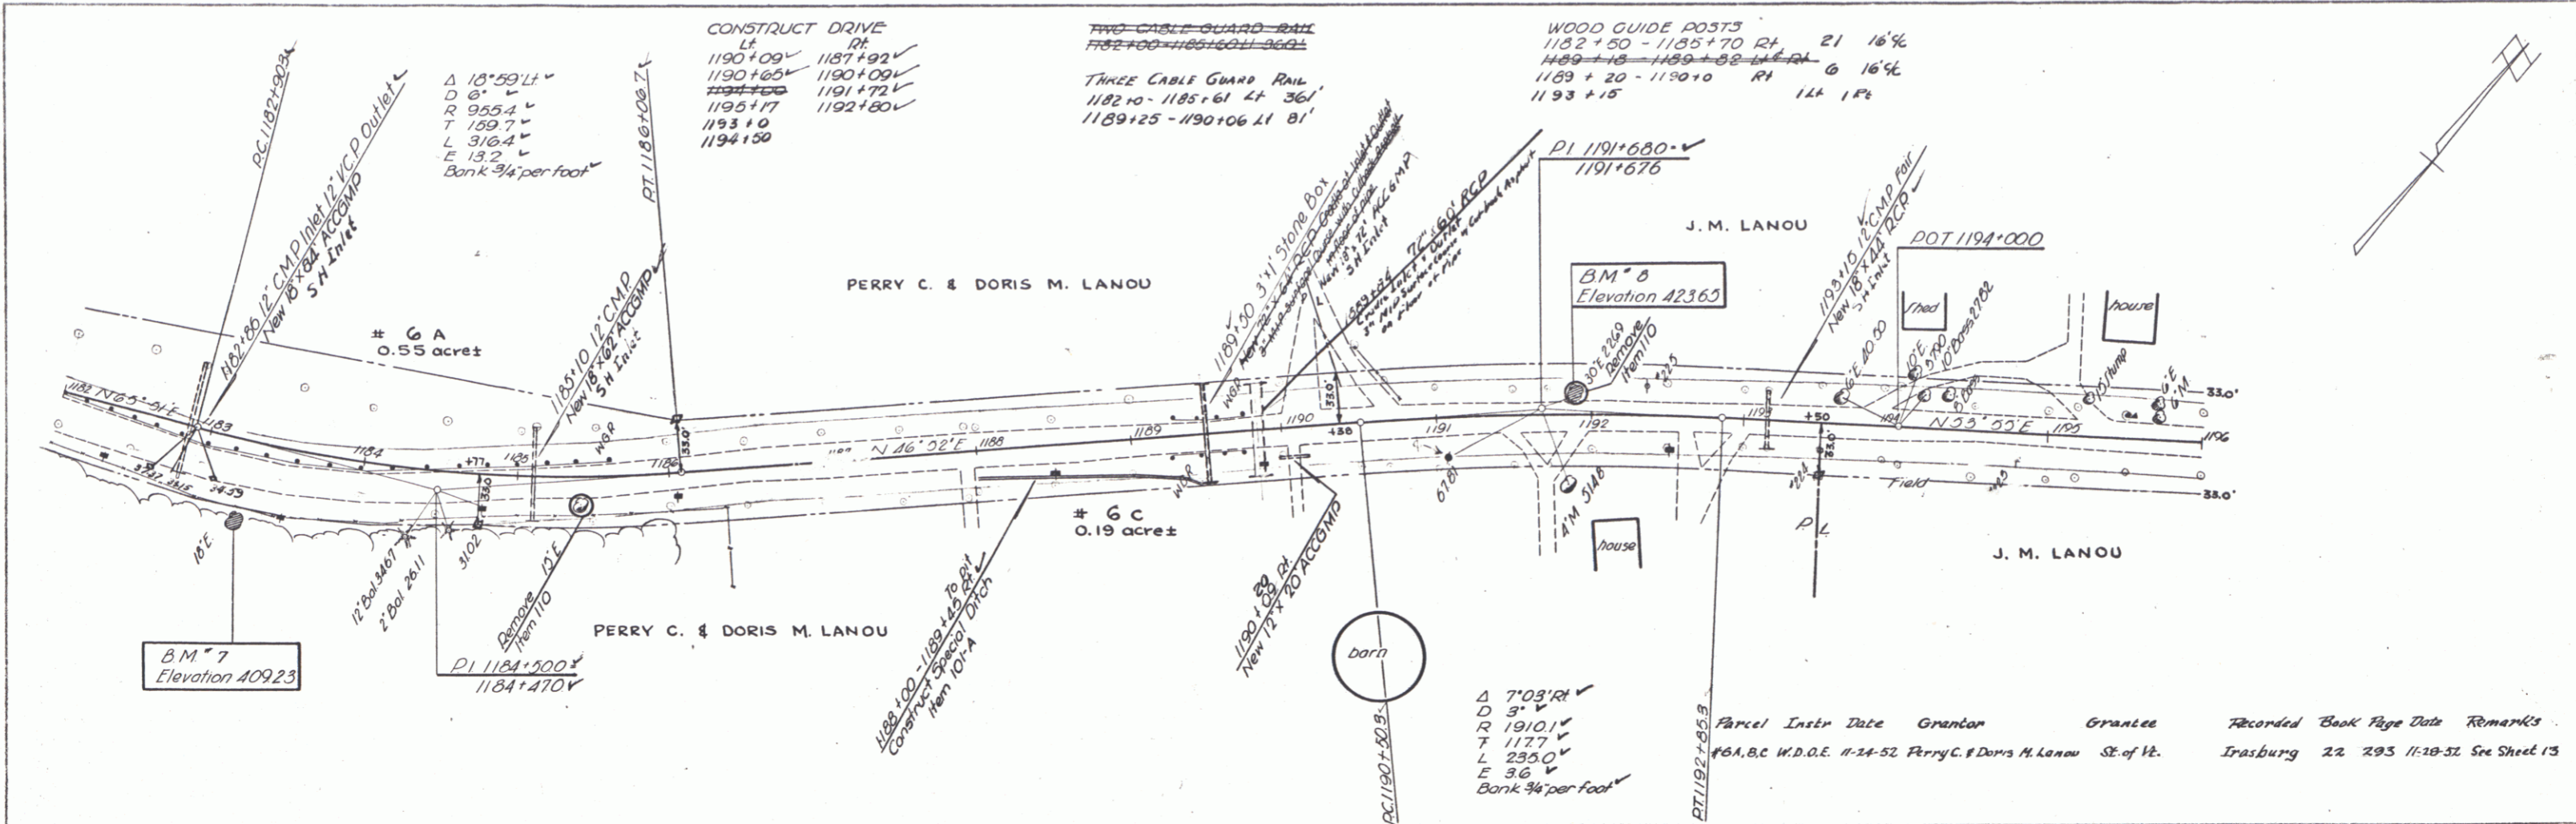

PROFILE
 DATE: 1-31-52
 DRAWN BY: S. Palmer
 CHECKED BY: S. Palmer

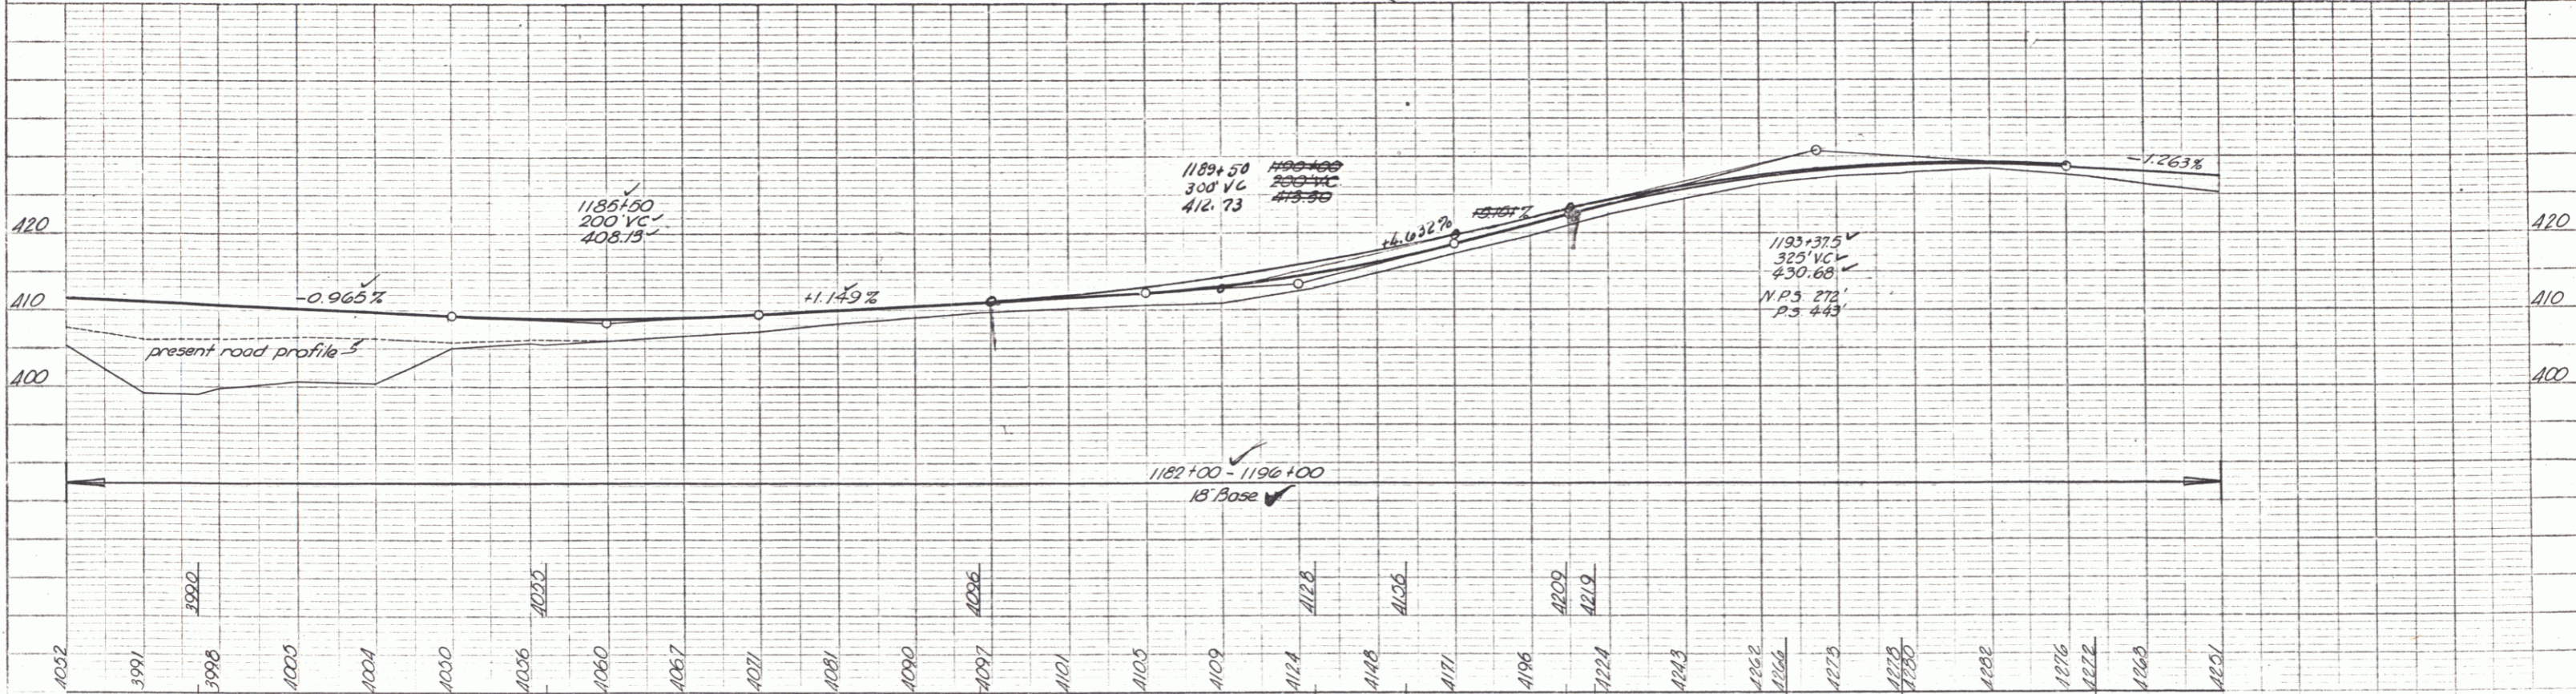

1182 1183 1184 1185 1186 1187 1188 1189 1190 1191 1192 1193 1194 1195 1196

BM #7 54' Lt. Sta. 1183+28 S.I.R. 18" Elm Elevation 409.23
 B.M. #8 13' Lt. Sta. 1191+90 S.I.R. 30" Elm Elevation 423.65

ALBANY-IRASBURG
 Project 5, No. 166(A)
 Sheet 2 of 63