



PLAN
 DRAWN BY: J. M. Lanou
 CHECKED BY: J. M. Lanou
 DATE: 11-21-52
 PROJECT: 1084 Project 5 No. 16 (H.A.)
 SHEET: 63 of 63

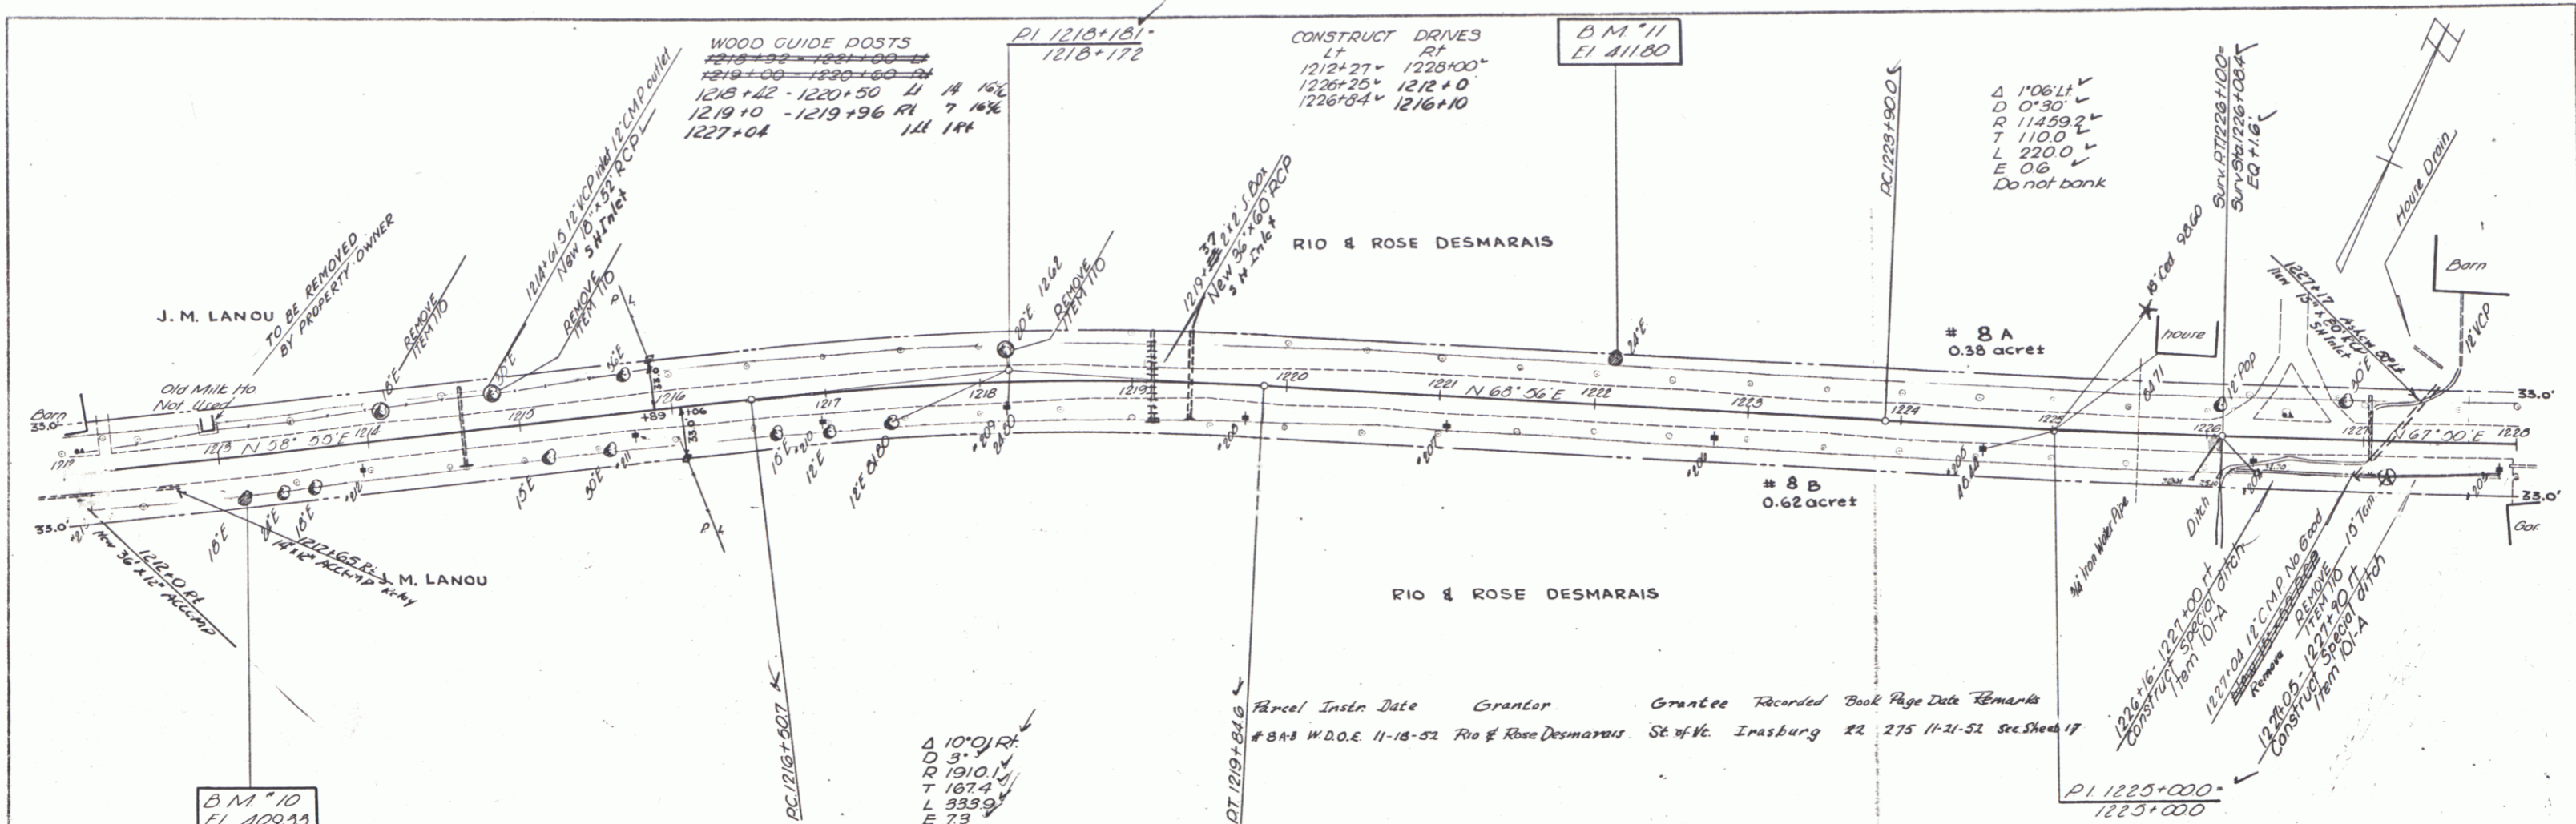

PROFILE
 DRAWN BY: J. M. Lanou
 CHECKED BY: J. M. Lanou
 DATE: 11-21-52
 PROJECT: 1084 Project 5 No. 16 (H.A.)
 SHEET: 63 of 63

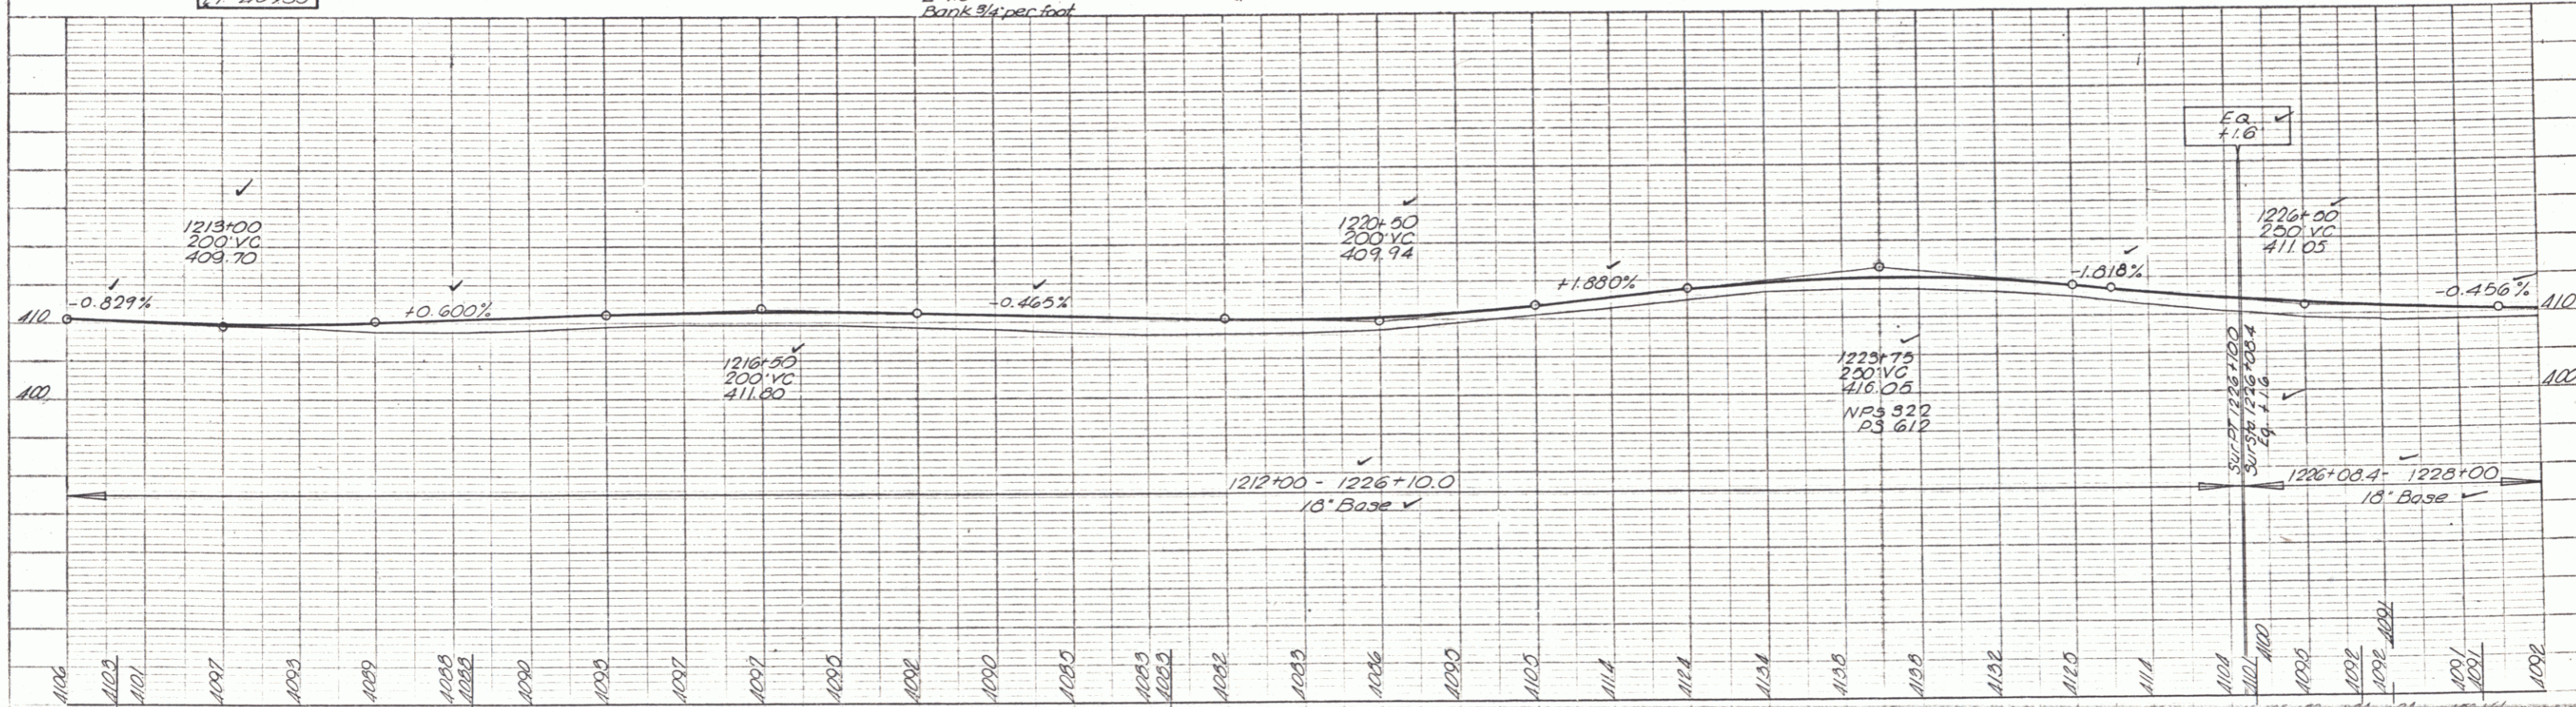

1212 B.M. 10 20' F.H.L. Sta 1213+14 S.I.R. 15' Elm. Elevation 109.55
 1215 B.M. 11 31' F.H.L. Sta 1222+12 S.I.R. 24' Elm. Elevation 111.80

1216 1217 1218 1219 1220 1221 1222 1223 1224 1225 1226 1227 1228

1084 Project 5 No. 16 (H.A.)
 63 of 63