
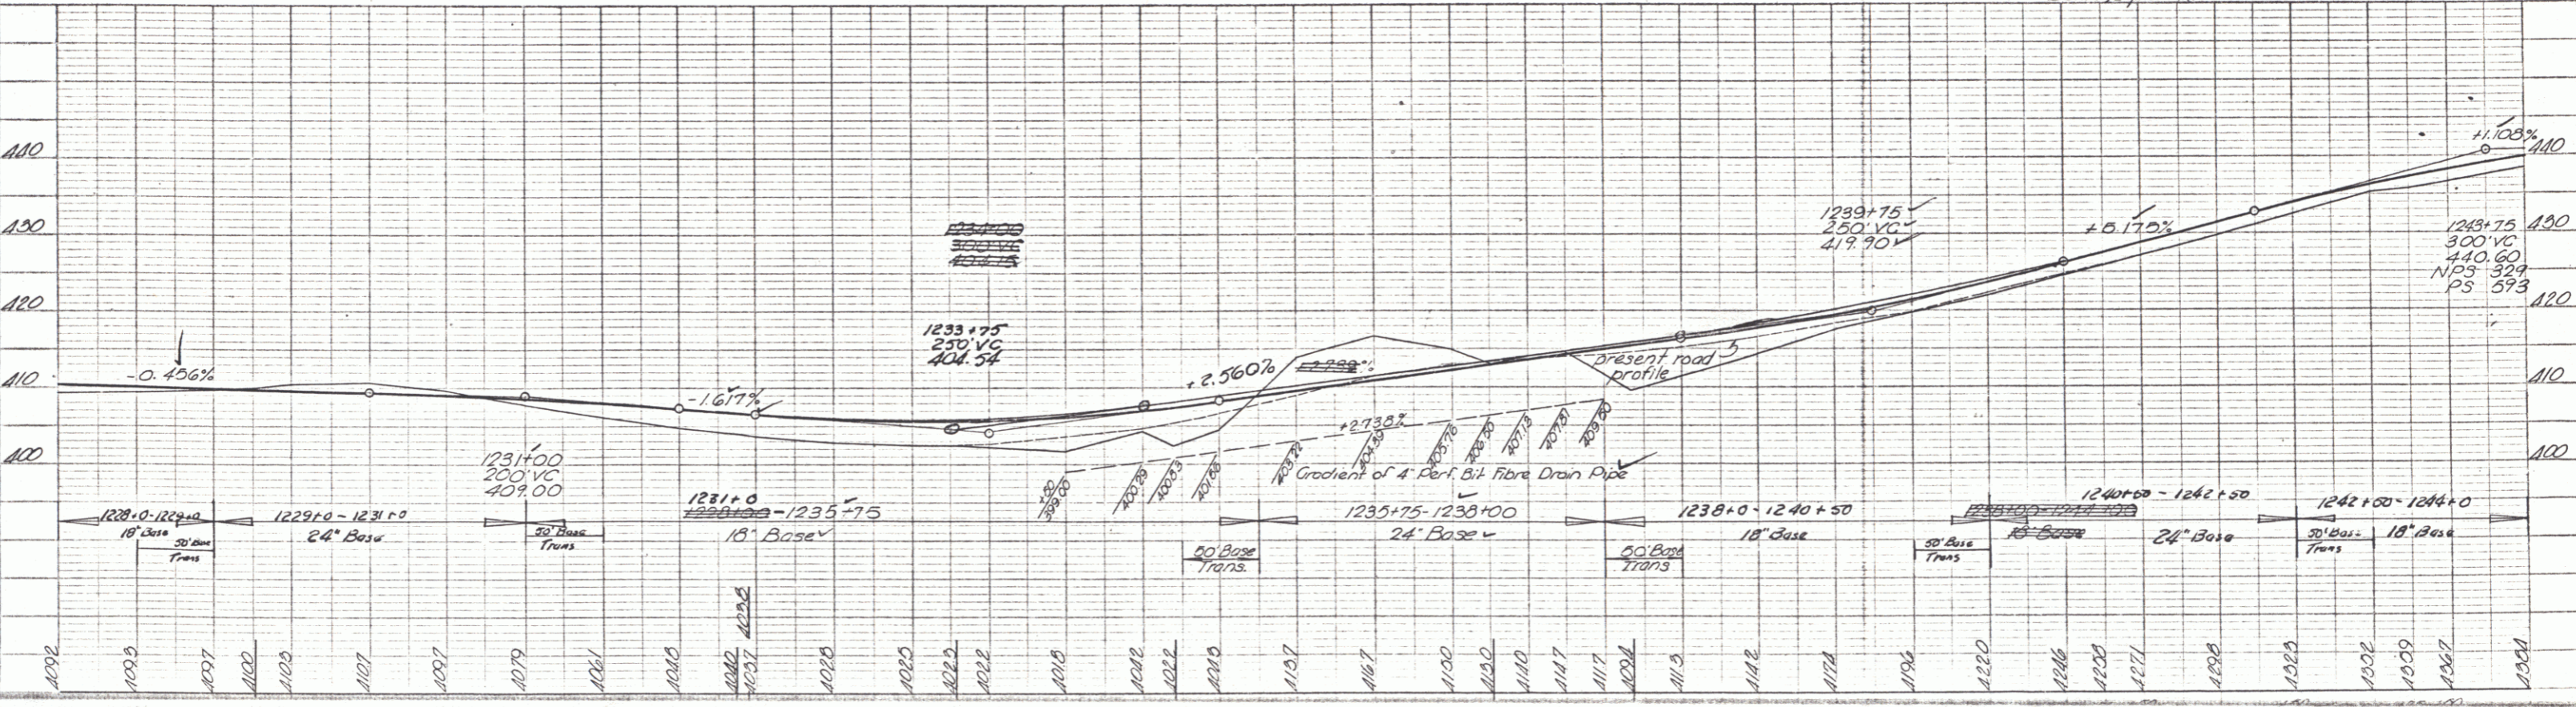


Parcel	Instn	Date	Grantee	Grantee	Recorded	Book	Page	Title	Remarks
#9	W.O.E.	11-24-52	Patrick H. Albert & Lynn Murphy	St. of Pt.	Inasburg	22	315	1-17-53	

CONSTRUCT DRIVES		WOOD GUIDE POSTS	
LT	RT	LT	RT
1228+50		1232+04	1233+96
1229+26		1232+00	1232+00
1239+00		1232+50	1233+50
1243+15		1233+78	1234+00
		1234+50	1238+18
		1238+00	1238+00

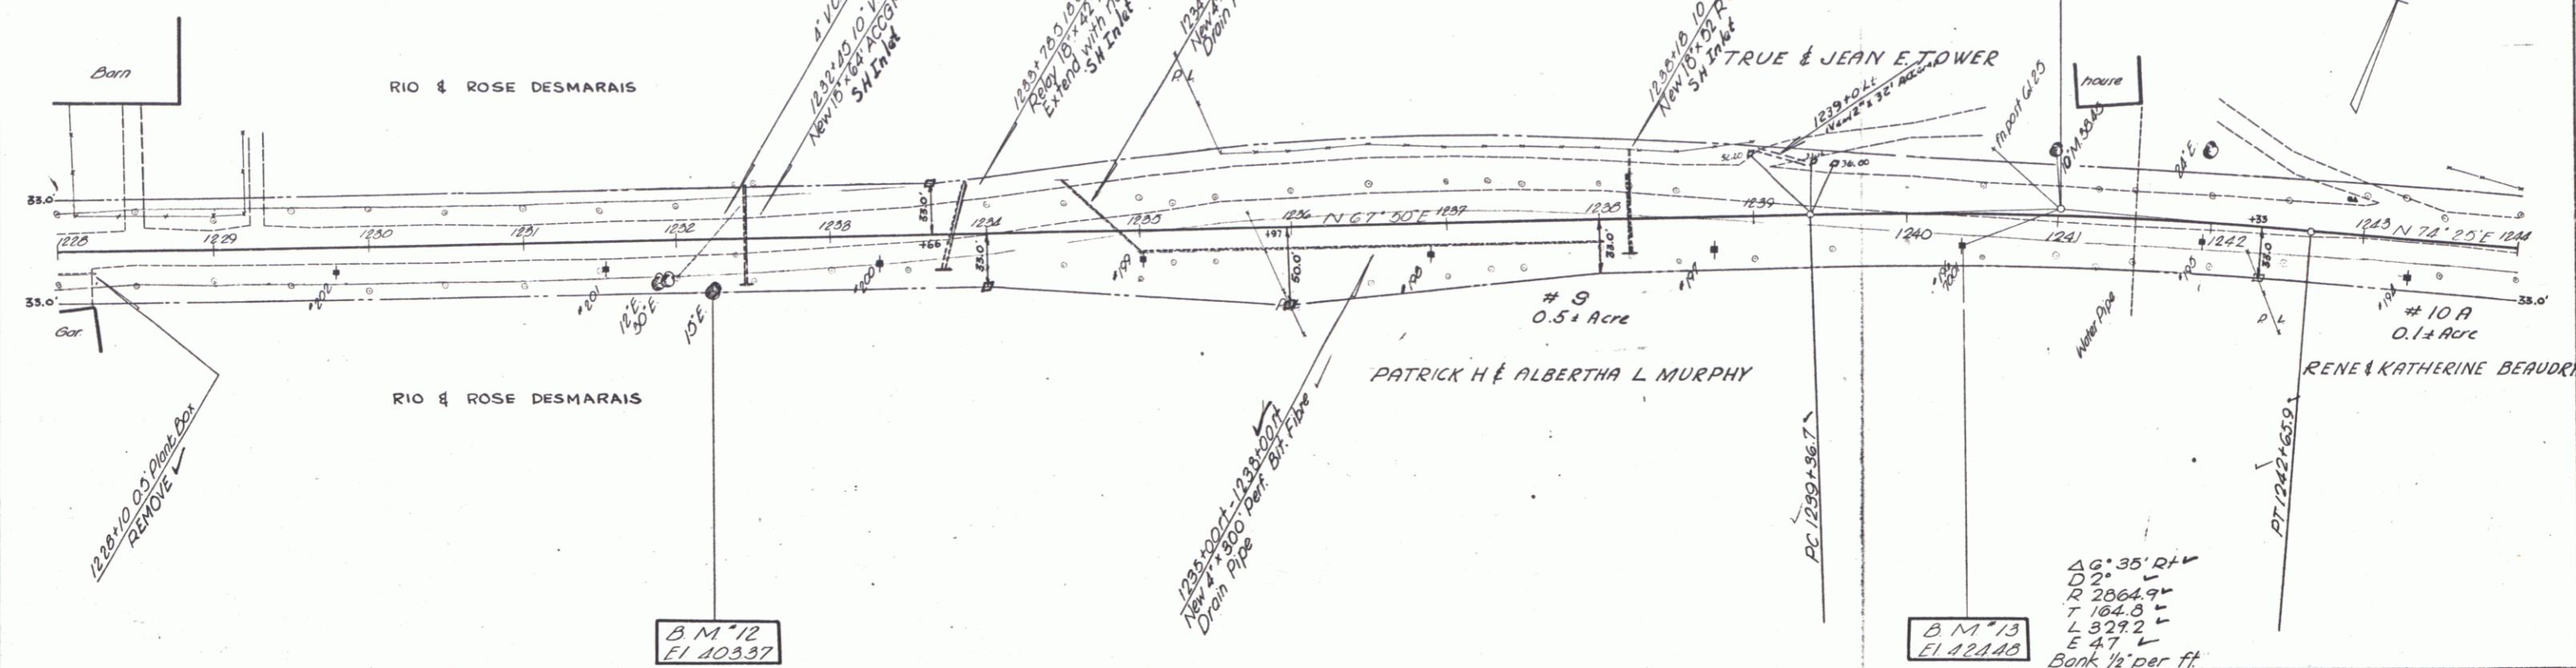

1228 B.M. #12 21.474' Sta. 1229 1230 1231 1232 1233 1234 1235 1236 1237 1238 1239 1240 1241 1242 1243 1244  
 B.M. #15 21.474' Sta. 1240+36 Spike in Power Pole 106 Elevation 424.18

ALBANY INASBURG  
 Project 5 No. 166(A)  
 Sheet 17 of 63

PLAN  
 DRAWN BY  
 CHECKED BY  
 DATE

PROFILE  
 DRAWN BY  
 CHECKED BY  
 DATE