

DIV. NO.	STATE	PROJ. NO.	FISCAL YEAR	SHEET NO.	TOTAL SHEETS
1	VT.	5166(4)	1952	63	63

INDEX OF SHEETS

SHEET NO. 1	TITLE PAGE
2	TYPICAL CROSS-SECTION OF IMPROVEMENT CRUSHED GRAVEL MIXED-IN-PLACE SURFACE COURSE WITH OUTSIDE ASPHALT, 1/2" 3/4" MOD.
3	BANKING AND WIDENING TABLES
4	QUANTITY SHEET (ITEMS)
5	QUANTITY SHEET (DRAINAGE)
6-9	EARTHWORK SHEETS
10-21	PLAN AND PROFILE SHEETS
22	CONSTRUCTION DETAILS (DRAINAGE AND MARKERS)
23	CONSTRUCTION DETAILS CD-1 (DITCHES)
24	CONSTRUCTION DETAILS CD-2 (TYPICAL GRADING)
25	STANDARD STRUCTURE SHEET S 53-48 (PRECAST Q.I. AND G.B.)
26	STANDARD STRUCTURE SHEET S 40 (BARRICADES, SIGNS AND LIGHTS)
27	STANDARD STRUCTURE SHEET S 57-52 (P.C. CONC. BLOCK CATCHBASIN OR N.H.)
28	STANDARD STRUCTURE SHEET S 45-45 (TWO CABLE GUARD RAIL)
29-63	CROSS SECTIONS


STANDARD STRUCTURE SHEET APPROVED BY THE CHIEF ENGINEER, VERMONT STATE DEPARTMENT OF HIGHWAYS
S-40 JUNE 10 1950

STATE OF VERMONT
STATE HIGHWAY DEPARTMENT
PLAN AND PROFILE OF PROPOSED STATE HIGHWAY

SECONDARY PROJECT
TOWNS OF ALBANY-IRASBURG Pin# 0012773

COUNTY OF ORLEANS
VERMONT ROUTE 14
CRAFTSBURY-COVENTRY ROAD

BEGINNING AT A POINT 1422 FEET SOUTHWESTERLY OF THE ALBANY-IRASBURG TOWN LINE AND EXTENDING NORTHERLY 16,498.2 FEET
LENGTH OF PROJECT 16,415.1 FEET = 3.109 MILES (EXCLUDING BRIDGE)

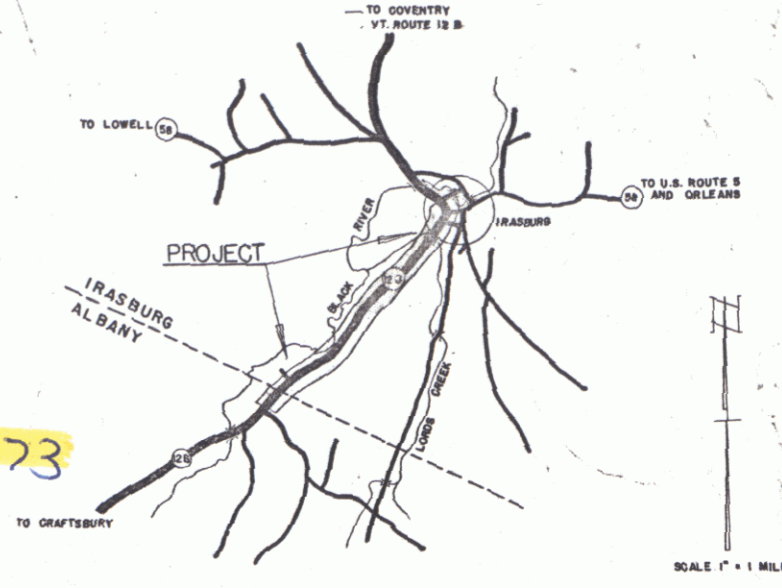


PROJECT NAME & NUMBER	TYPE	PAVEMENT AREA
ALBANY-IRASBURG S 166 (4)	MIXED IN PLACE	38302 S.Y.
RECORD PLANS		
MATERIALS		
SUB-BASE OF GRAVEL CROTEAU, HOULE & JIMMER PITS, IRASBURG	PEASTONE SEAL CAL. SAND & GRAVEL CO.	
CR. GRAVEL CAL. SAND & GRAVEL CO.	RCP VT. CONC. PIPE CO., WINDSOR, VT.	
ASPHALT SOCONY VACUUM OIL CO., RIVERSIDE, R.I.	ACCGMP NEW ENG. MET. PIPE CO. PALMER, MASS.	
FIBRE DRAIN PIPE BROWN CO., BERLIN, N.H.	CEMENT AMERICAN CEMENT CO.	
GUARD RAIL AM. STEEL & WIRE CO. NEW HAVEN, CT.		
CONTRACTOR CALEDONIA SAND & GRAVEL CO.	CONTRACT DATED DEC. 29, 1952	
RES. ENGINEER E. C. GLYSSON	CONTRACT STARTED DEC. 30, 1952	
INSPECTOR F. C. SCRIBNER - C. J. CROSSETT	CONTRACT COMPLETED OCT 27, 1953	
RECORD PLANS C. J. CROSSETT	CONTRACT ACCEPTED OCT 27, 1953	



RIGHT-OF-WAY DIVISION
TOWN FILE
PERPETUAL
Row 5P VT 14
(To Be Returned To R.O.W. Division)

APPROVED: AUG 28, 1952
H. E. Sargent
CHIEF ENGINEER
SUBMITTED BY ORDER OF THE STATE HIGHWAY BOARD

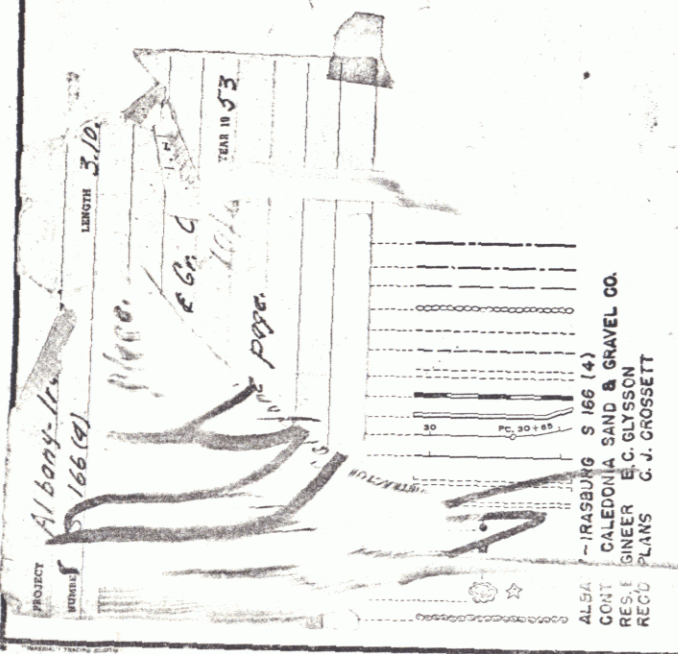

CURVE DATA

DEFLECTION ANGLE	Δ
DEGREE OF CURVE	D
RADIUS OF CURVE	R
TANGENT DISTANCE	T
LENGTH OF CURVE	L
EXTERNAL DISTANCE	E
POINT OF INTERSECTION	P. I.
POINT OF TANGENT	P. T.
POINT ON TANGENT	P. O. T.

SCALES

TITLE	1" = 1000'
TYPICAL	1" = 2'
PLAN	1" = 80'
PROFILE HORIZONTAL	1" = 50'
PROFILE VERTICAL	1" = 10'
CROSS SECTIONS	1" = 8'


THESE PLANS ARE SUBJECT TO SUCH REVISIONS AS MAY BE REQUIRED BY THE BUREAU OF PUBLIC ROADS OR THE COMMISSIONER OF HIGHWAYS.
CONSTRUCTION IS TO BE CARRIED ON IN ACCORDANCE WITH THE PLANS AND THE STANDARD ROAD AND BRIDGE SPECIFICATIONS OF 1948, AS APPROVED JULY 23, 1949 BY THE BUREAU OF PUBLIC ROADS INCLUDING ALL SUBSEQUENT APPROVED REVISIONS AND SUCH REVISED SPECIFICATIONS AND SPECIAL PROVISIONS AS ARE SUBMITTED WITH THE PLANS.

DEPARTMENT OF COMMERCE BUREAU OF PUBLIC ROADS	RECOMMENDED FOR APPROVAL
DISTRICT ENGINEER	DATE
APPROVED	
DIVISION ENGINEER	DATE


APPROVED: <i>[Signature]</i> AUG 29 1952	APPROVED: <i>[Signature]</i> AUG 29 1952	APPROVED: <i>[Signature]</i> AUG 29 1952	APPROVED: <i>[Signature]</i> AUG 29 1952
SECONDARY ENGINEER	DISTRICT ENGINEER	DISTRICT ENGINEER	DISTRICT ENGINEER

Albany-Irasburg 153

PLAN
 DATE: 1-32
 DRAWN BY: S. J. PALMER
 CHECKED BY: S. J. PALMER
 SCALE: AS SHOWN
 PROJECT: ALBANY-TRASBURG
 SHEET: 63

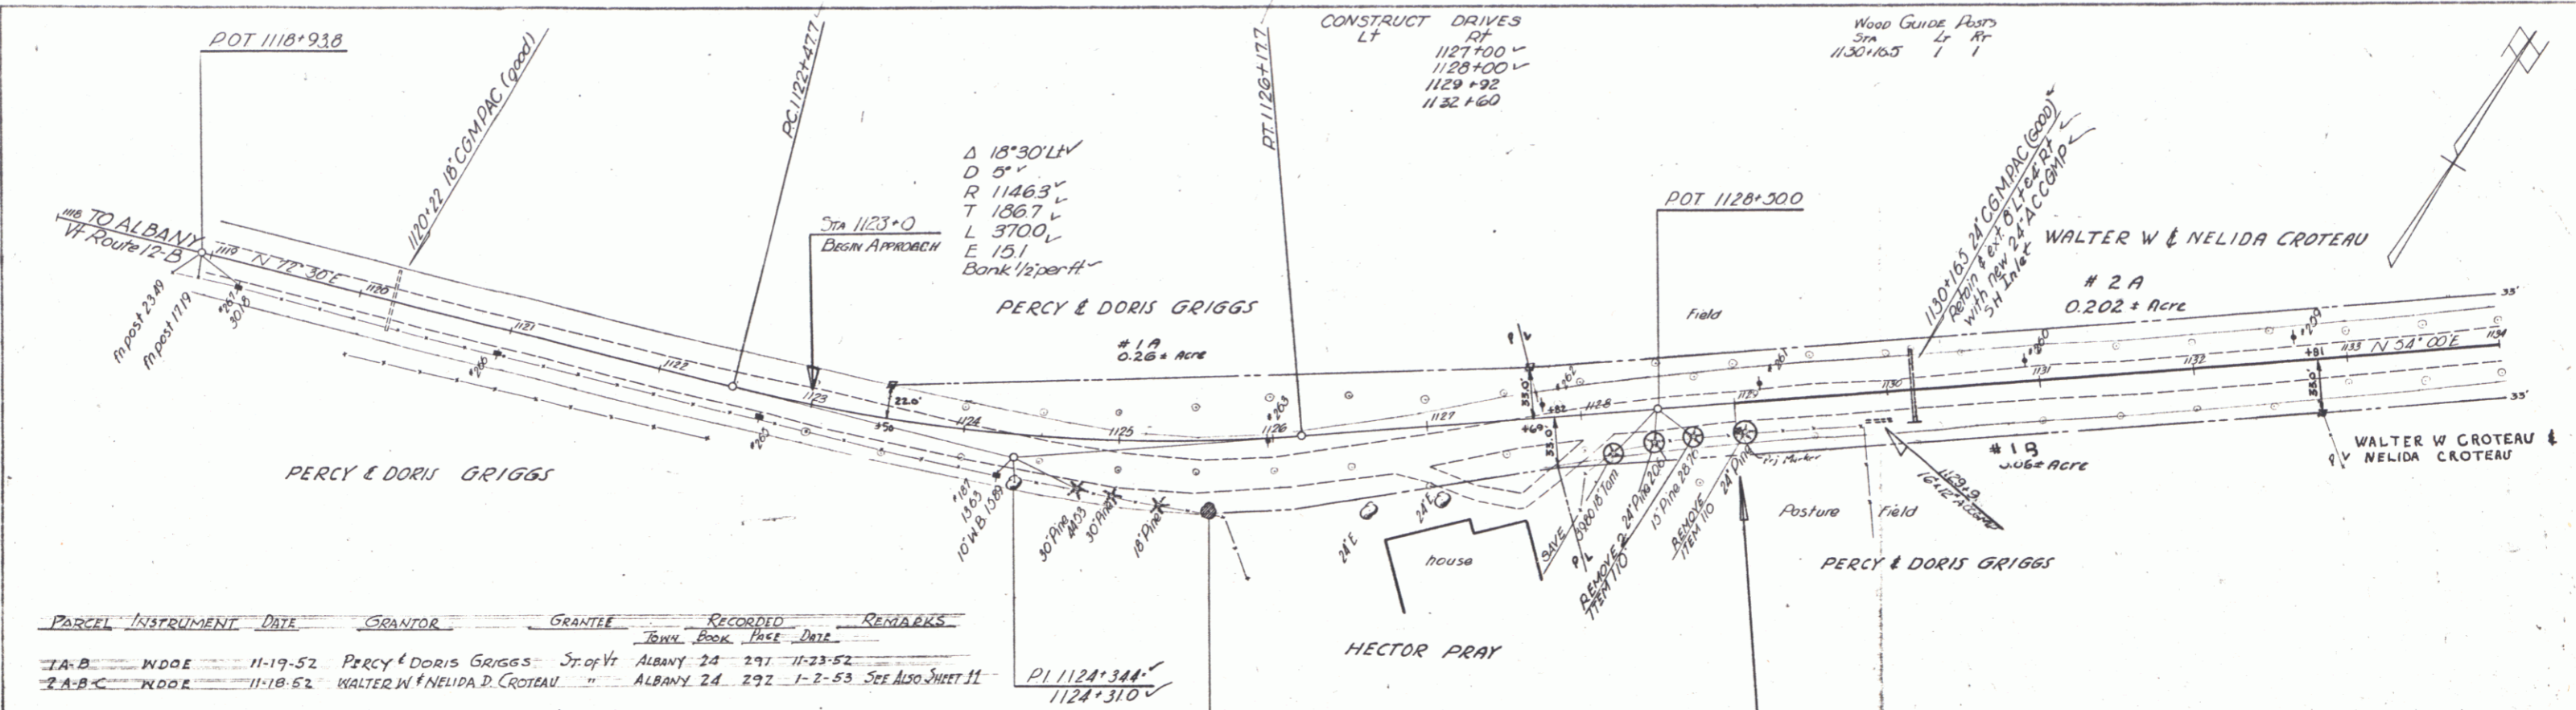



PROFILE
 DATE: 1-32
 DRAWN BY: S. J. PALMER
 CHECKED BY: S. J. PALMER
 SCALE: AS SHOWN
 PROJECT: ALBANY-TRASBURG
 SHEET: 63

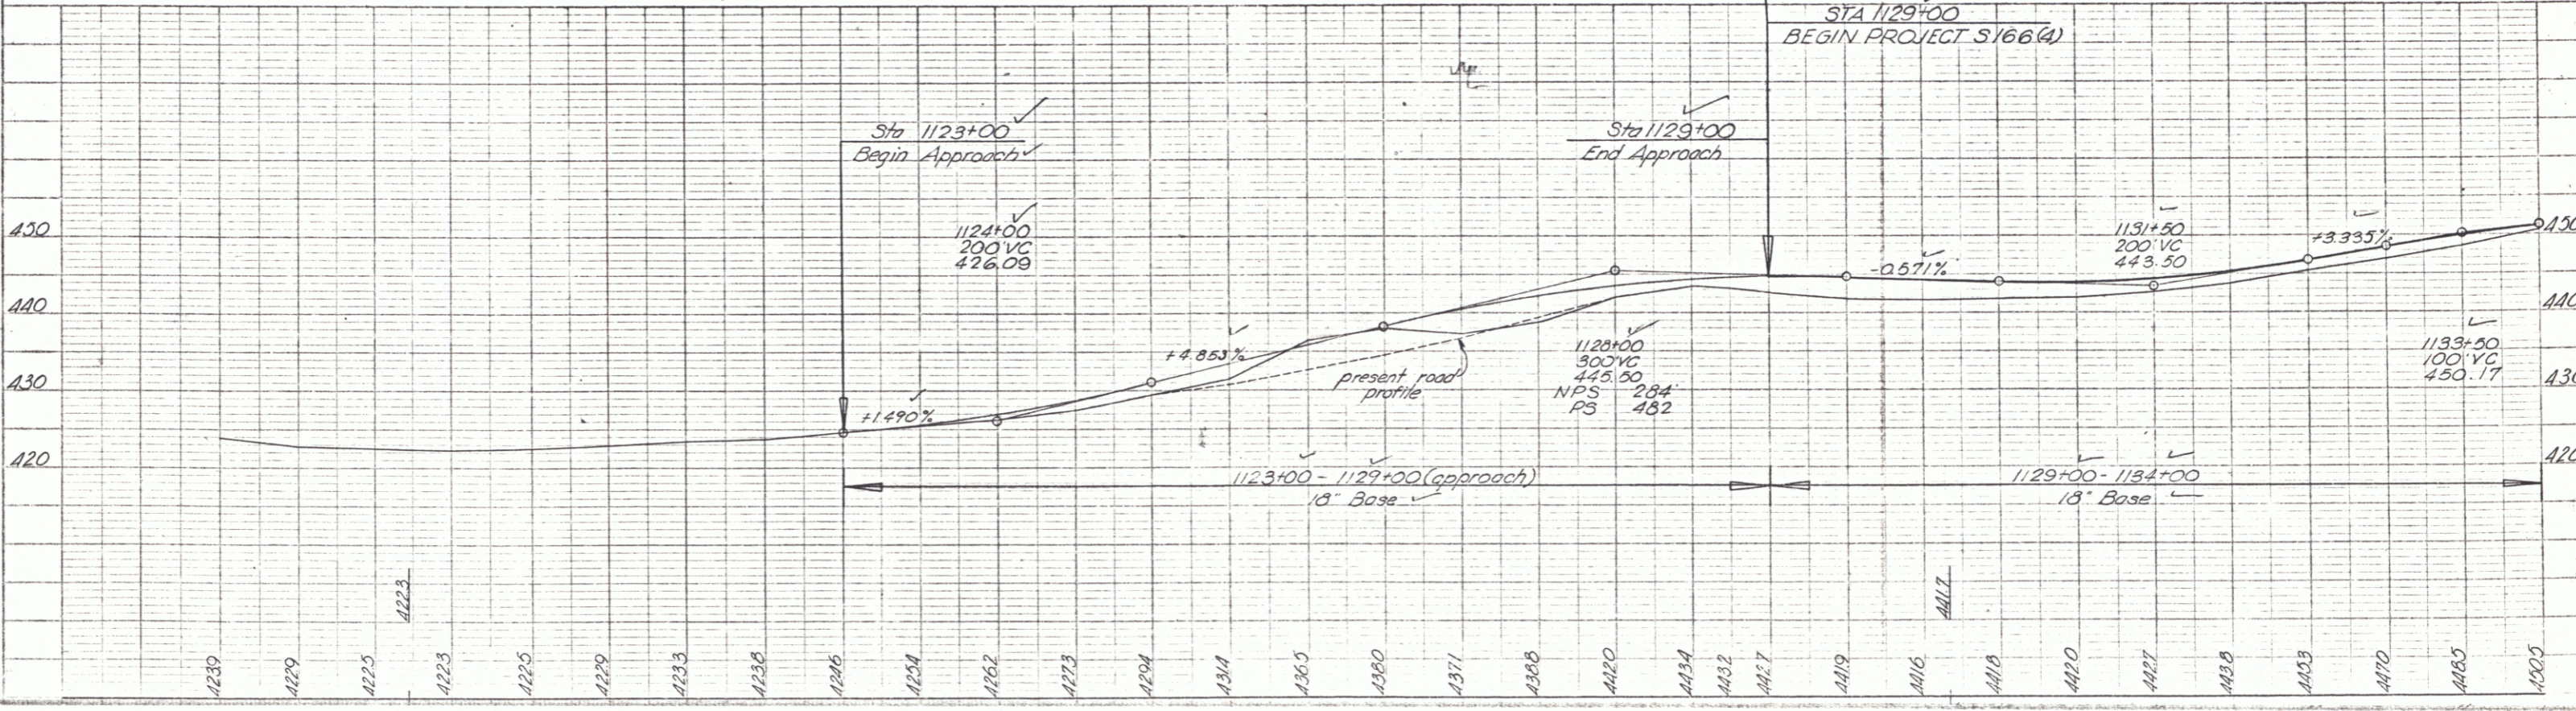

1118 B.M. 1 S1R 13' Pine 25' Ft. Rt Sta 1116+93 E Lev. 436.10
 1120 B.M. 2 S1R 24' Elm 46' Ft. Rt Sta 1125+09 Elev. 439.29
 1122
 1123
 1124
 23

PLAN
 DATE: 11-28-1952
 SHEET NO. 1166 (A)
 PROJECT NO. 1066 (A)
 DRAWN BY: [Signature]
 CHECKED BY: [Signature]

PROFILE
 DATE: 11-28-1952
 SHEET NO. 1166 (A)
 PROJECT NO. 1066 (A)
 DRAWN BY: [Signature]
 CHECKED BY: [Signature]

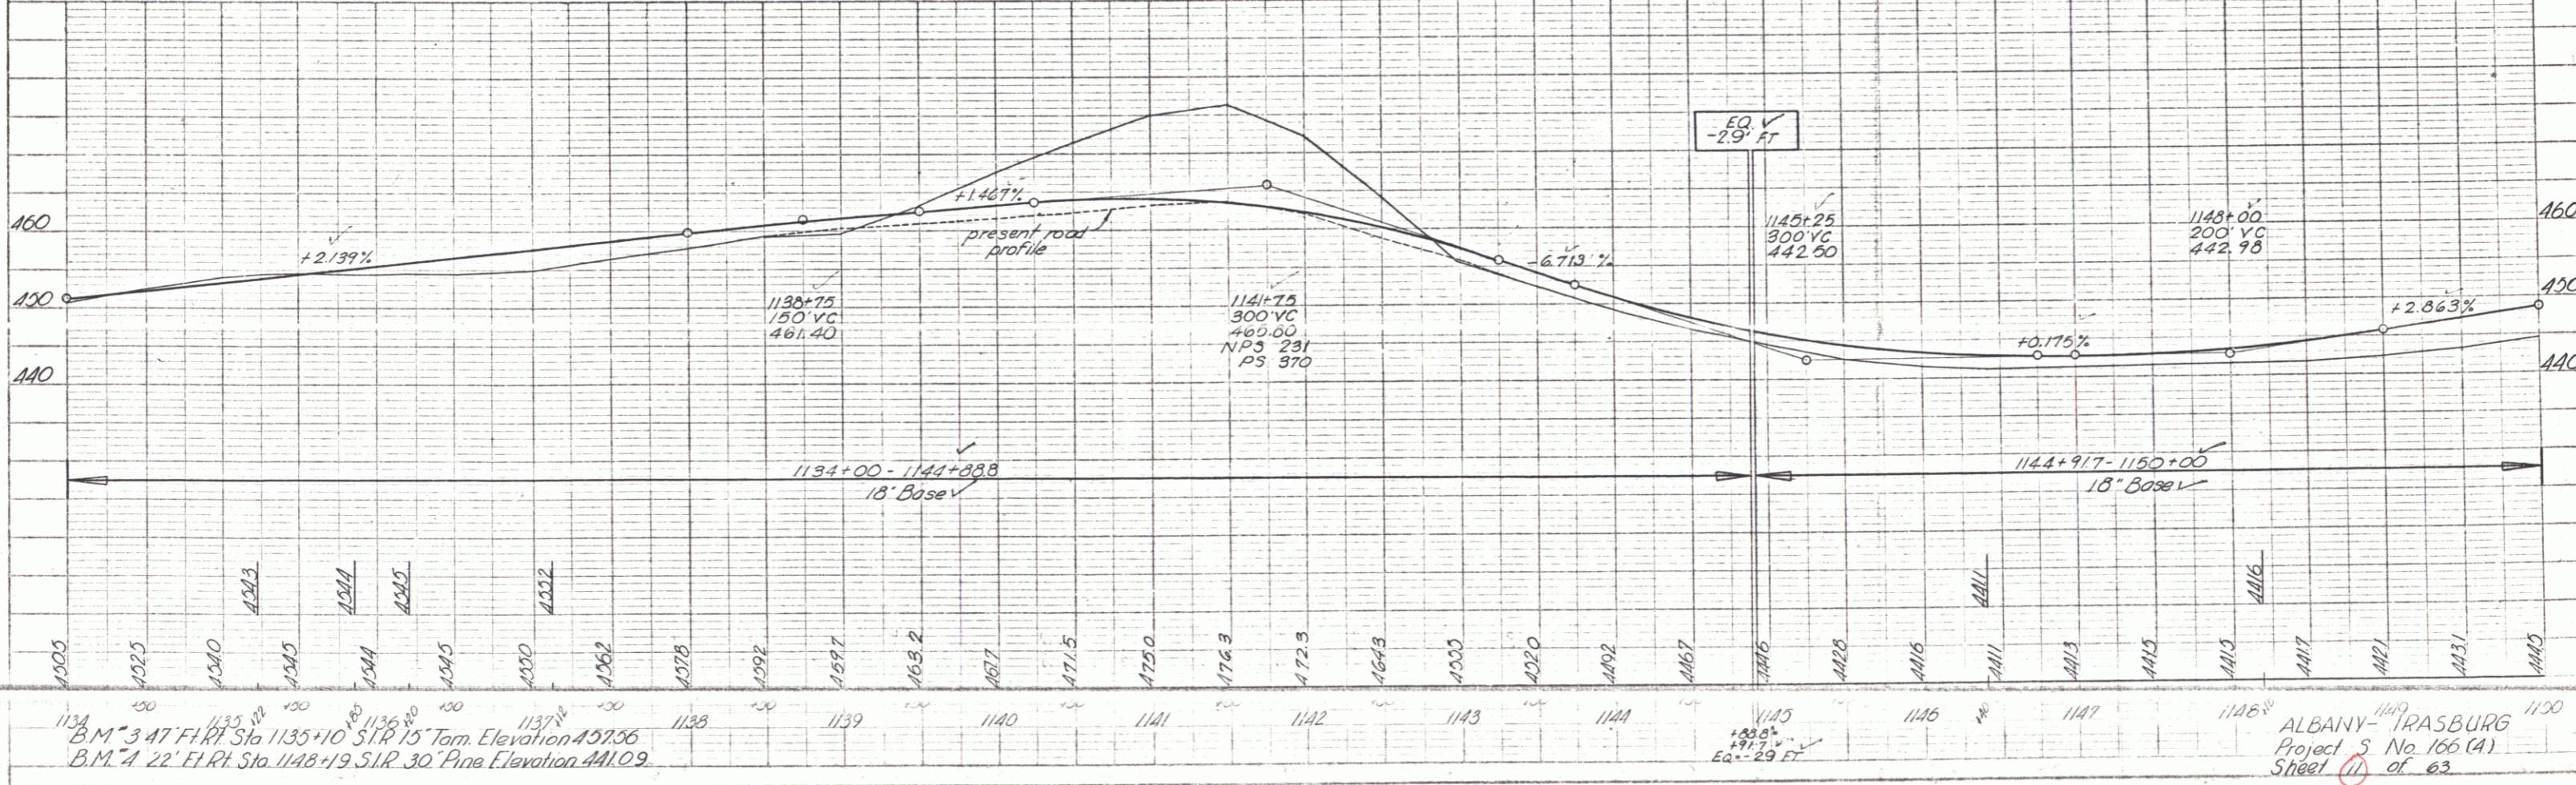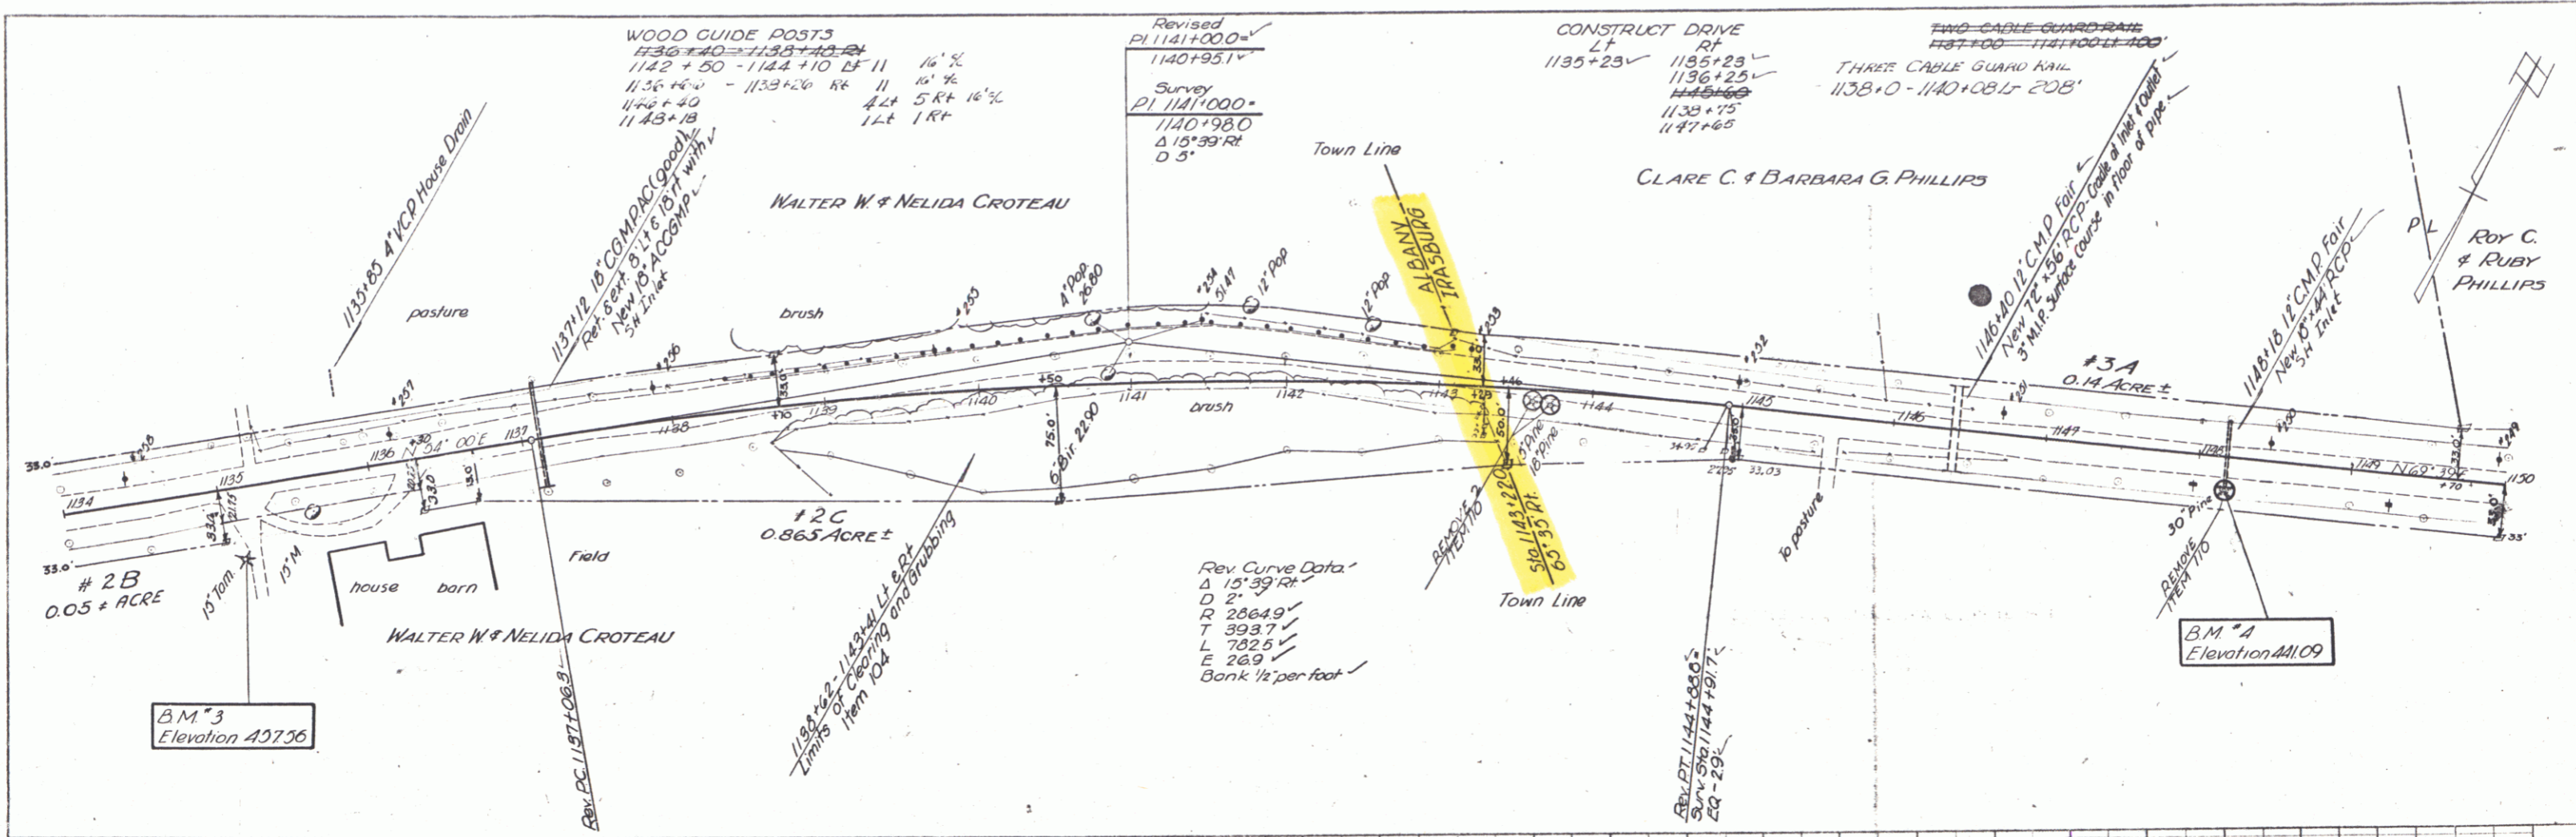



B.M. 3 47' FT. Sta. 1135+10 S.I.R. 15" Tom. Elevation 457.56
 B.M. 4 22' FT. Sta. 1148+19 S.I.R. 30" Pine E. Elevation 441.09

ALBANY-IRASBURG
 Project No. 1066 (A)
 Sheet 1166 of 63

PLATE 1 - PLAN (TOP) LT. U.P.A. & R.E. STANDARD
 ADAPTED & REVISED BY NEW YORK
 STATE ENGINEERS ASSOCIATION
 NEW YORK STATE ENGINEERS ASSOCIATION

Parcel	Instr	Date	Grantor	Grantee	Recorded	Book	Page	Date	Remarks
#3A,B	W.D.O.E.	11-18-52	Clare C. & Barbara G. Phillips	St. of Vt.	Irishburg	22	281	11-21-52	See Sheet 11
#4	W.D.O.E.	11-18-52	Roy C. & Ruby Phillips	St. of Vt.	"	22	285	11-21-52	See Sheet 11
#5A,B,C,D	W.D.O.E.	11-18-52	Ernest & Doria Houle	St. of Vt.	"	22	279	11-21-52	See Sheet 13

Wood Guide Posts
Sta 1154+25 L 1 R 1

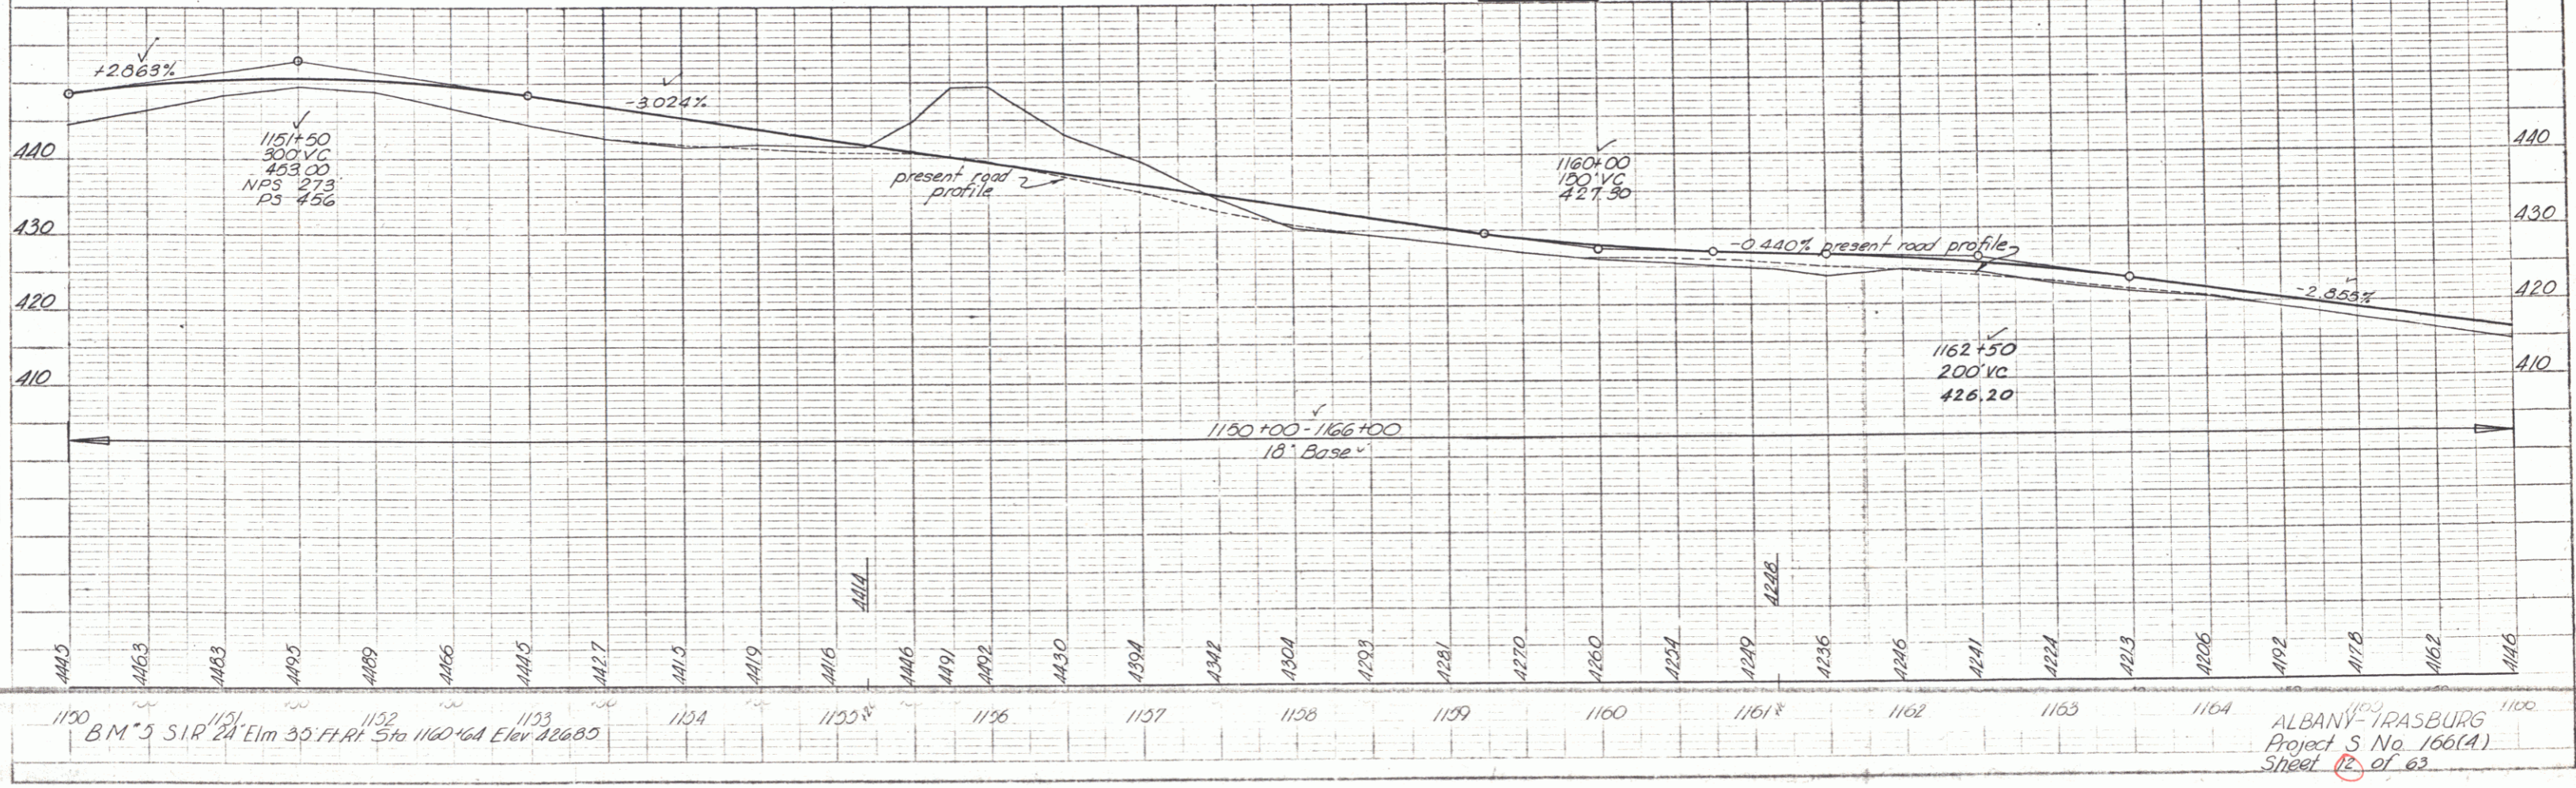
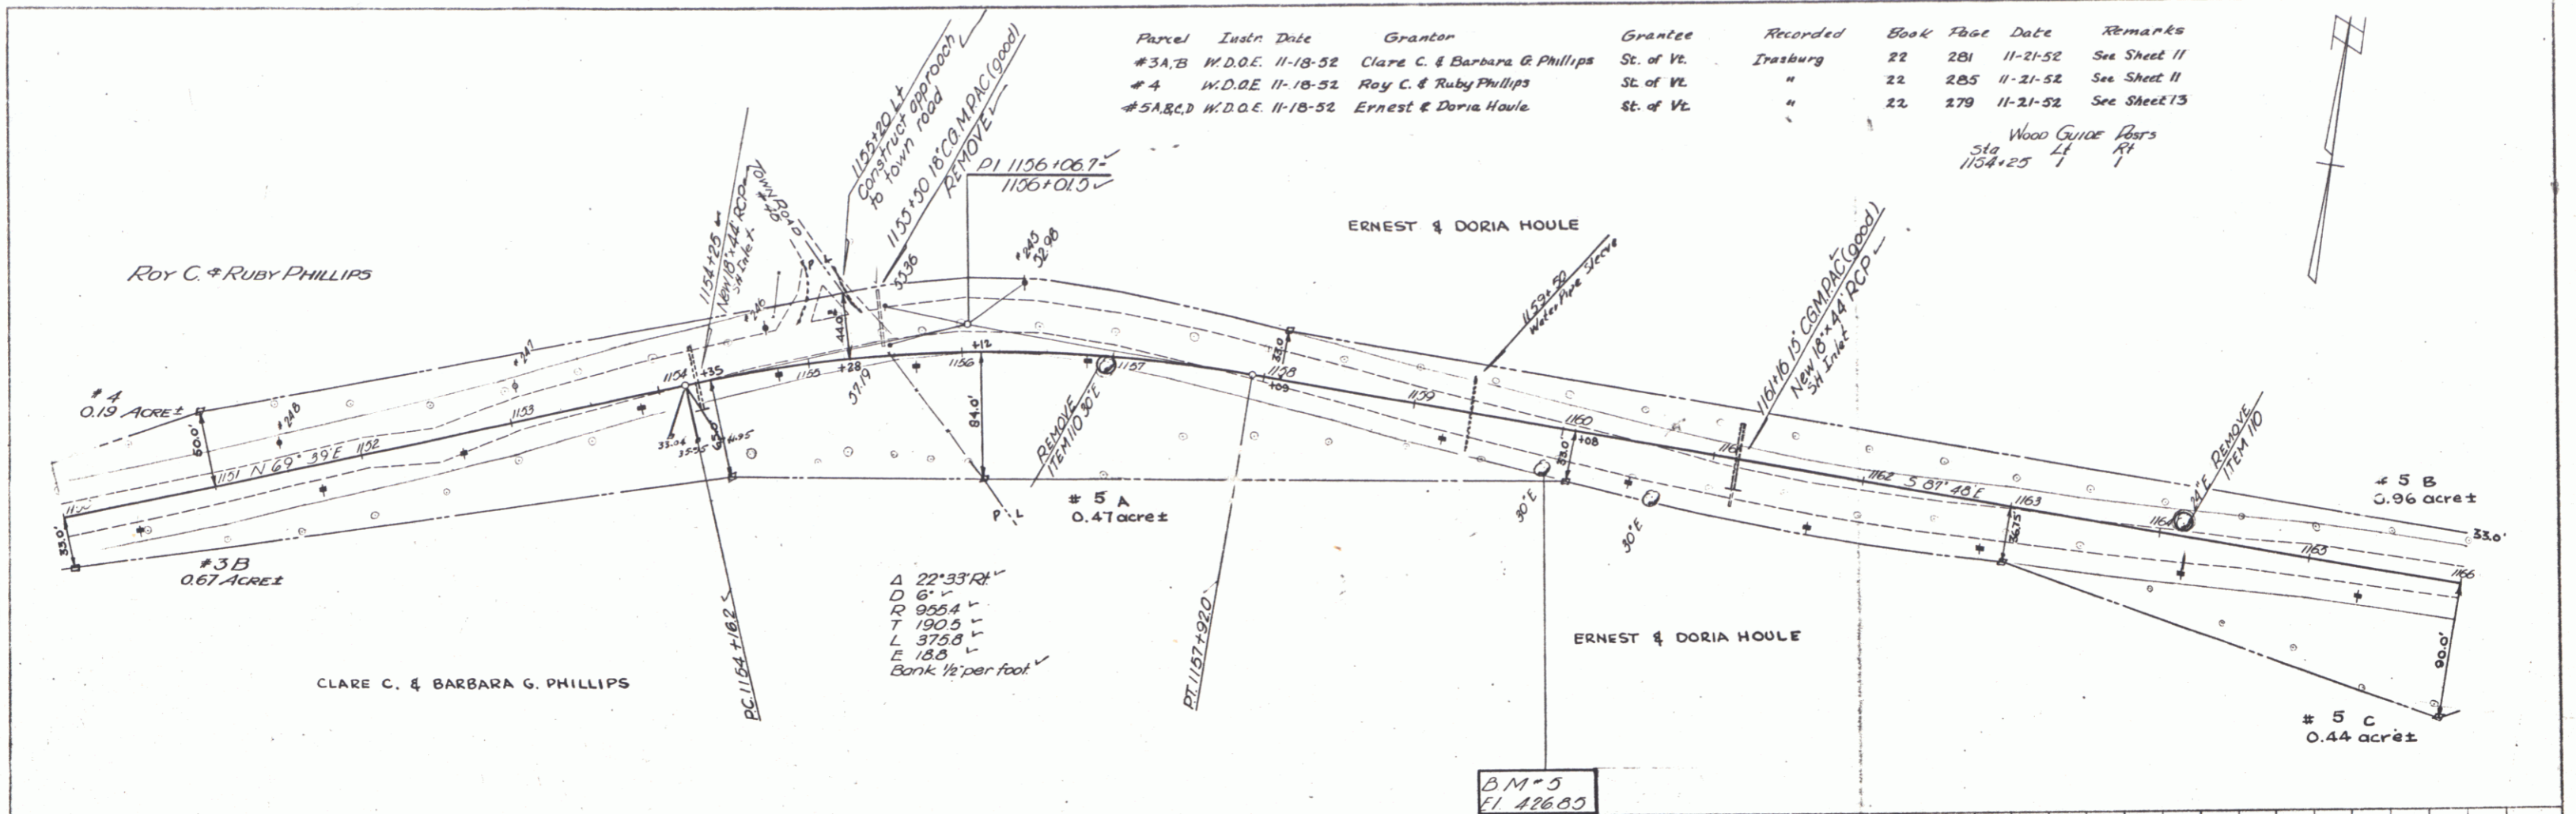


PLAN
Scale 1" = 30'
1-28


PROFILE
Scale 1" = 30'
1-28

B.M. 5 SIR 24 Elm 35' FR. Sta 1160+66 Elev. 426.85


ALBANY-IRASBURG
Project S No 166(A)
Sheet 17 of 63

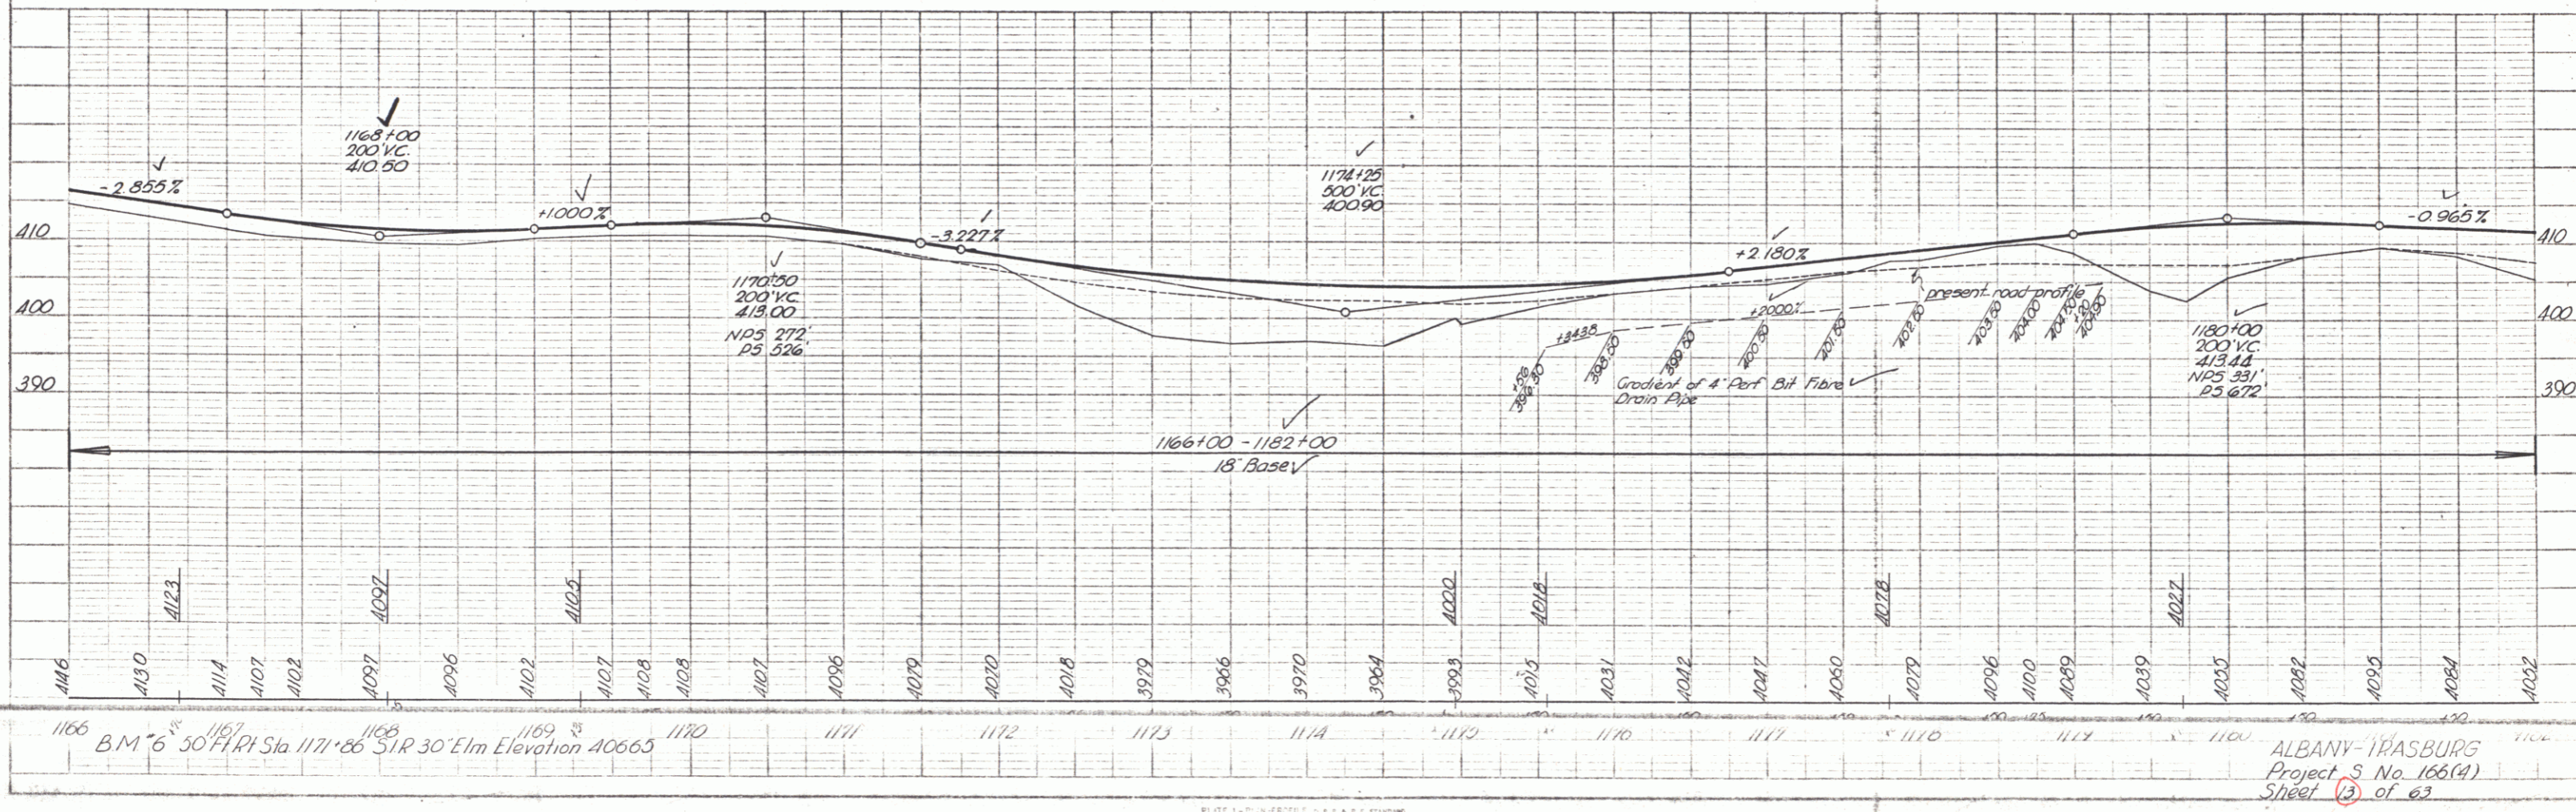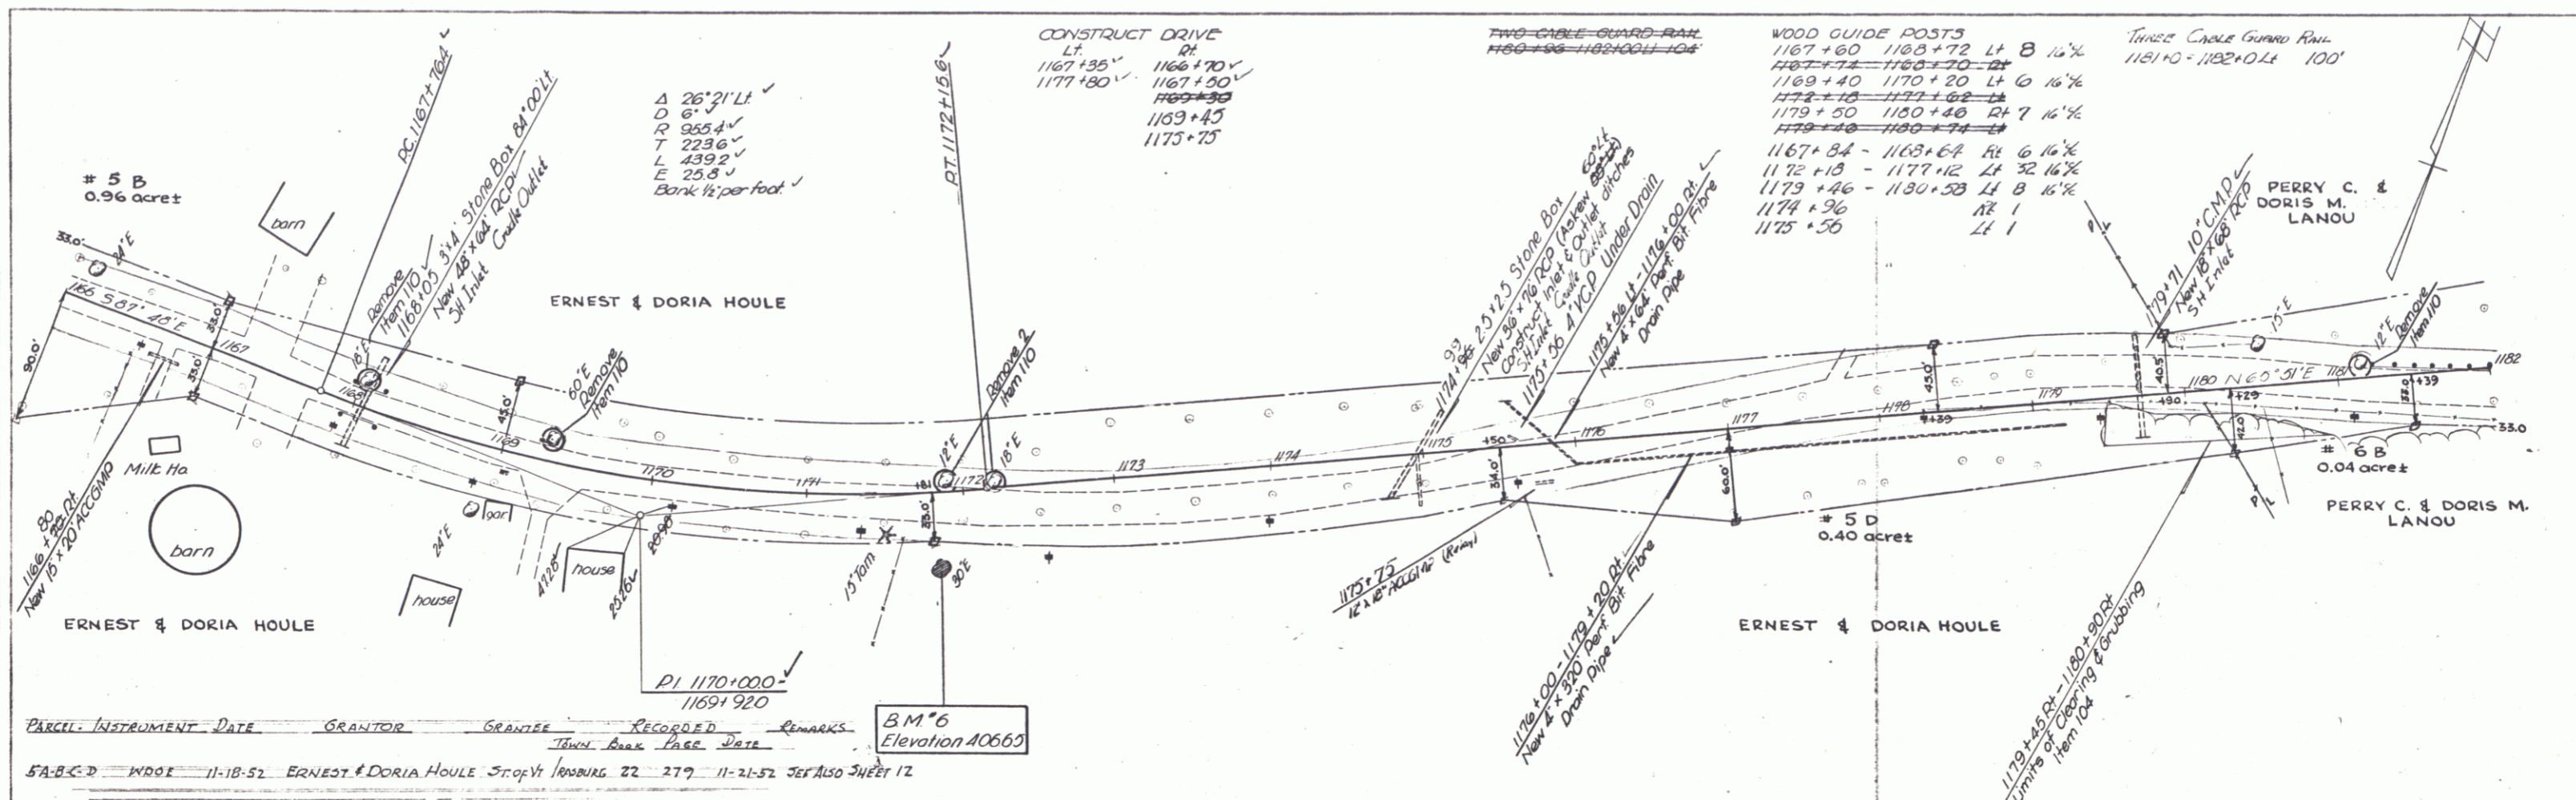

PLAN
 DATE: 1-31-52
 DRAWN BY: S. Palmer
 CHECKED BY: S. Palmer
 SCALE: 1" = 40'

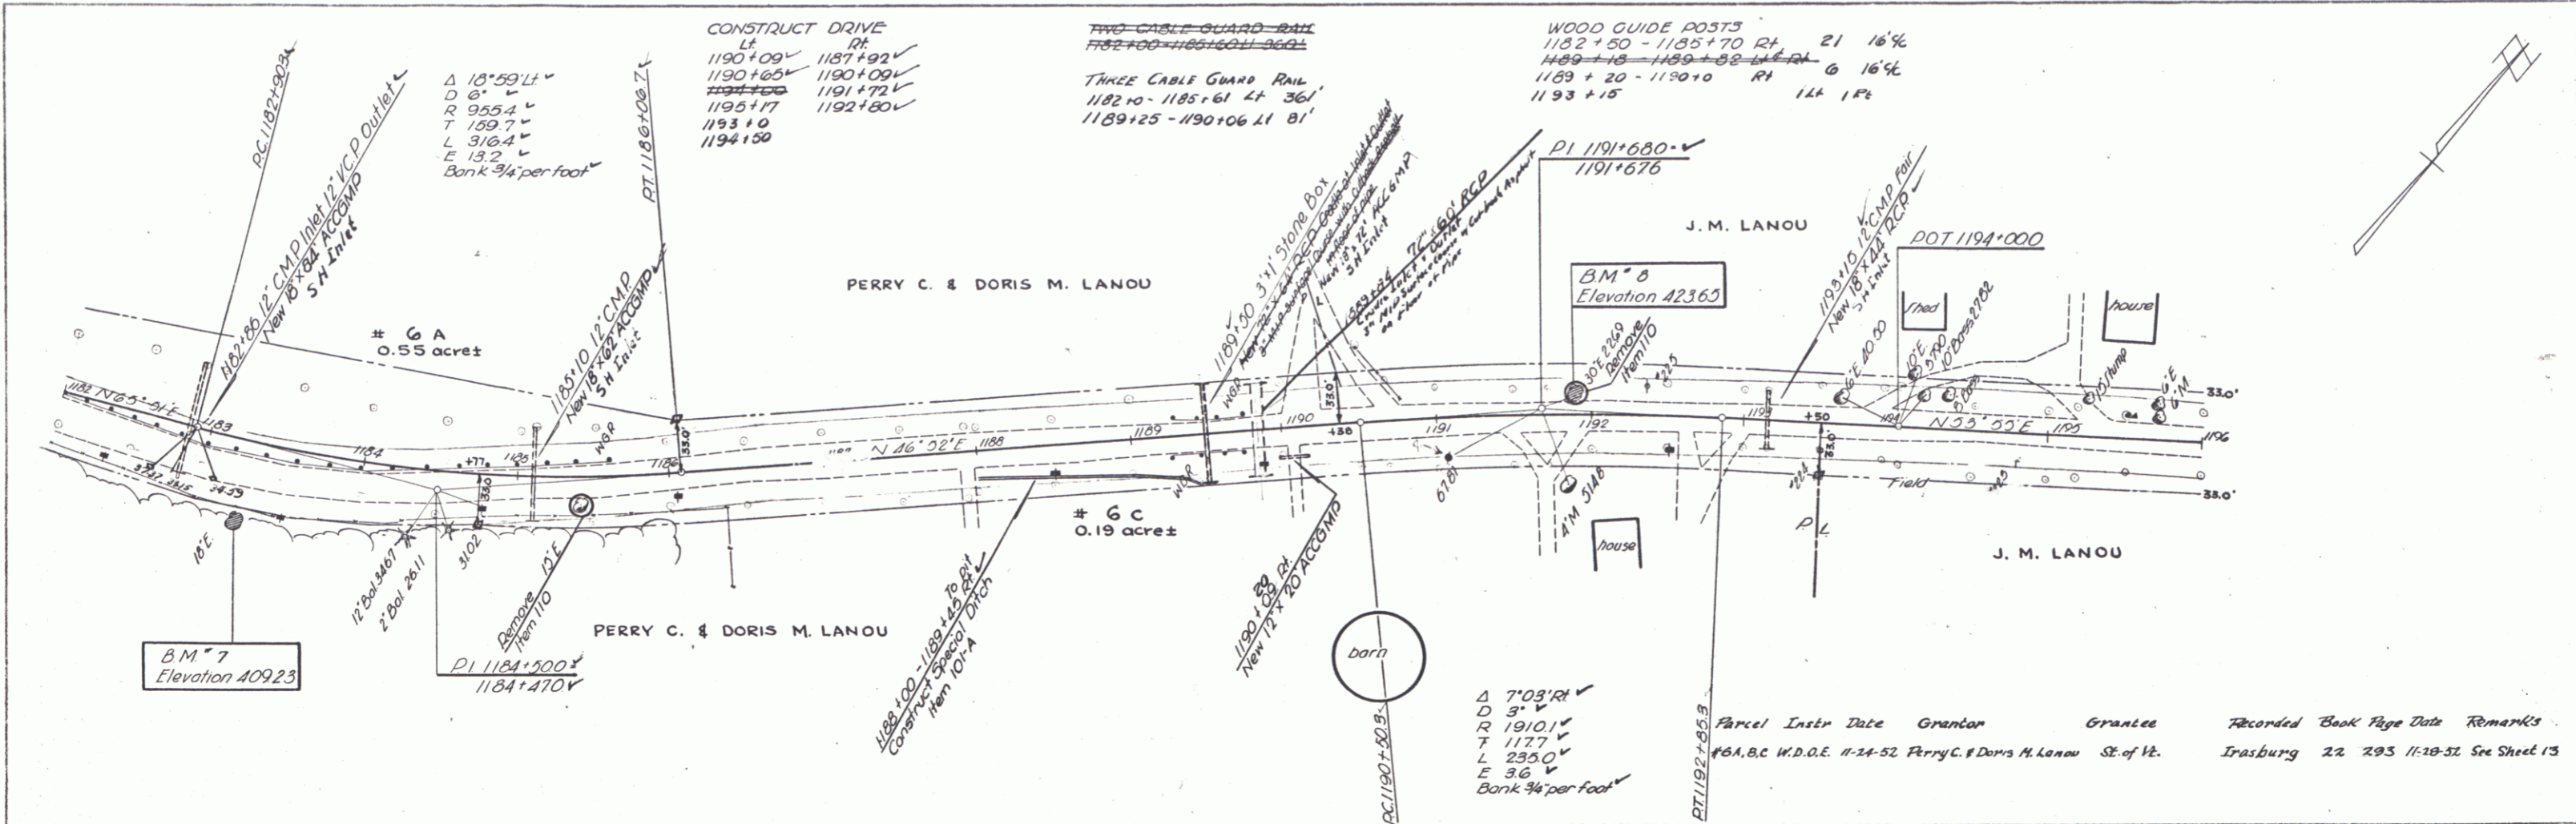


PROFILE
 DATE: 1-31-52
 DRAWN BY: S. Palmer
 CHECKED BY: S. Palmer
 SCALE: 1" = 40'

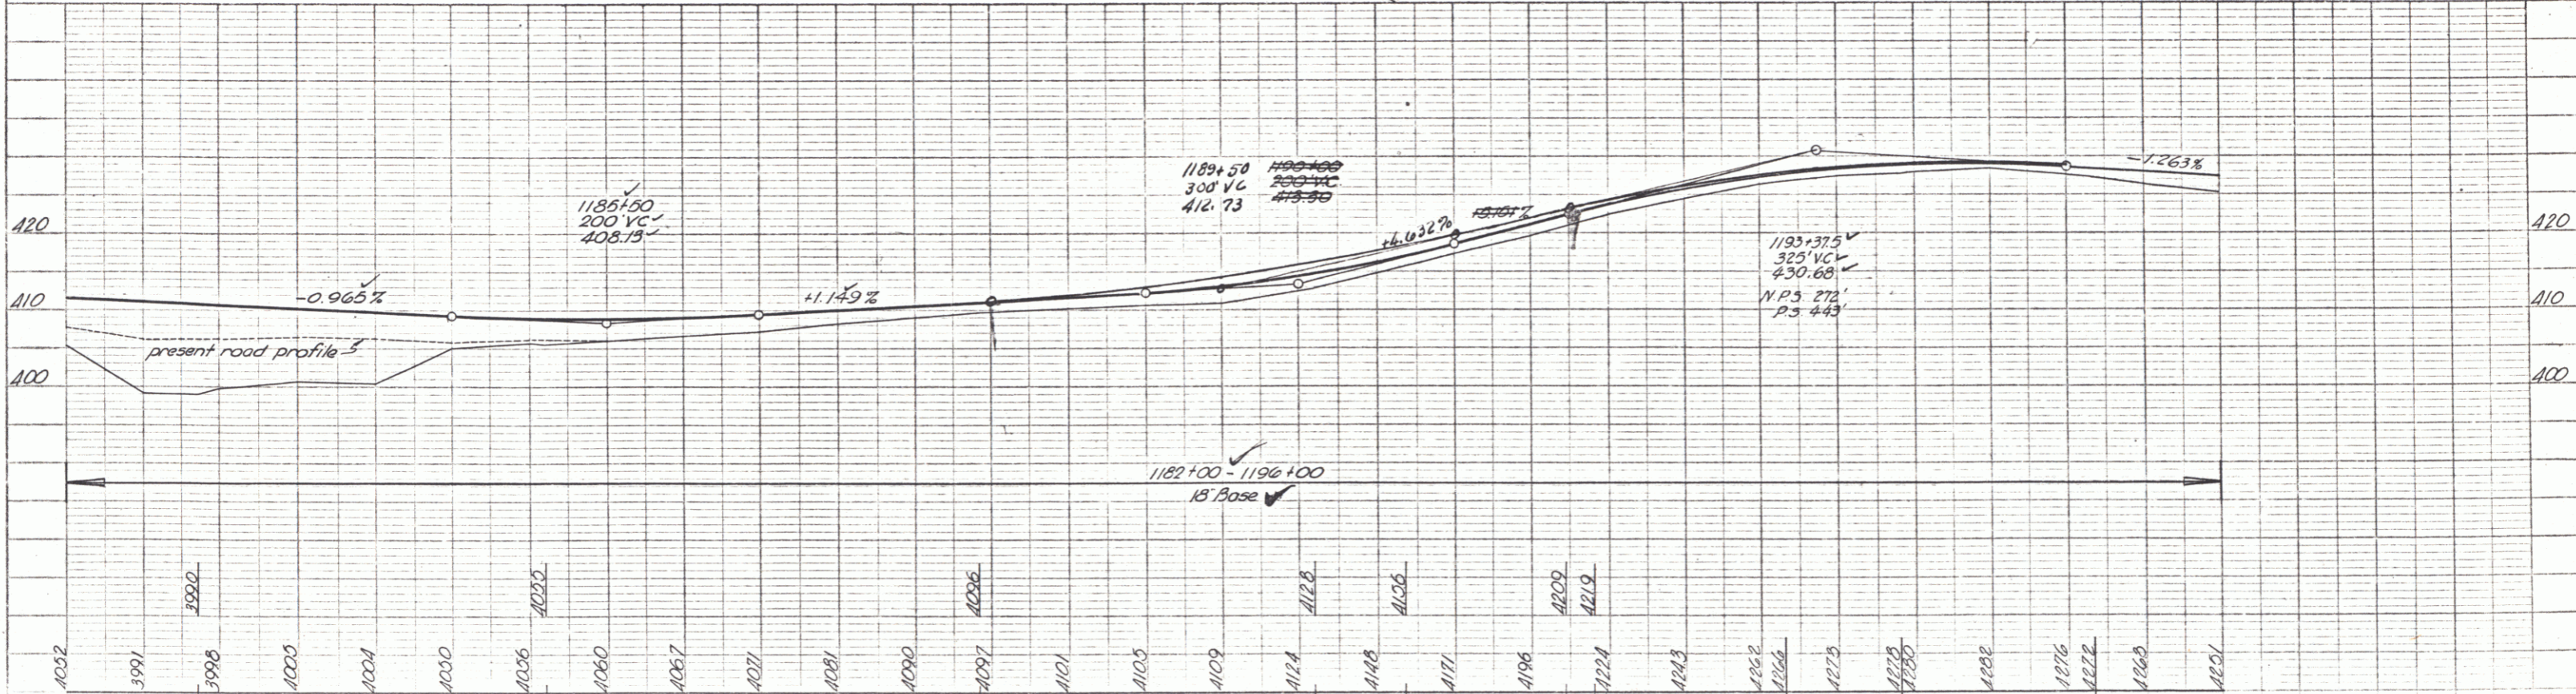


1182 B.M. #7 54' Lt. Sta. 1183+28 S.I.R. 18" Elm Elevation 409.23
 1184 B.M. #8 13' Lt. Sta. 1191+90 S.I.R. 30" Elm Elevation 423.65

ALBANY-IRASBURG
 Project 5, No. 166(A)
 Sheet 12 of 63

PLAN
 DRAWN BY: J. M. Lanou
 CHECKED BY: J. M. Lanou
 DATE: 11-15-52
 PROJECT: RIO & ROSE DESMARAIS

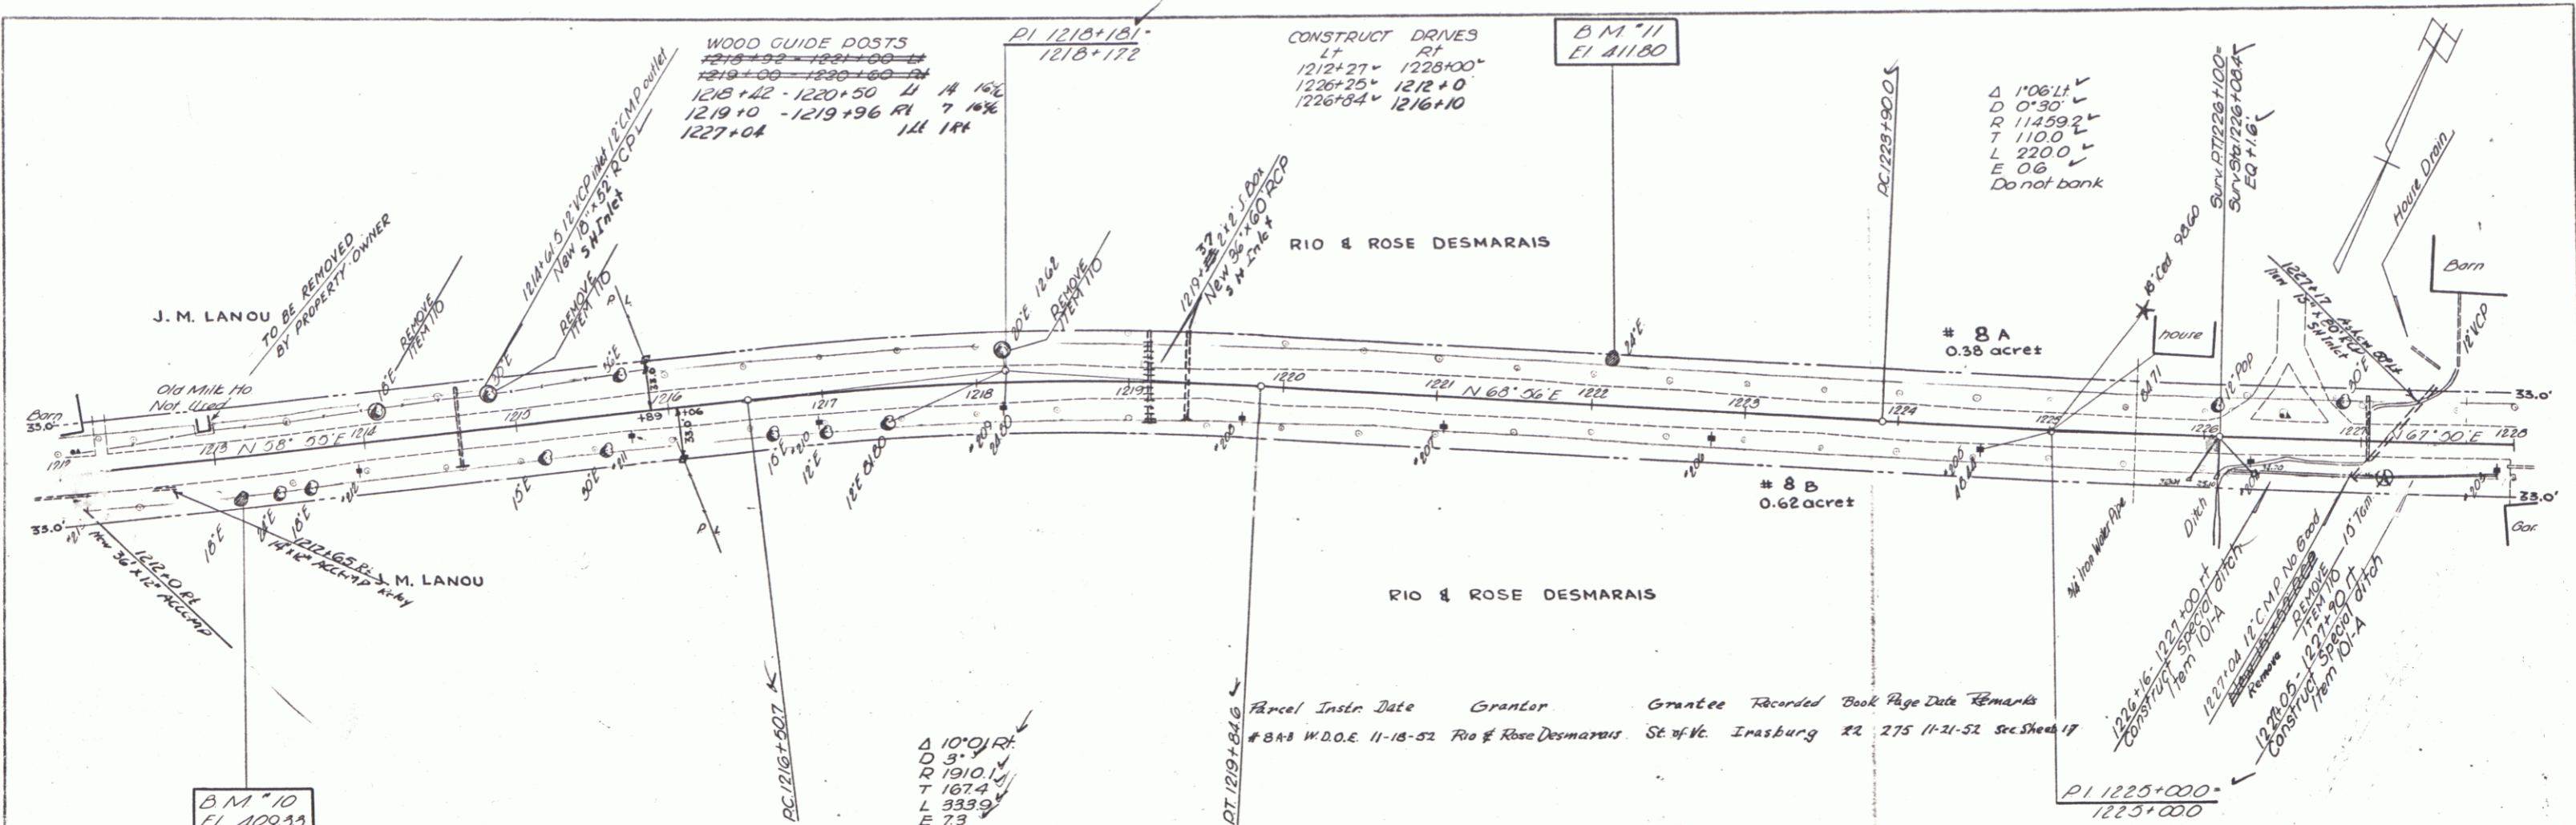


PROFILE
 DRAWN BY: J. M. Lanou
 CHECKED BY: J. M. Lanou
 DATE: 11-15-52
 PROJECT: RIO & ROSE DESMARAIS

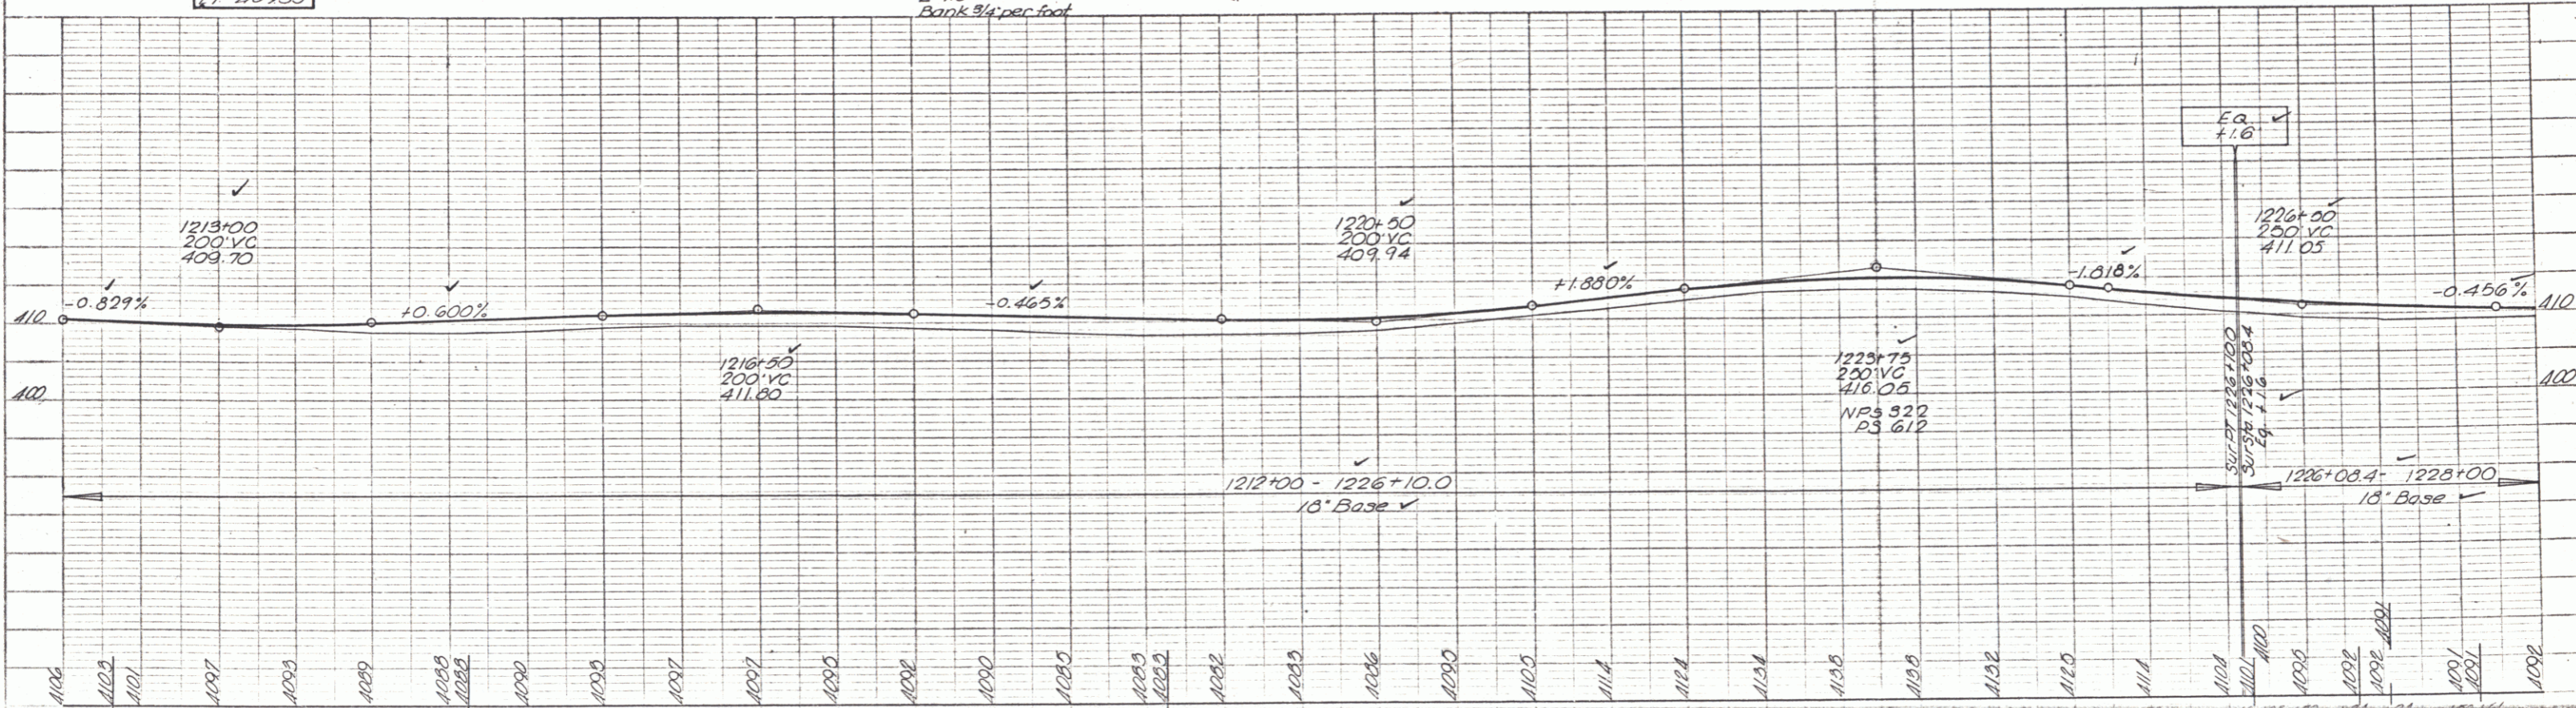

1212 B.M. #10 20' F.H.L. Sta 1213+14 S.I.R. 15' Elm. Elevation 109.55
 1213 B.M. #11 31' F.H.L. Sta 1222+12 S.I.R. 24' Elm. Elevation 111.80
 1214
 1215
Parcel	Instn	Date	Grantee	Grantee	Recorded	Book	Page	Title	REMARKS
#9	W.O.E.	11-24-52	Patrick H. Albert & Lynn Murphy	St. of Pt.	Inasburg	22	315	1-17-53	

CONSTRUCT DRIVES		WOOD GUIDE POSTS	
LT	RT	LT	RT
1228+50		1232+04	1233+96
1229+26		1232+00	1232+00
1239+00		1232+50	1233+00
1243+15		1233+78	1234+00
		1234+50	1238+18
		1238+00	1238+00

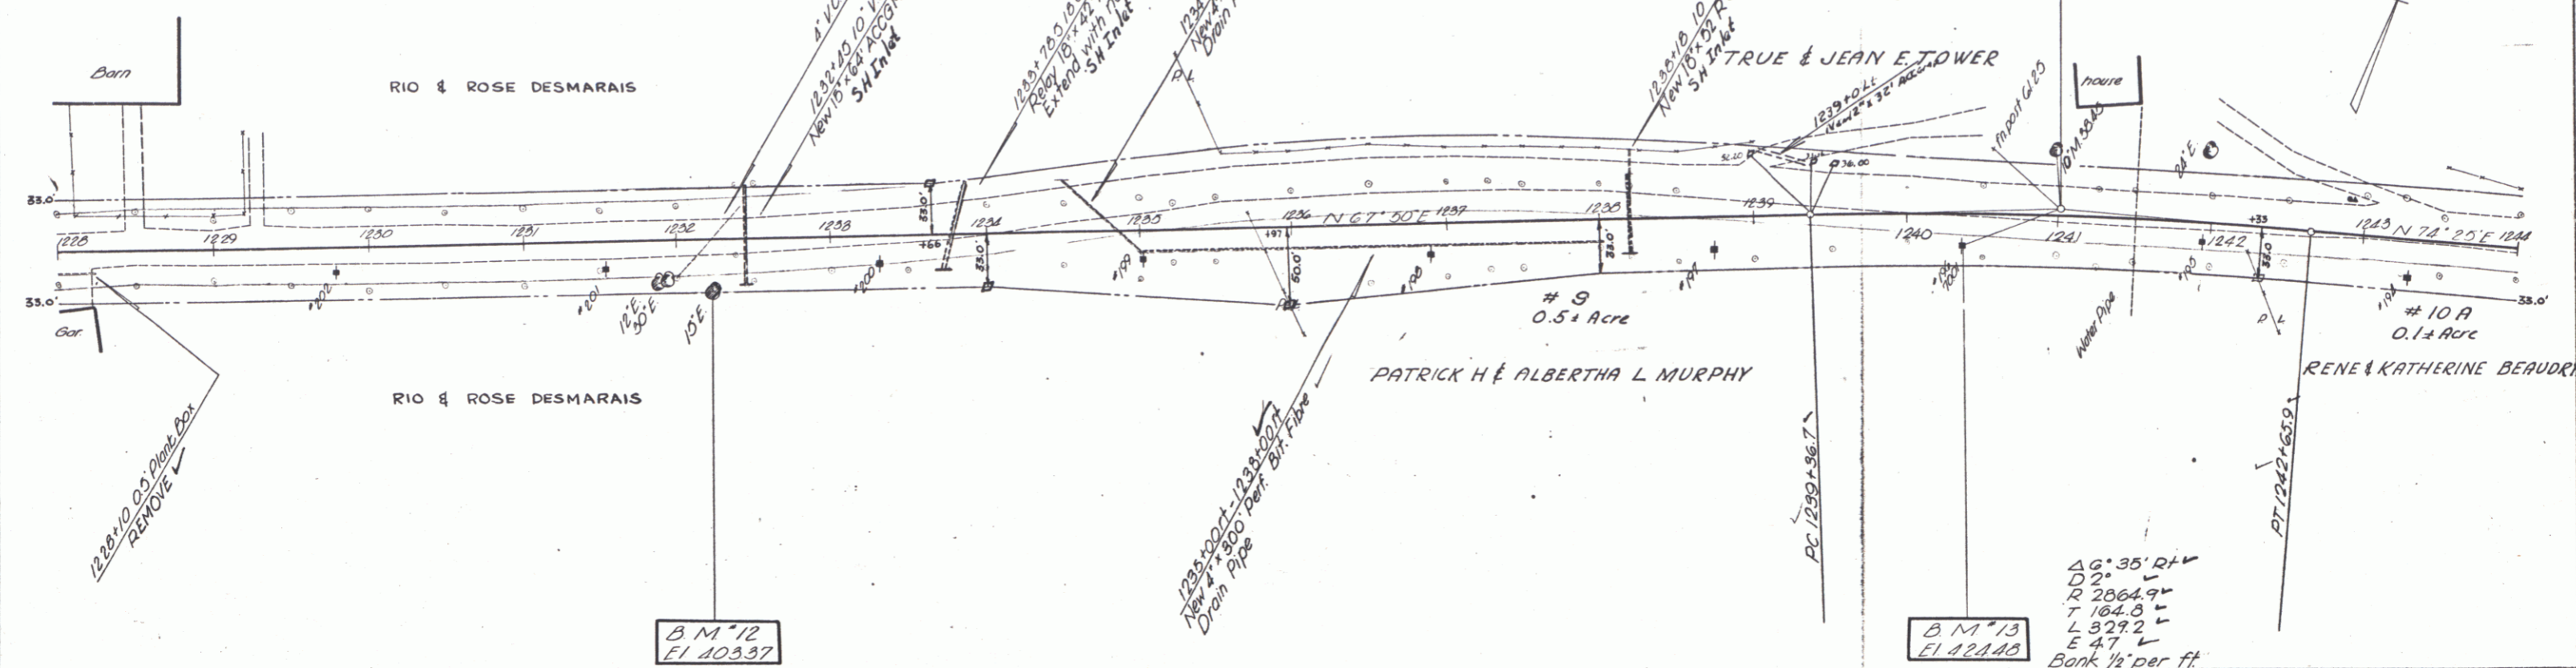

PLAN
 DRAWN BY: [Signature]
 CHECKED BY: [Signature]
 DATE: 11/22/53

PROFILE
 DRAWN BY: [Signature]
 CHECKED BY: [Signature]
 DATE: 11/22/53

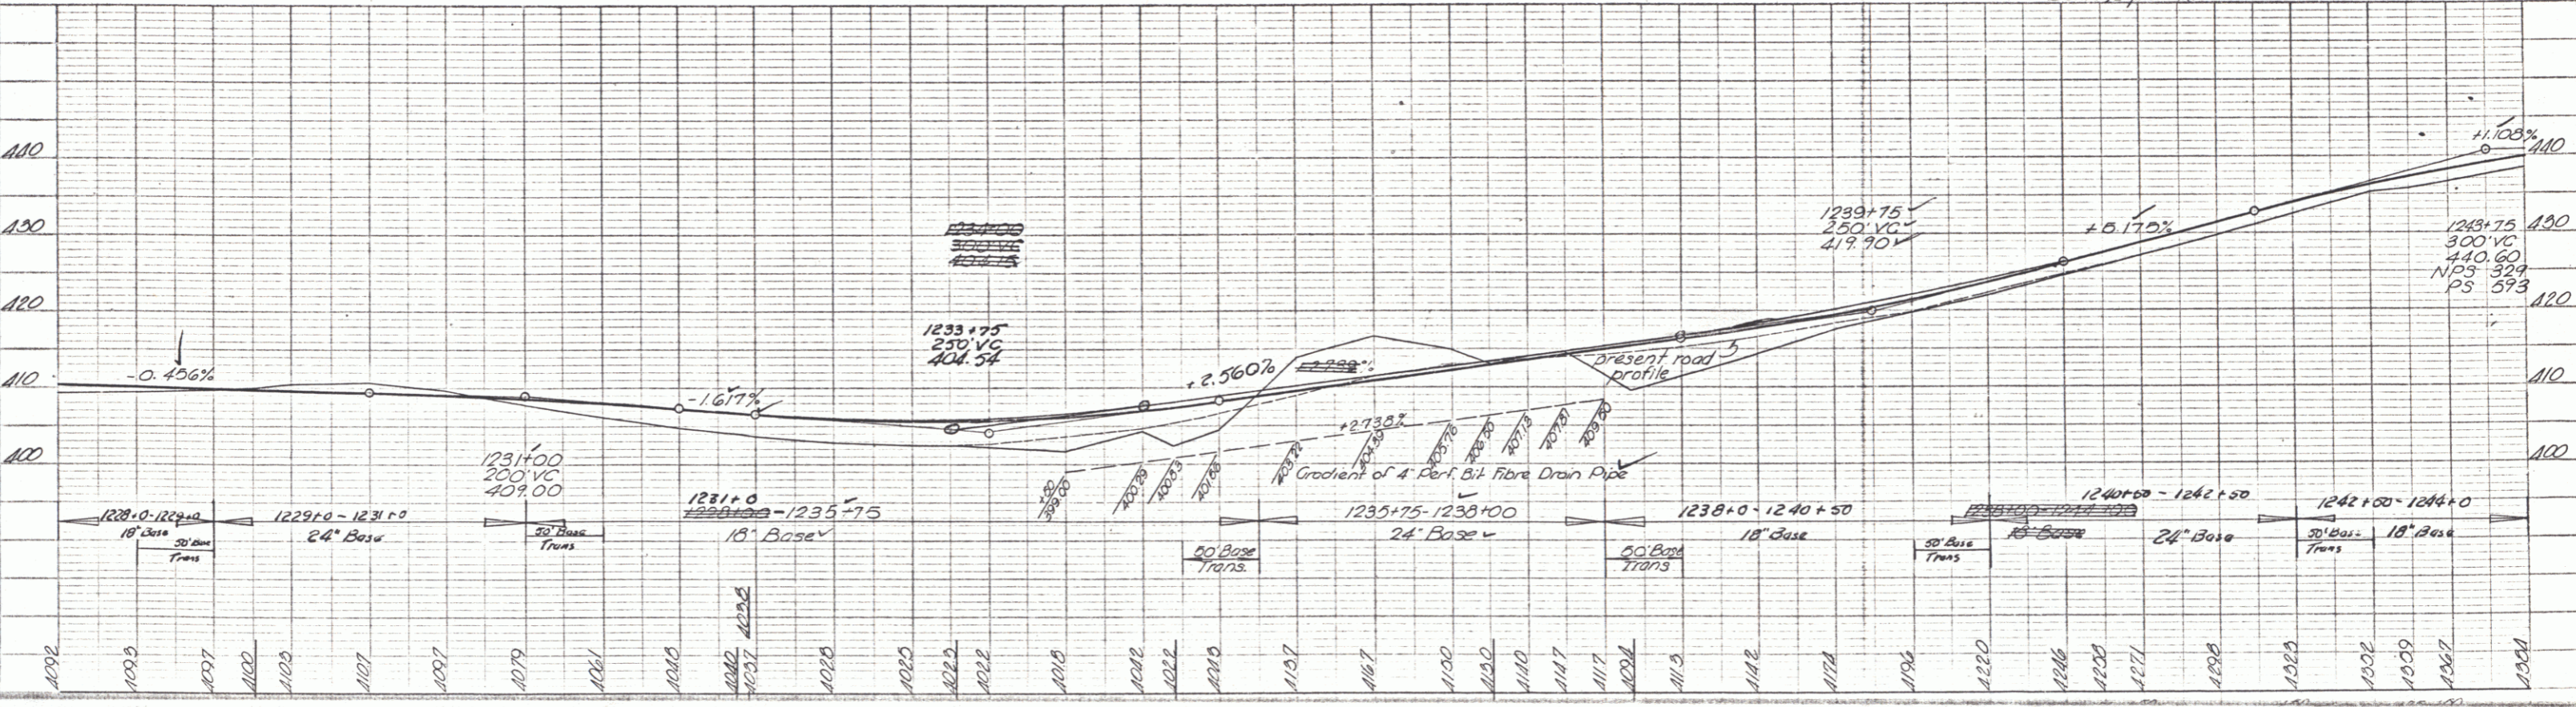


1228+00 1229+00 1230+00 1231+00 1232+00 1233+00 1234+00 1235+00 1236+00 1237+00 1238+00 1239+00 1240+00 1241+00 1242+00 1243+00 1244+00

B.M. #12 21 FT. 5th 1232+22 51 R 24' Elm Elevation 103.37
 B.M. #15 21 FT. 5th 1240+36 Spike in Power Pole 106 Elevation 124.18


ALBANY INASBURG
 Project 5 No. 166(A)
 Sheet 17 of 63

PLAN
 DATE: 4/28/22
 DRAWN BY: S. Palmer
 CHECKED BY: R. Palmer
 NO. 21

PROFILE
 DATE: 4/28/22
 DRAWN BY: S. Palmer
 CHECKED BY: R. Palmer
 NO. 21

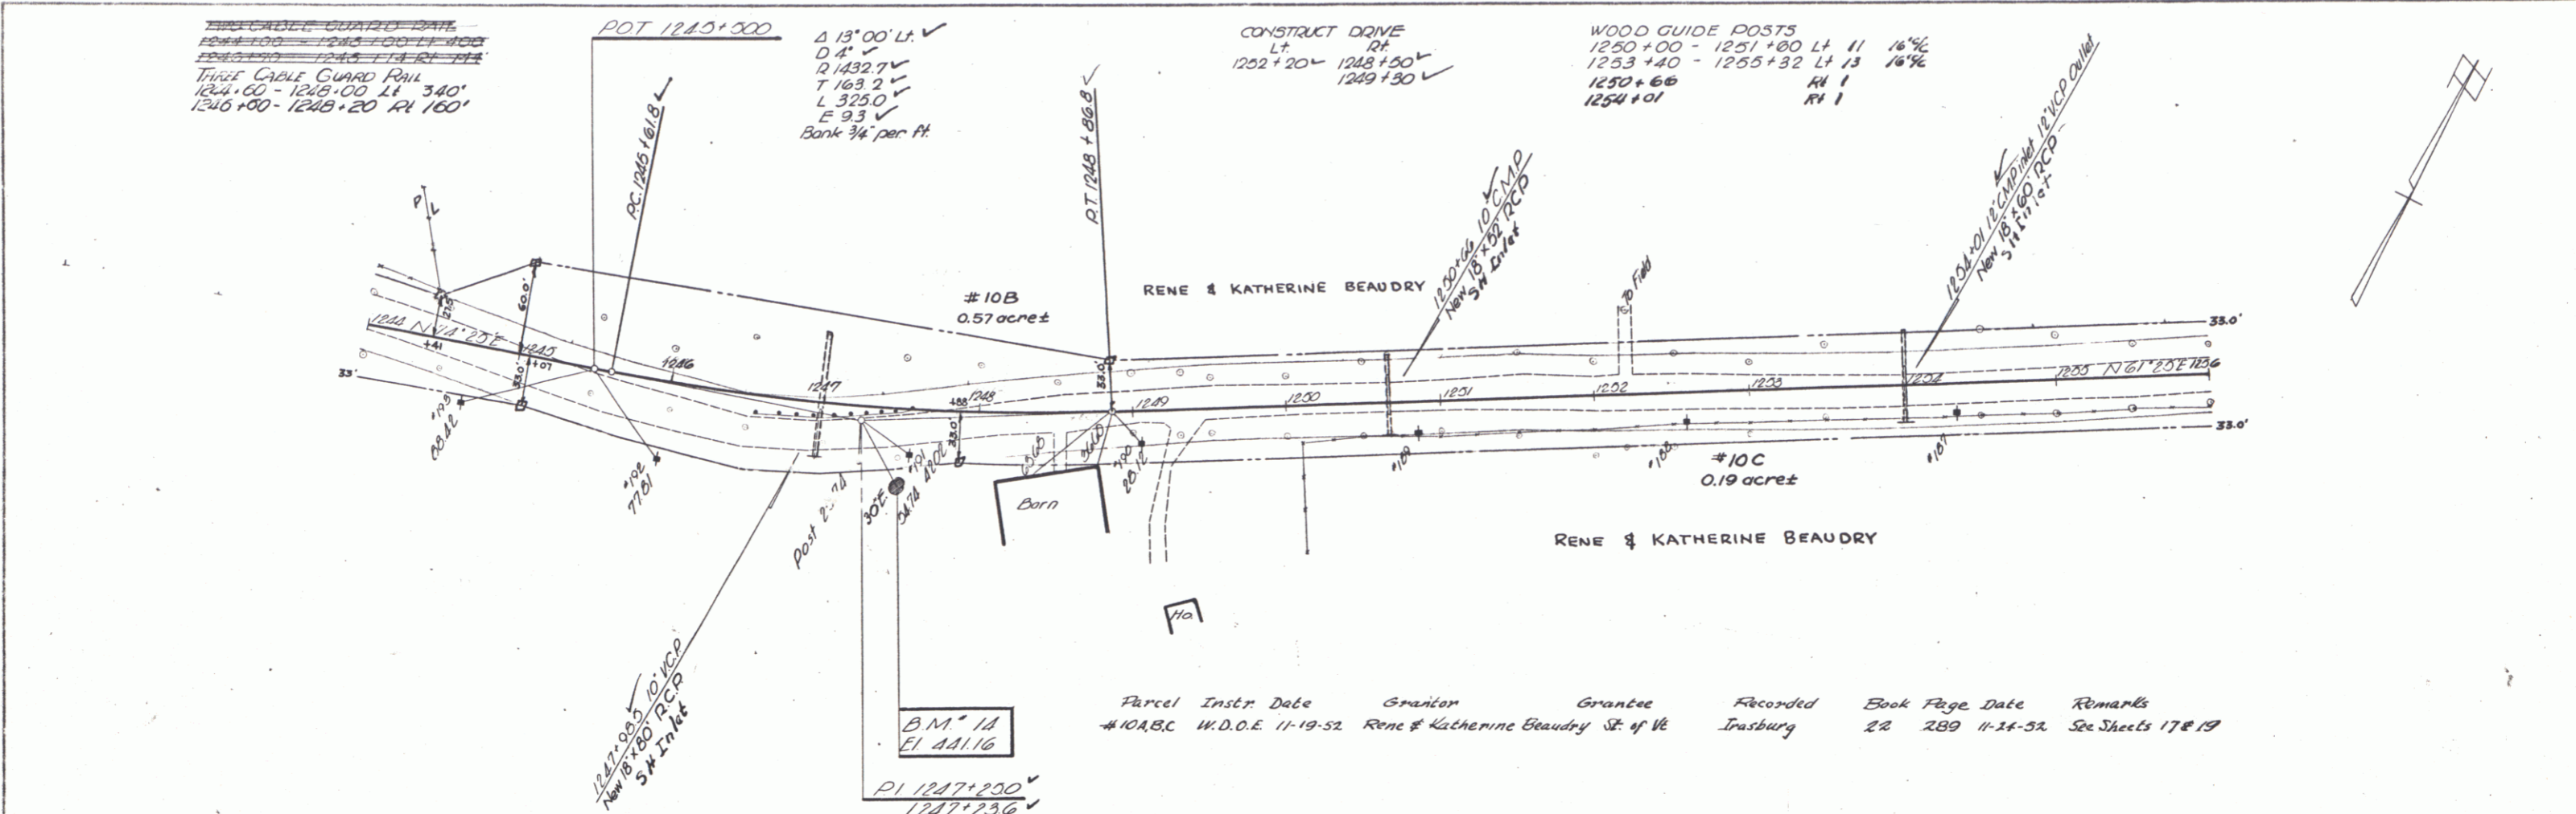


Parcel	Instr.	Date	Grantor	Grantee	Recorded	Book	Page	Date	Remarks
#10A,B,C	W.D.O.E.	11-19-52	Rene & Katherine Beaudry	St. of W	Insbury	22	289	11-14-52	See Sheets 17 & 19

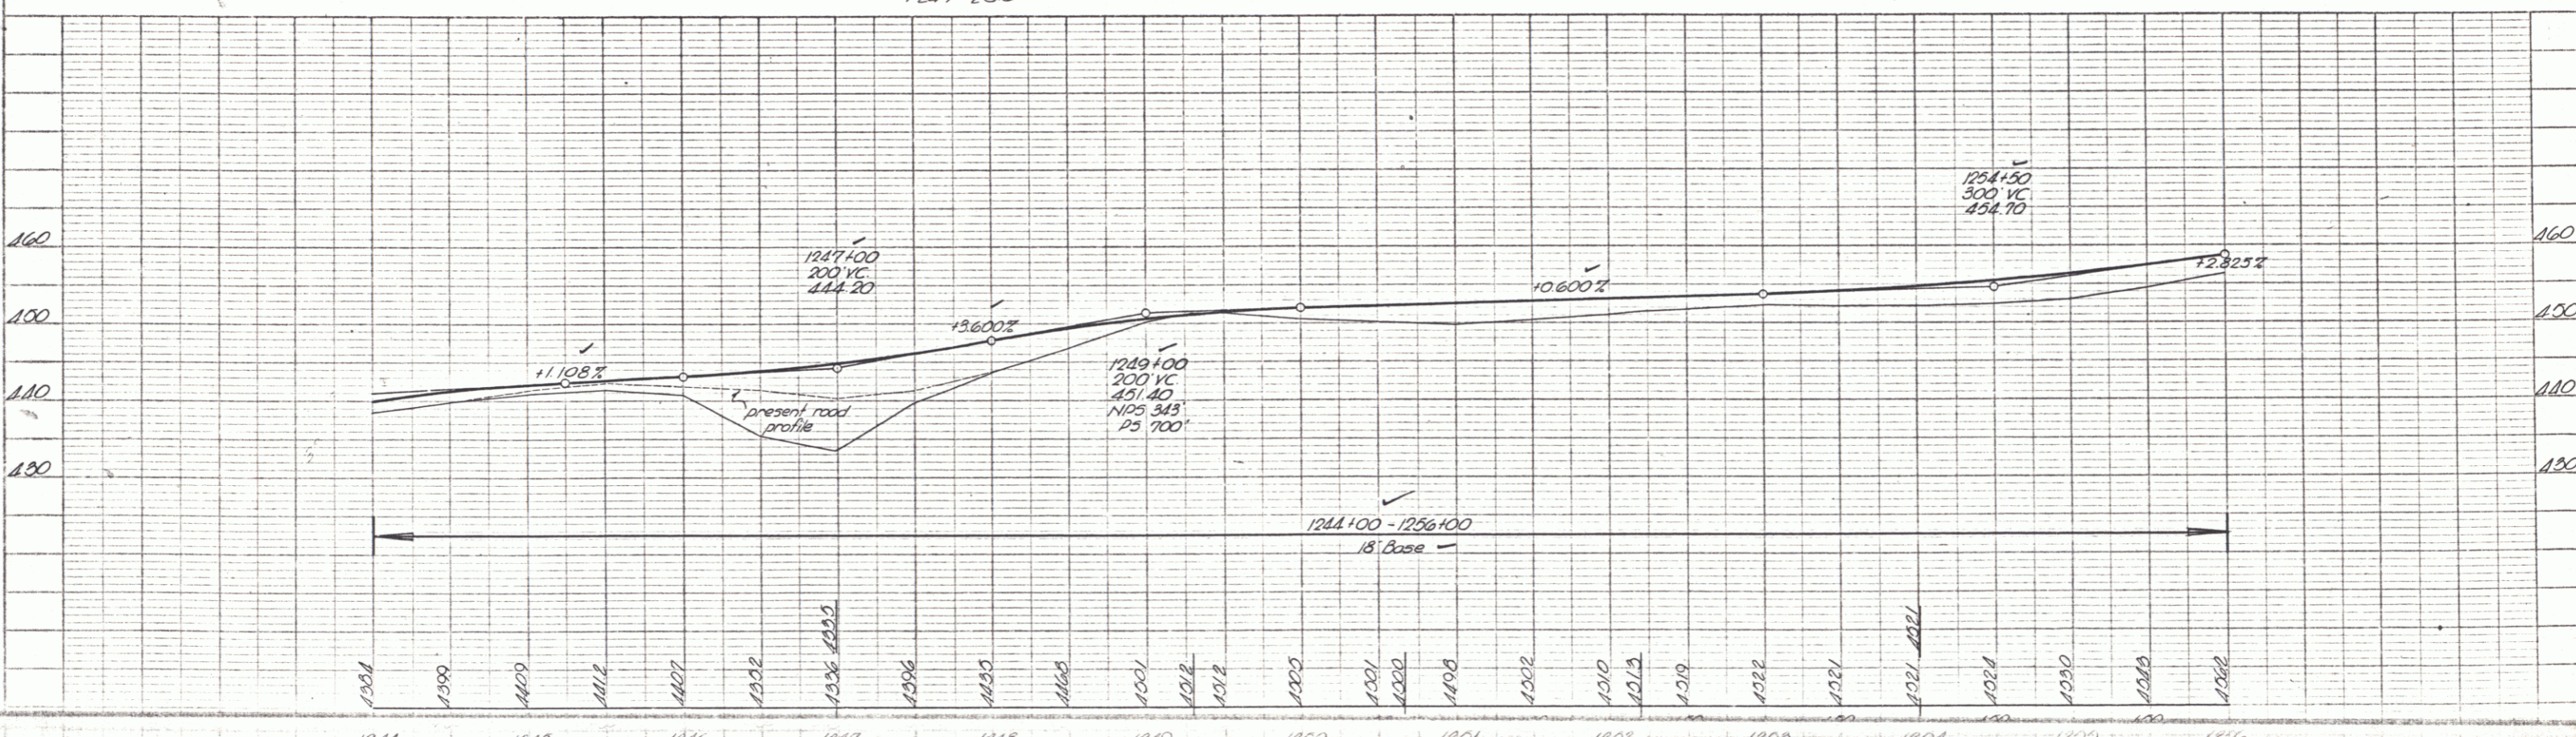


B.M. 14 51 FT RT 516 1247+00 51R 20' Elm Elev 441.16

ALBANY-TRASBURG
 Project 5 No 166(21)
 Sheet 18 of 63

PLATE 1 - PLAN PROFILE
 REVISED & RECORDED
 SCALE: 1" = 40'

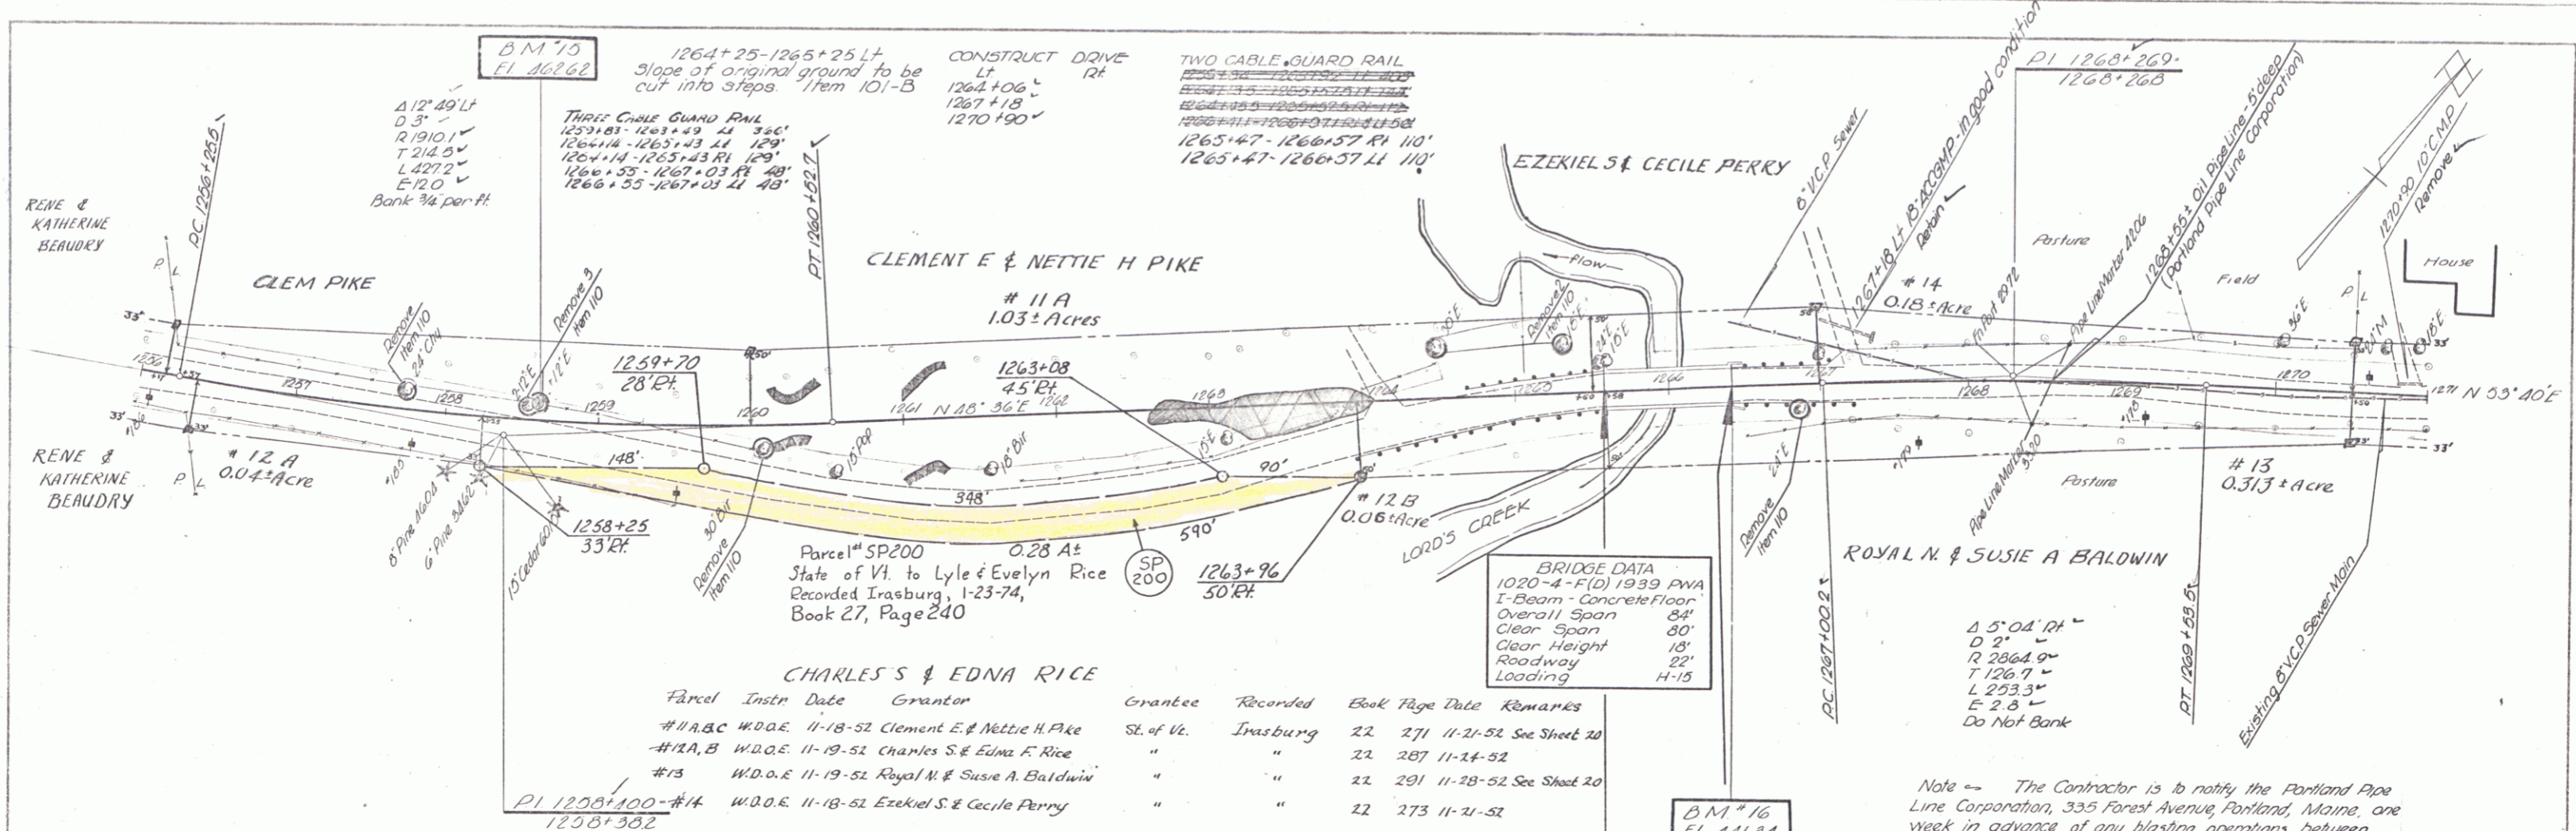

Parcel	Instr	Date	Grantor	Grantee	Recorded	Book	Page	Date	Remarks
#11A,B,C	W.D.O.E.	11-18-52	Clement E & Nettie H. Pike	St. of Vt.	Irasburg	22	271	11-21-52	See Sheet 20
#12A,B	W.D.O.E.	11-19-52	Charles S & Edna F. Rice	"	"	22	287	11-24-52	"
#13	W.D.O.E.	11-19-52	Royal M & Susie A. Baldwin	"	"	22	291	11-28-52	See Sheet 20
PI 1258+100 - #14	W.D.O.E.	11-18-52	Ezekiel S & Cecile Perry	"	"	22	273	11-21-52	"


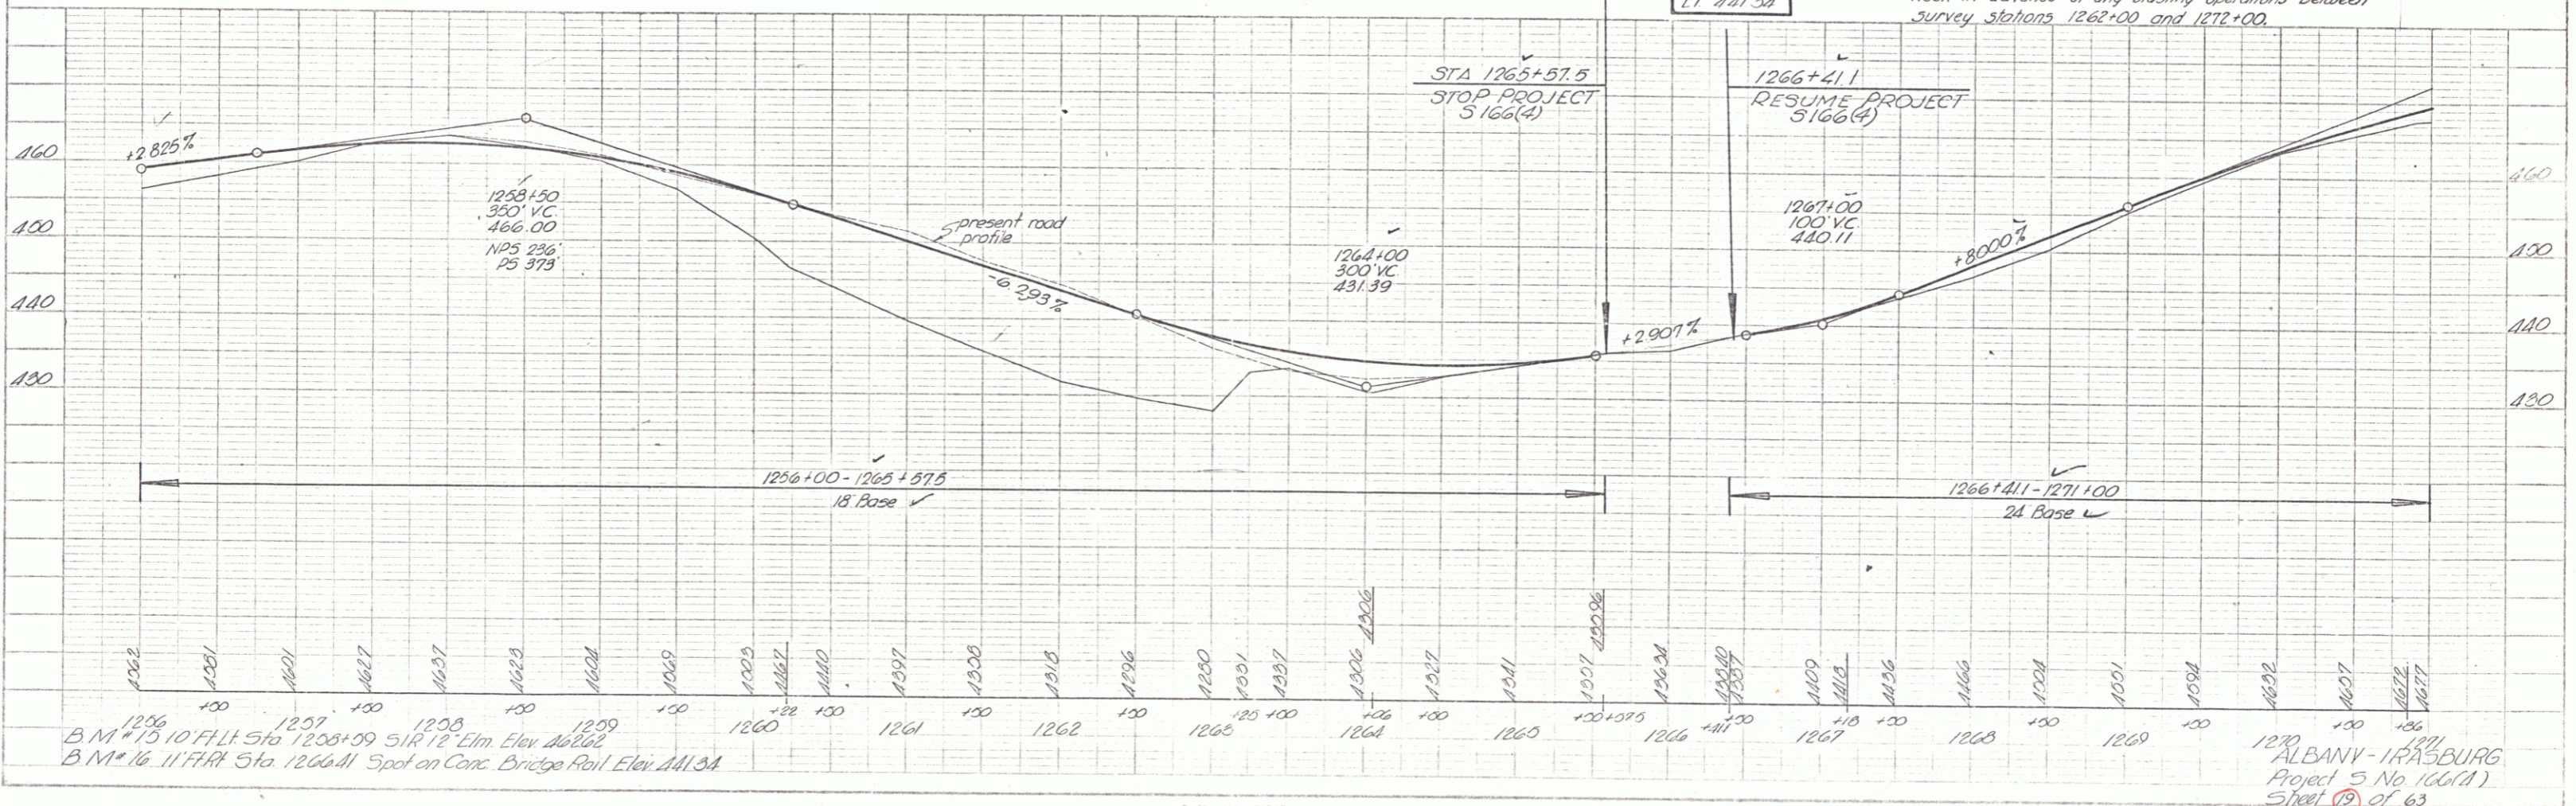


Project: Albany - Irasburg
 Sheet: 19 of 63
 Date: 11/28/52
 Author: Palmer

Project: Albany - Irasburg
 Sheet: 19 of 63
 Date: 11/28/52
 Author: Palmer

B.M. #10 F.I.T. Sta 1256+09 51R 12' Elm. Elev 462.62
 B.M. #16 11' F.I.T. Sta 1266+11 Spot on Conc. Bridge Rail Elev 441.34

ALBANY - IRASBURG
 Project 5 No 106(1)
 Sheet 19 of 63

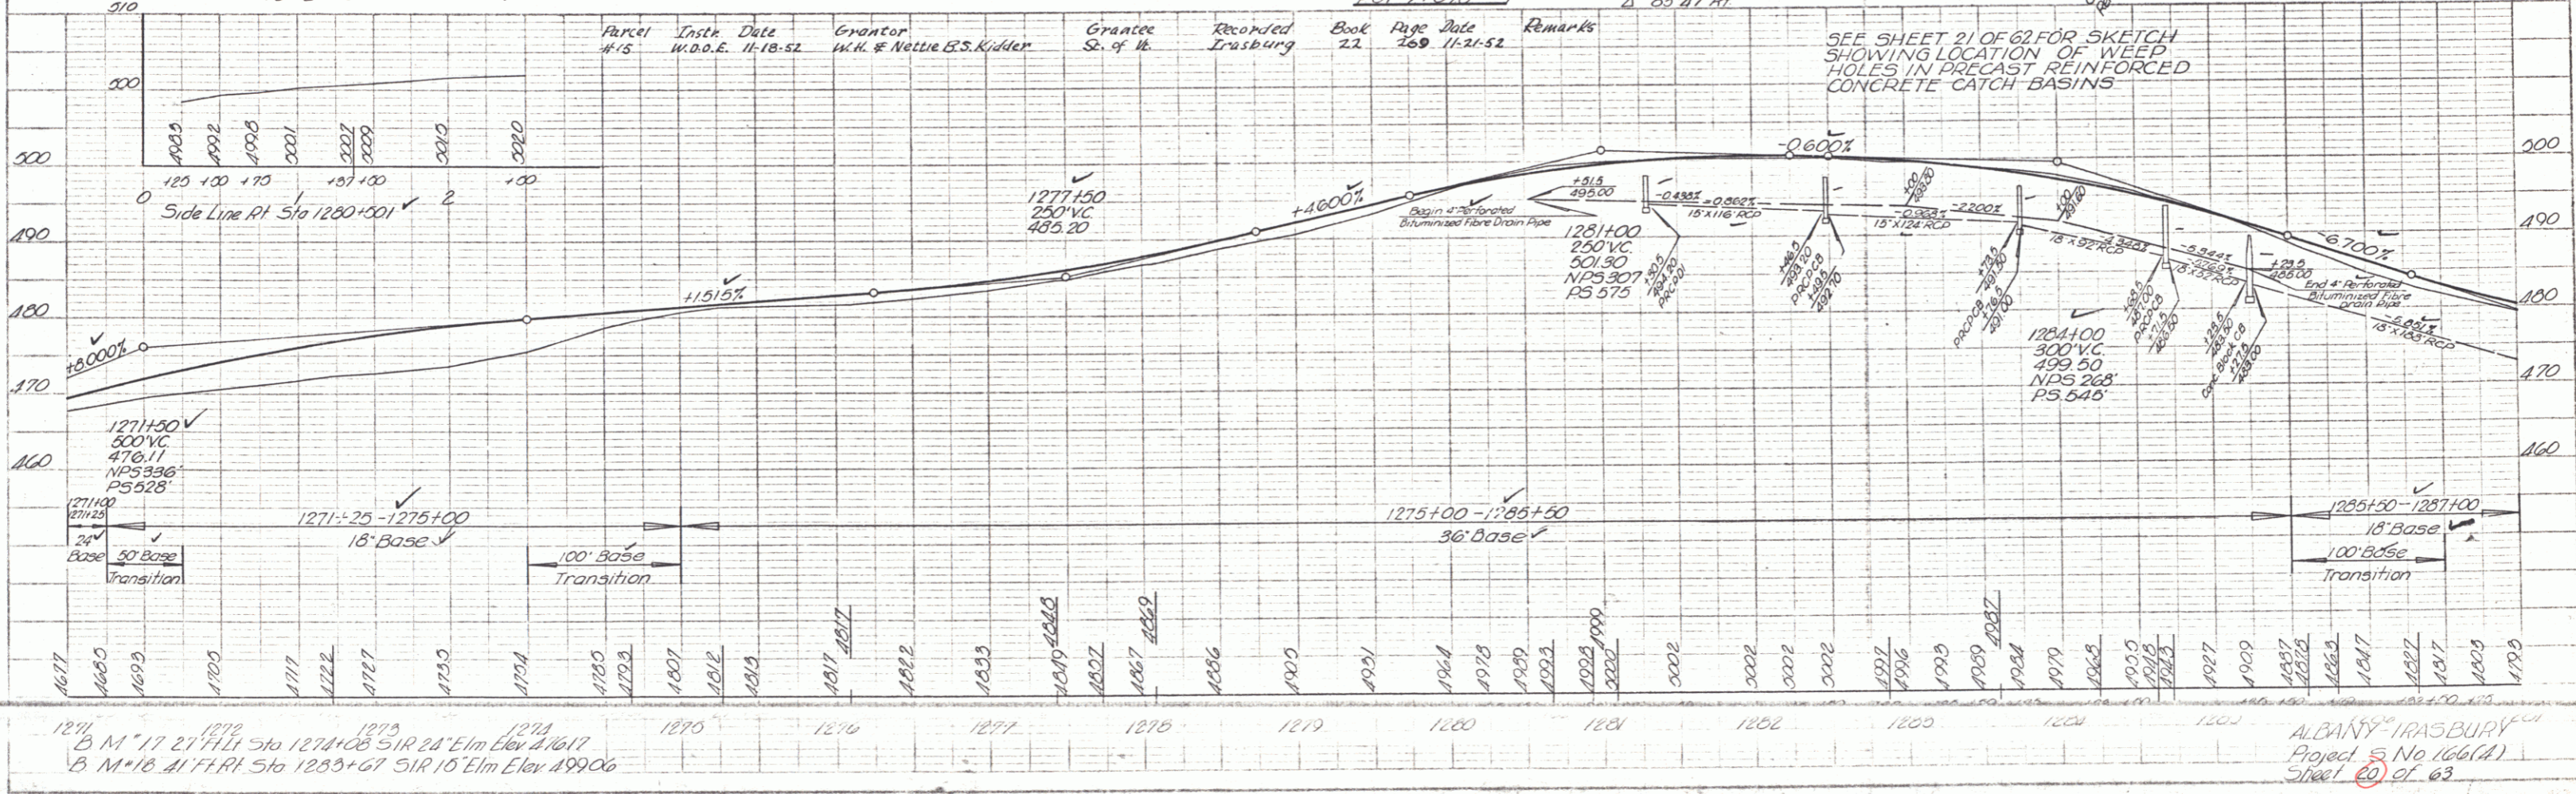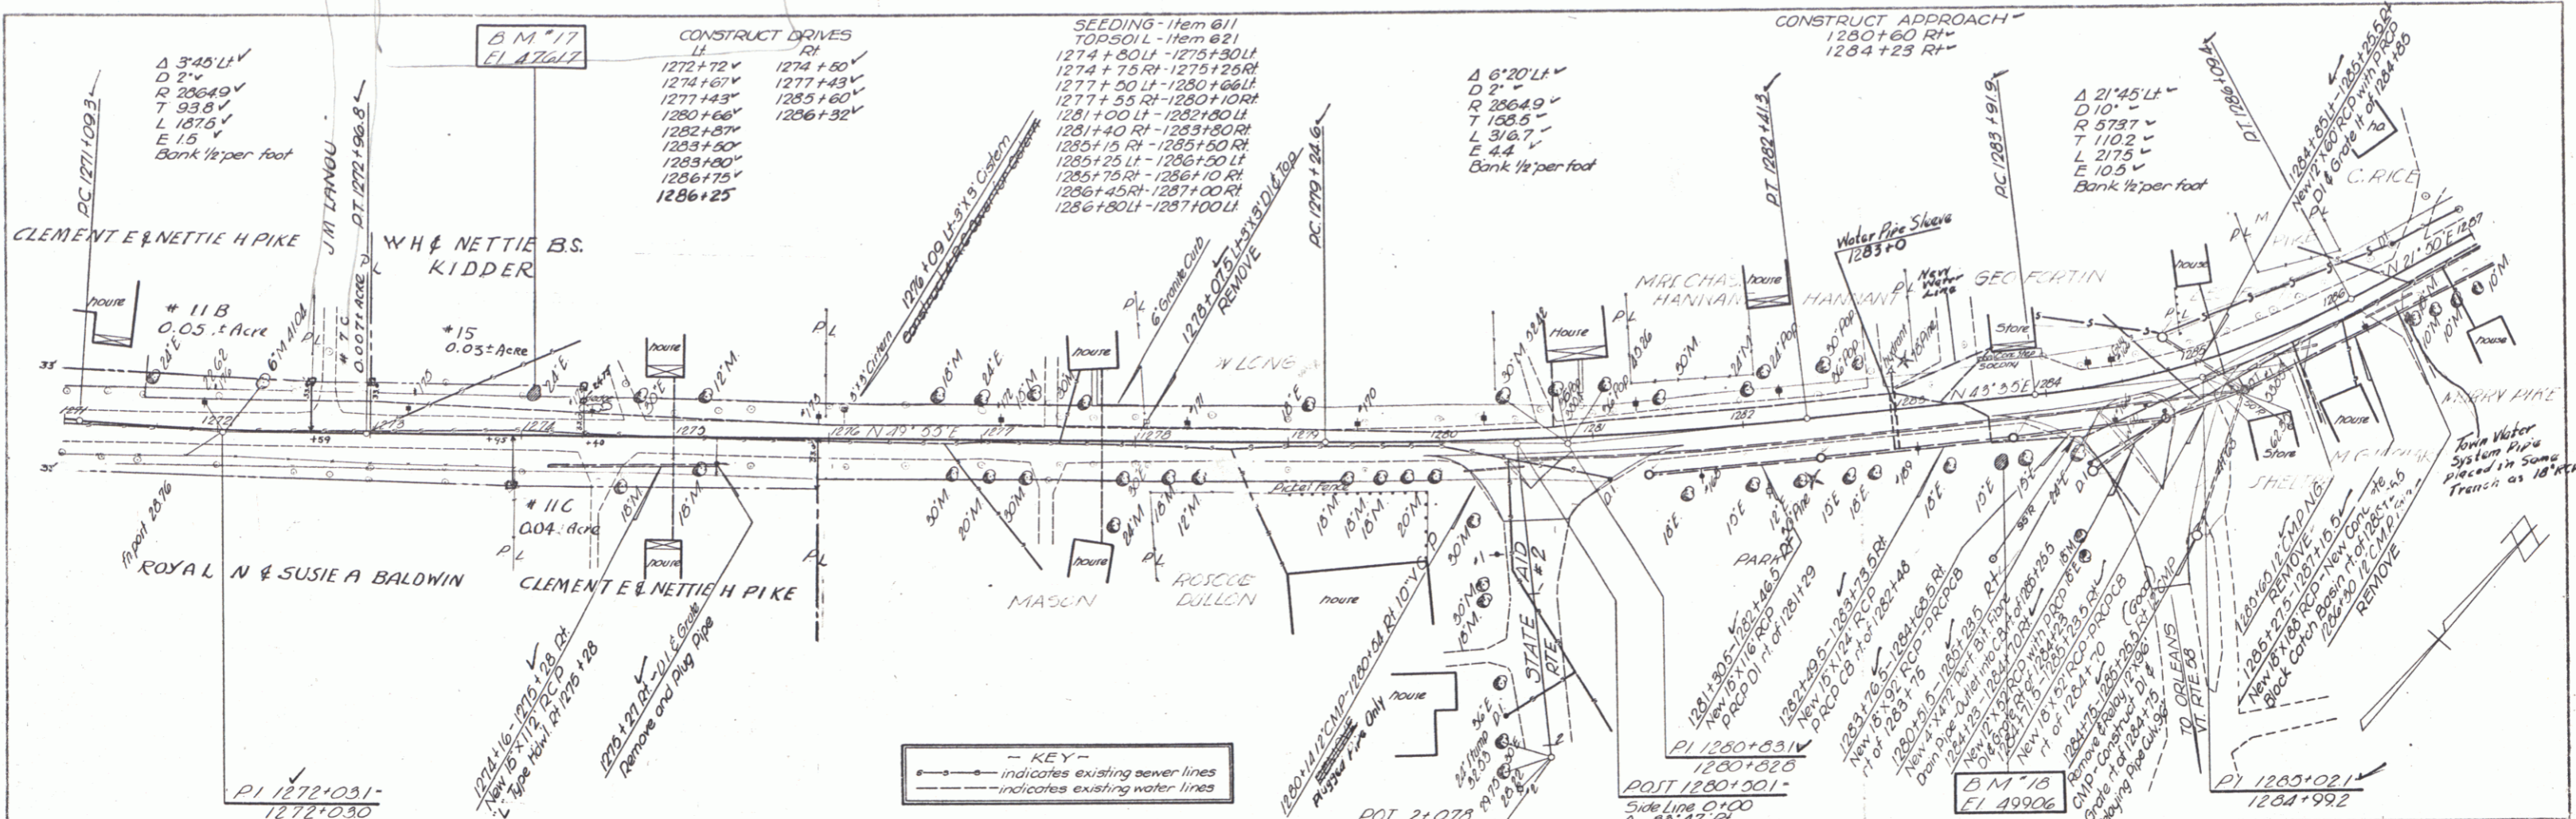

PLAN
DATE: 11/21/52
BY: J. PALMER

PROFILE
DATE: 11/21/52
BY: J. PALMER

1274 B.M. 17 27' Ht. 5 to 1274+00 S.I.R. 24' Elm. Elev. 476.17
 1275 B.M. 16 41' Ht. 5 to 1283+67 S.I.R. 15' Elm. Elev. 499.06

ALBANY GRASBURY
 Project No. 166(A)
 Sheet 20 of 63

