
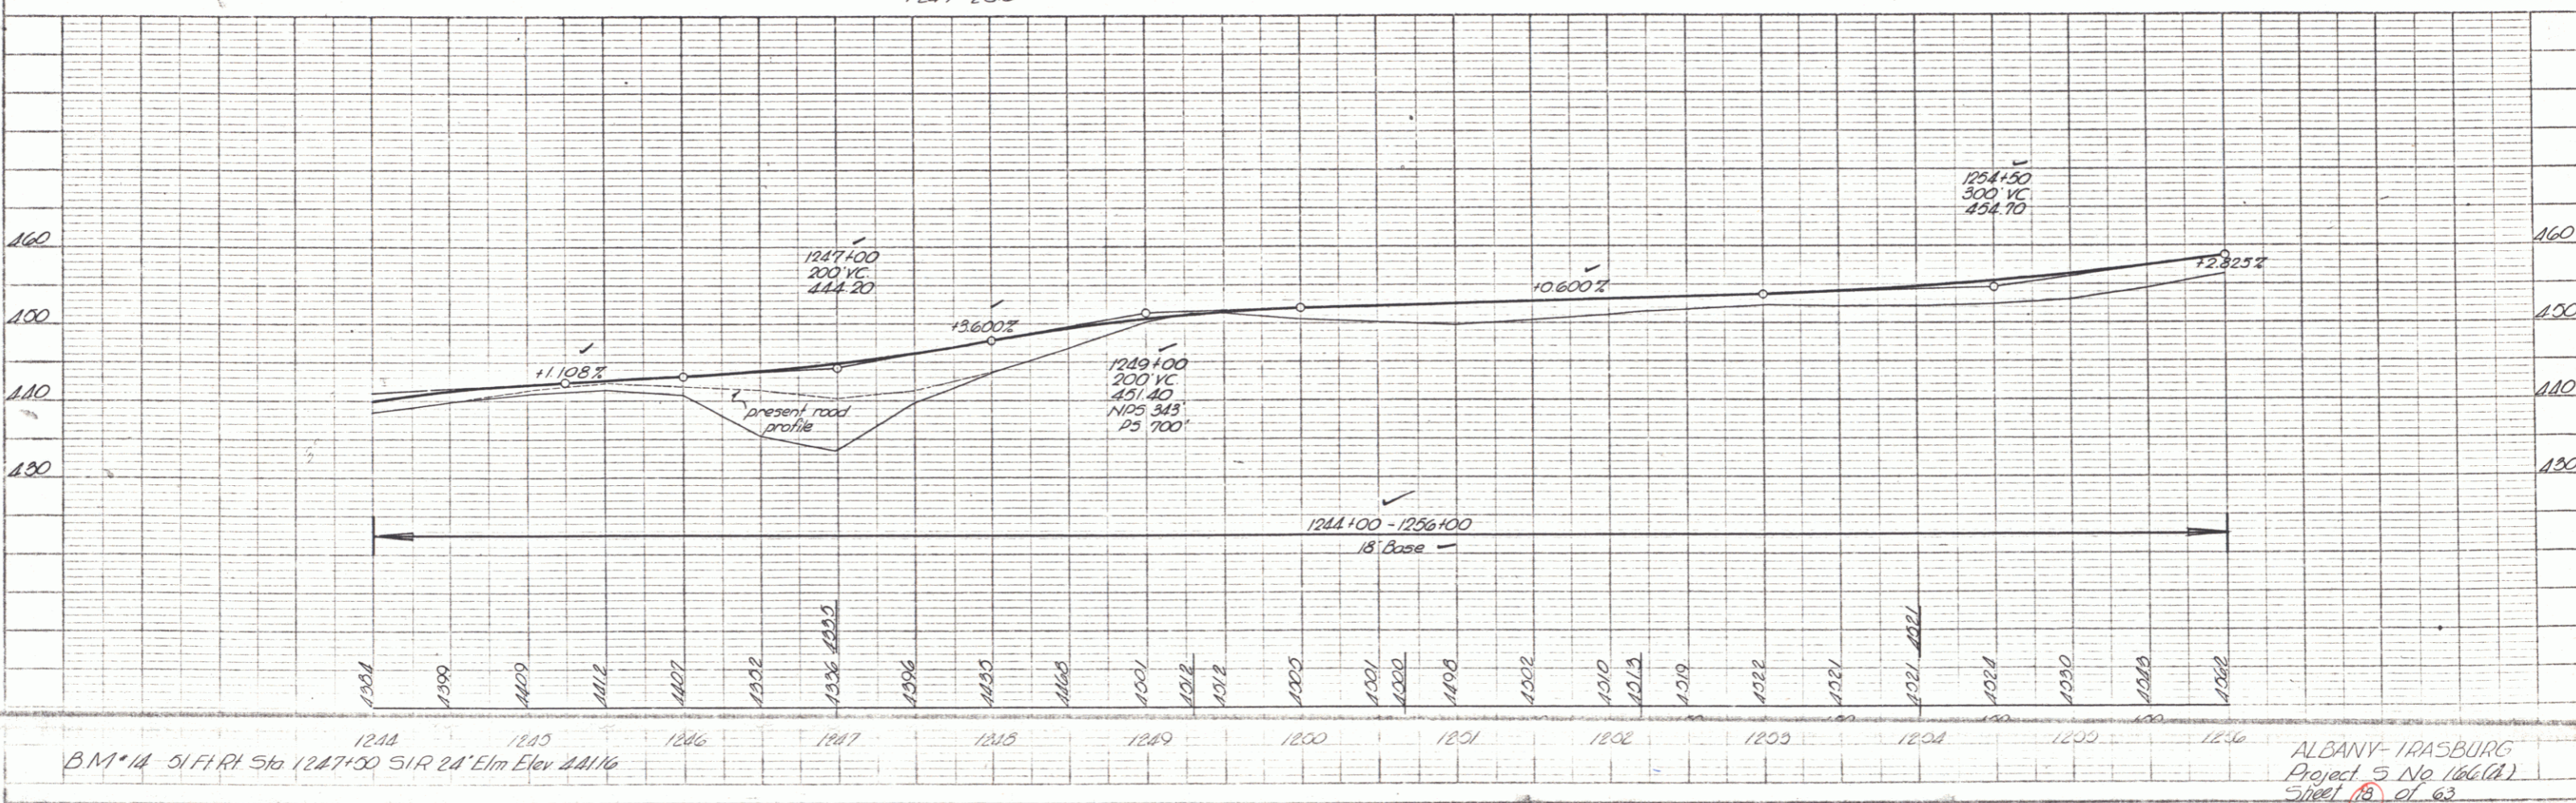


PLAN
 DATE: 4/28/22
 DRAWN BY: S. J. Palmer
 CHECKED BY: S. J. Palmer
 NO. 21

PROFILE
 DATE: 4/28/22
 DRAWN BY: S. J. Palmer
 CHECKED BY: S. J. Palmer
 NO. 21

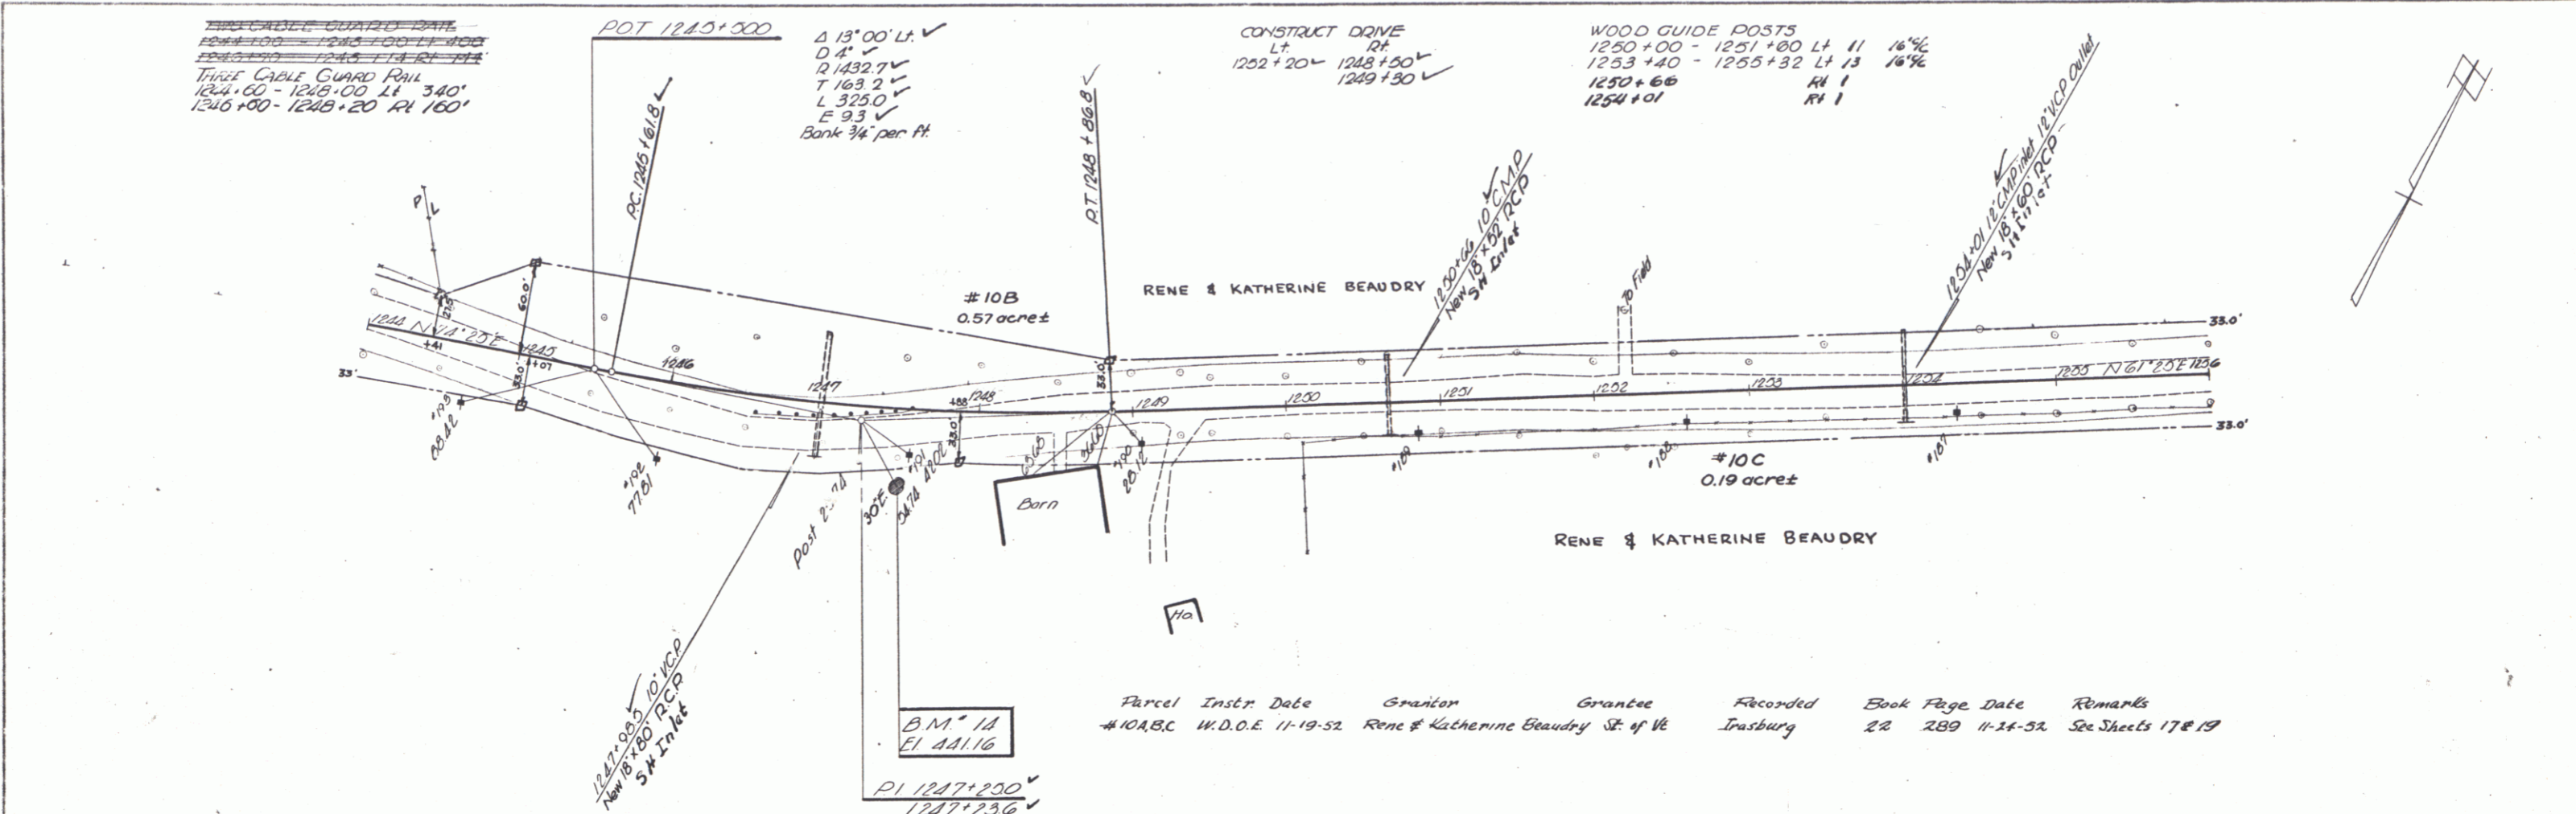

ALBANY-TRASBURG
 Project 5 No 166(21)
 Sheet 18 of 63

PLATE 1 - PLAN PROFILE
 REVISED & RECORDED
 SCALE: 1" = 40'