
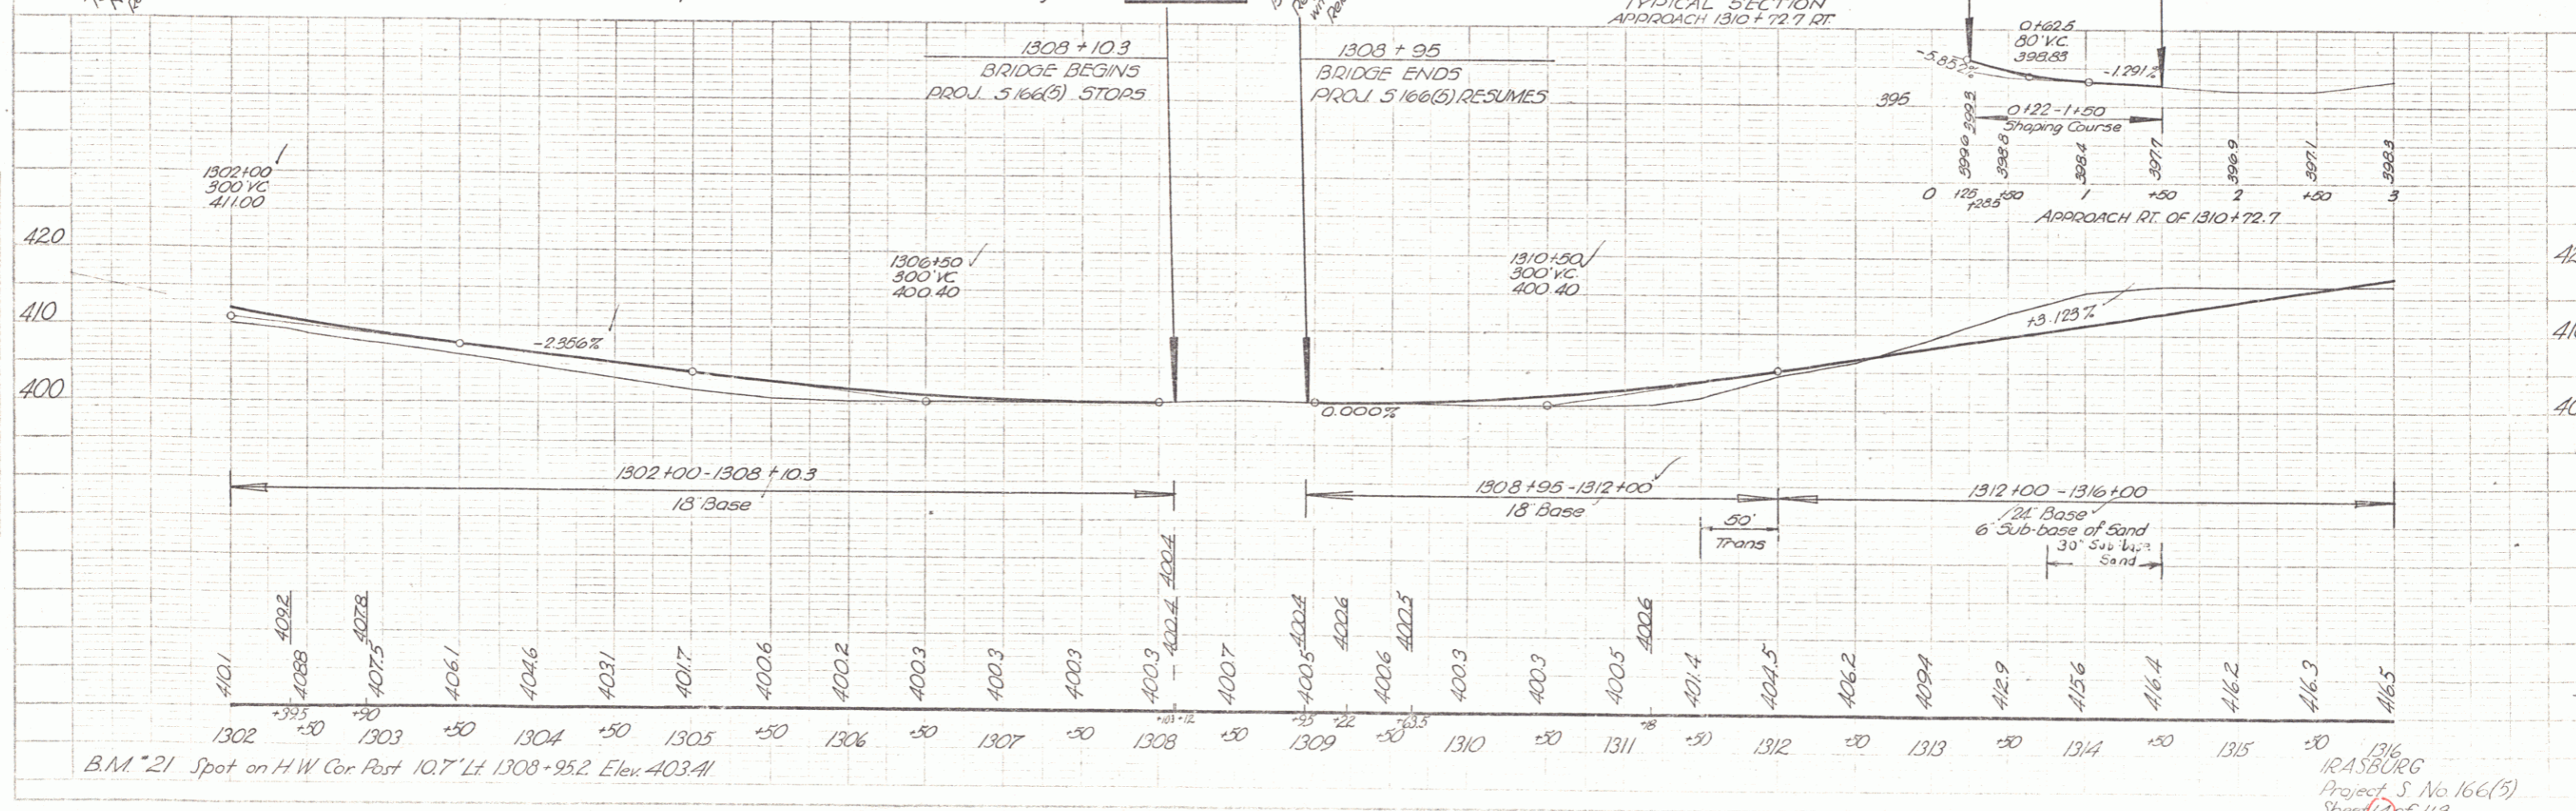


402
403
404
402
403
404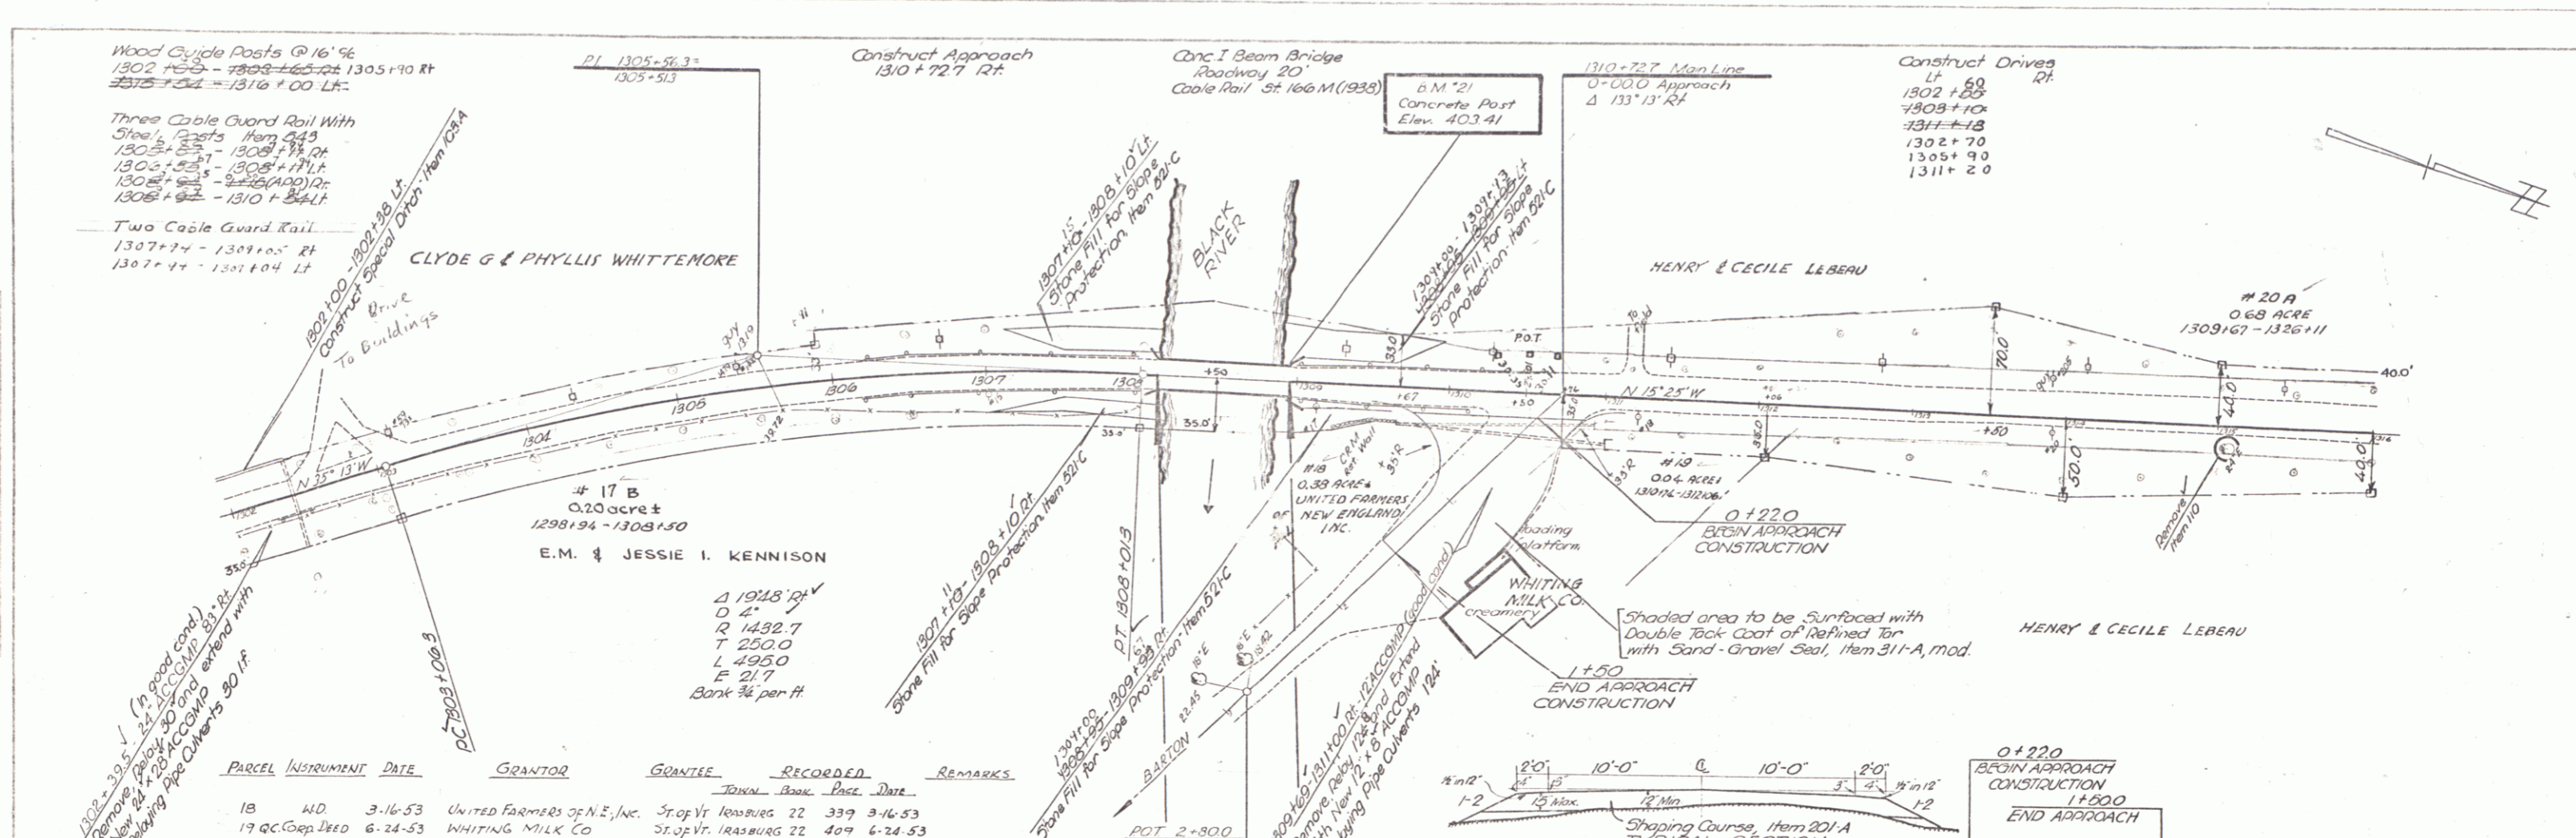
B.M. "21" Spot on H W Cor Post 10.7' Lt 1308+95.2 Elev. 403.41

1316
IRASBURG
Project S No 166(5)
Sheet 3 of 113