


PLAN
 DATE 10/15/53
 DRAWN BY H. H. HARRIS
 CHECKED BY J. W. HARRIS
 TITLE
 ROADWAY
 FROM
 TO
 SHEET NO. 113 OF 113



PROFILE
 DATE 10/15/53
 DRAWN BY H. H. HARRIS
 CHECKED BY J. W. HARRIS
 TITLE
 ROADWAY
 FROM
 TO
 SHEET NO. 113 OF 113

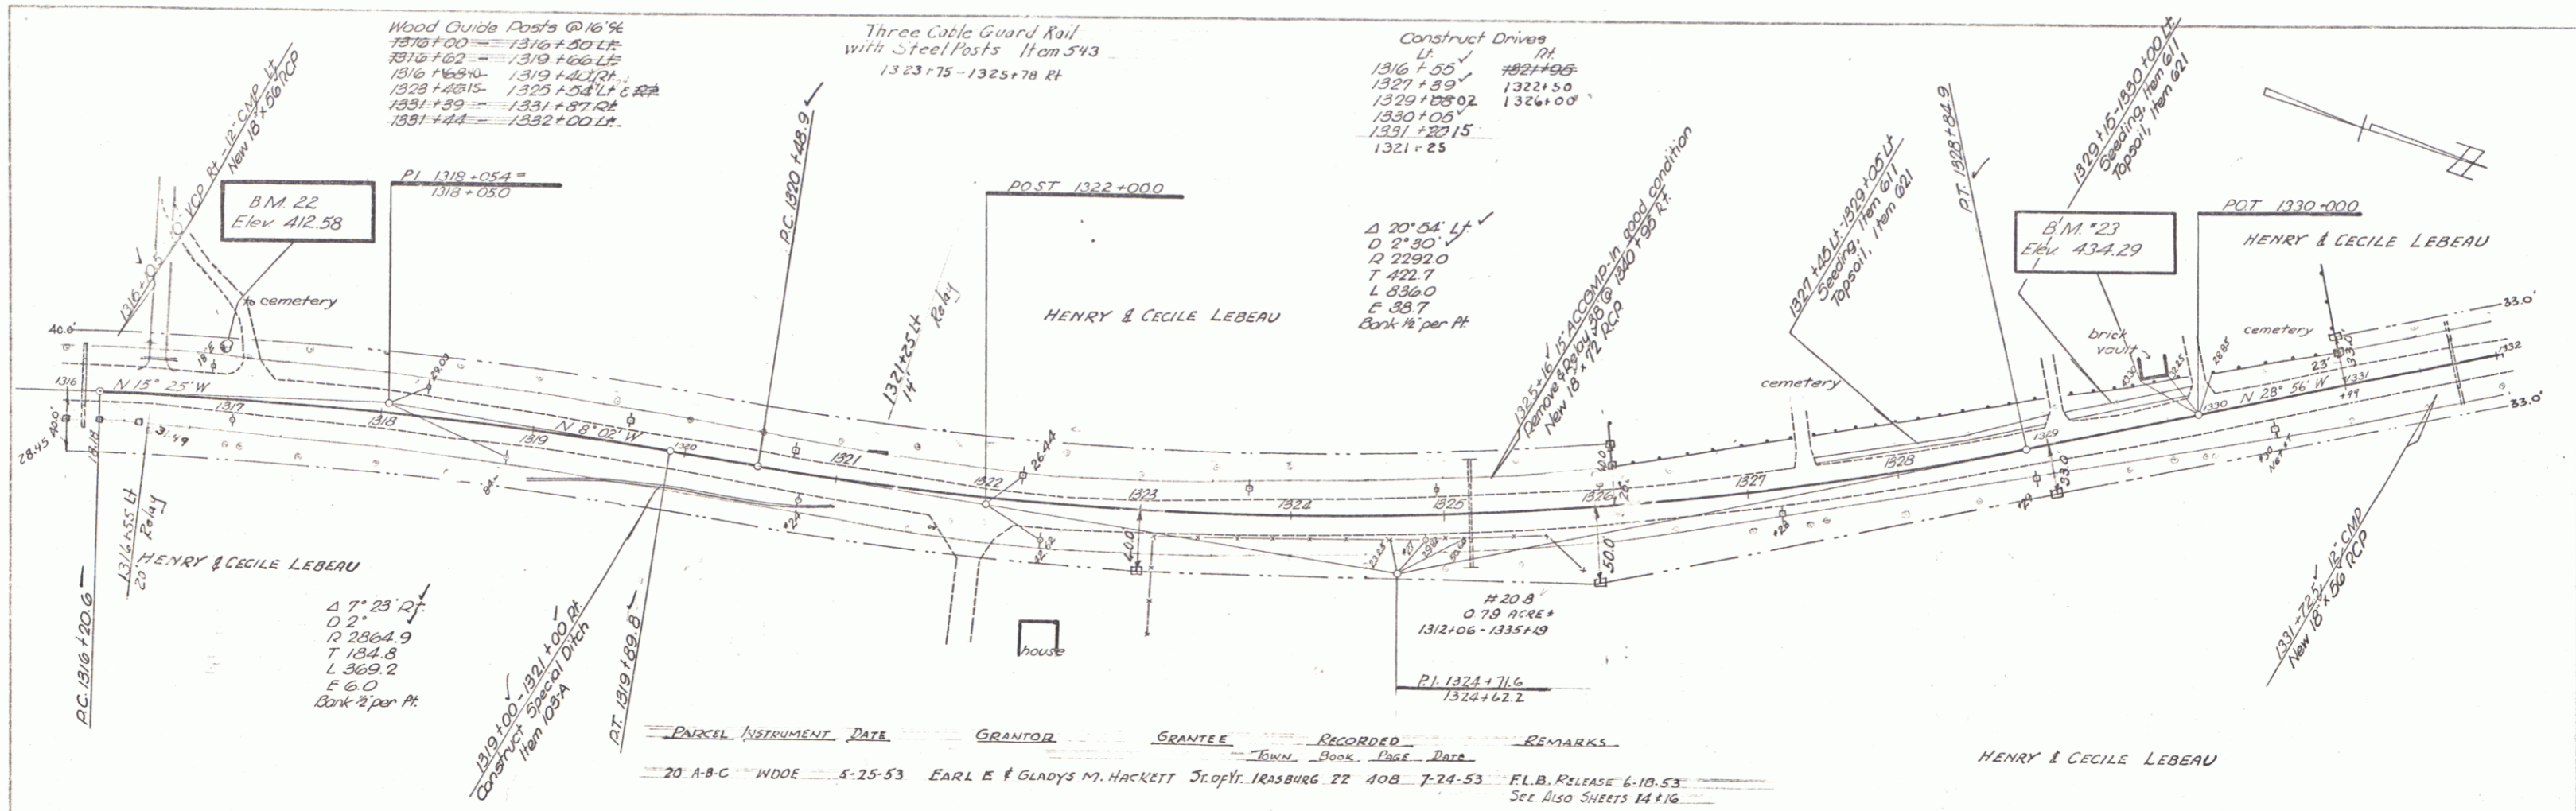