
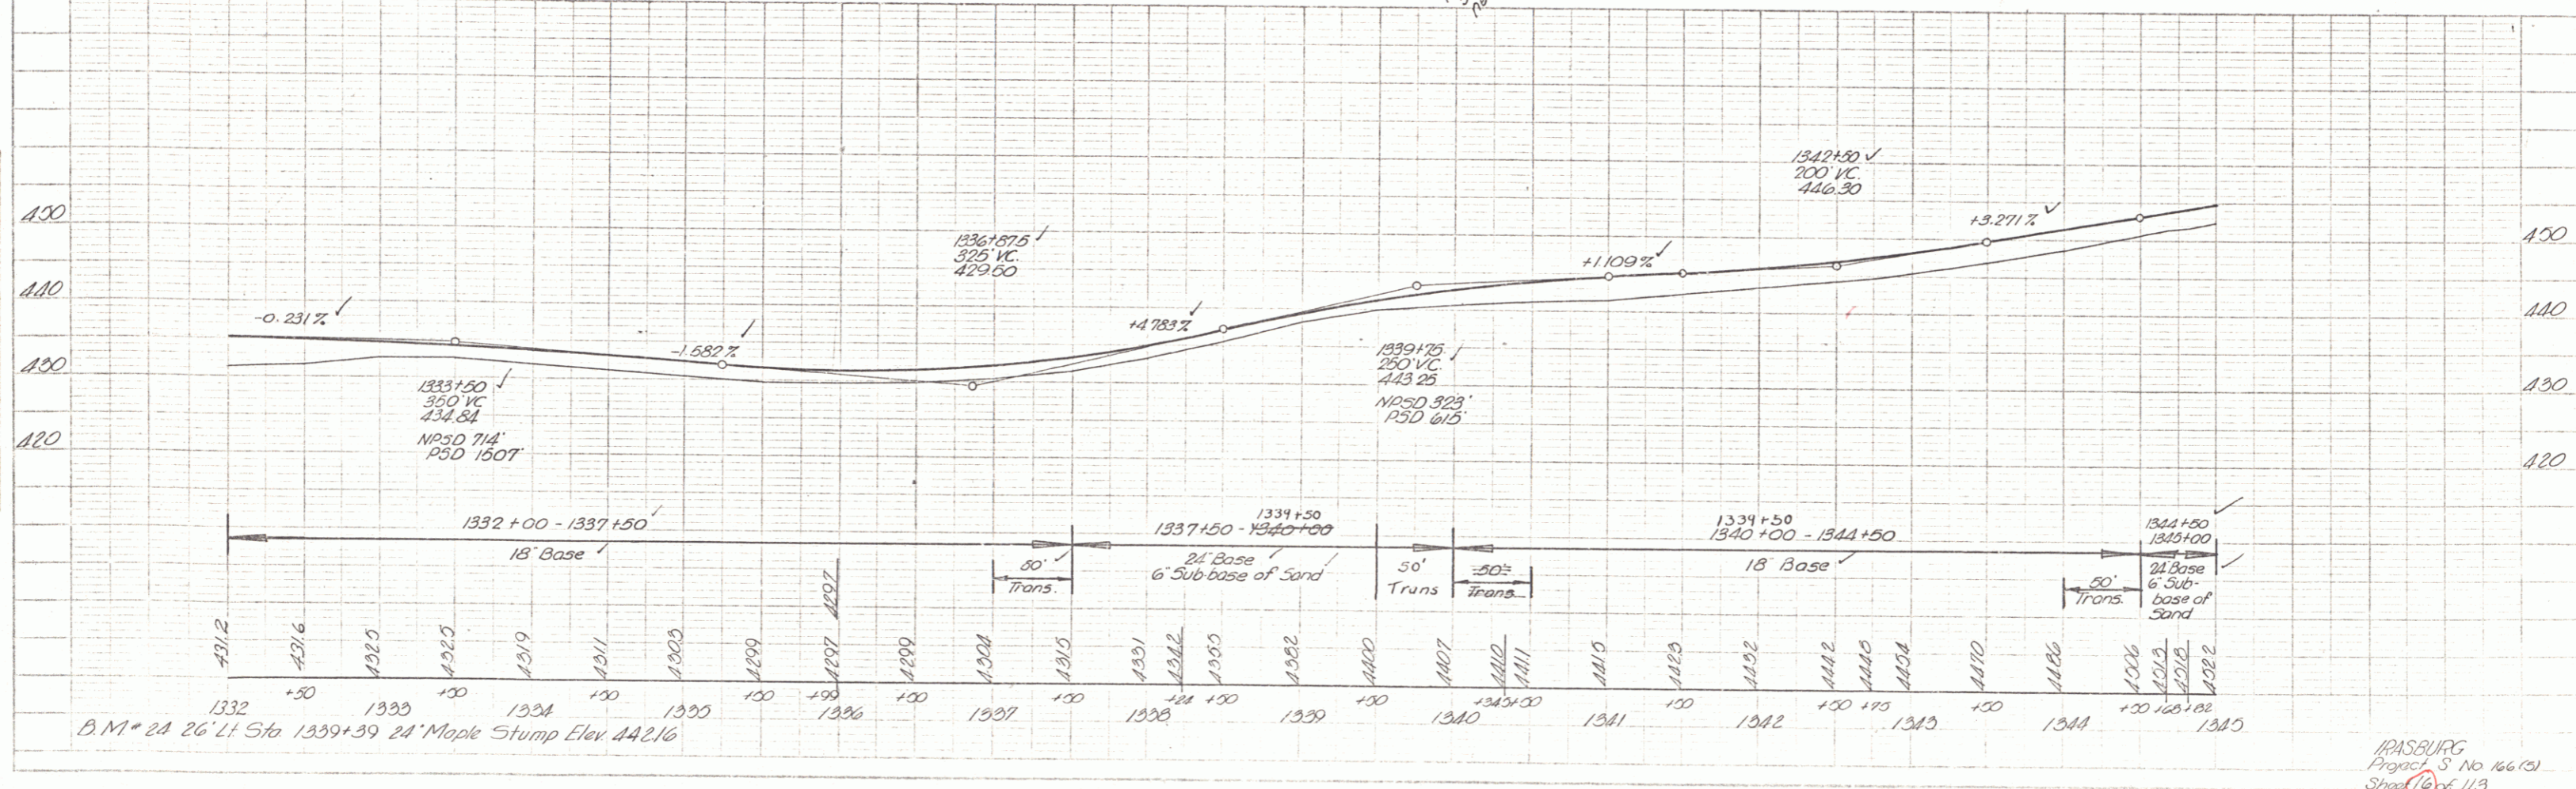


PLAN
 DATE 5/1/53
 DRAWN BY S. J. POLMER
 CHECKED BY S. J. POLMER
 TITLE SHEET NO. 113

TOPIC
 DATE 5/1/53
 DRAWN BY S. J. POLMER
 CHECKED BY S. J. POLMER
 TITLE SHEET NO. 113

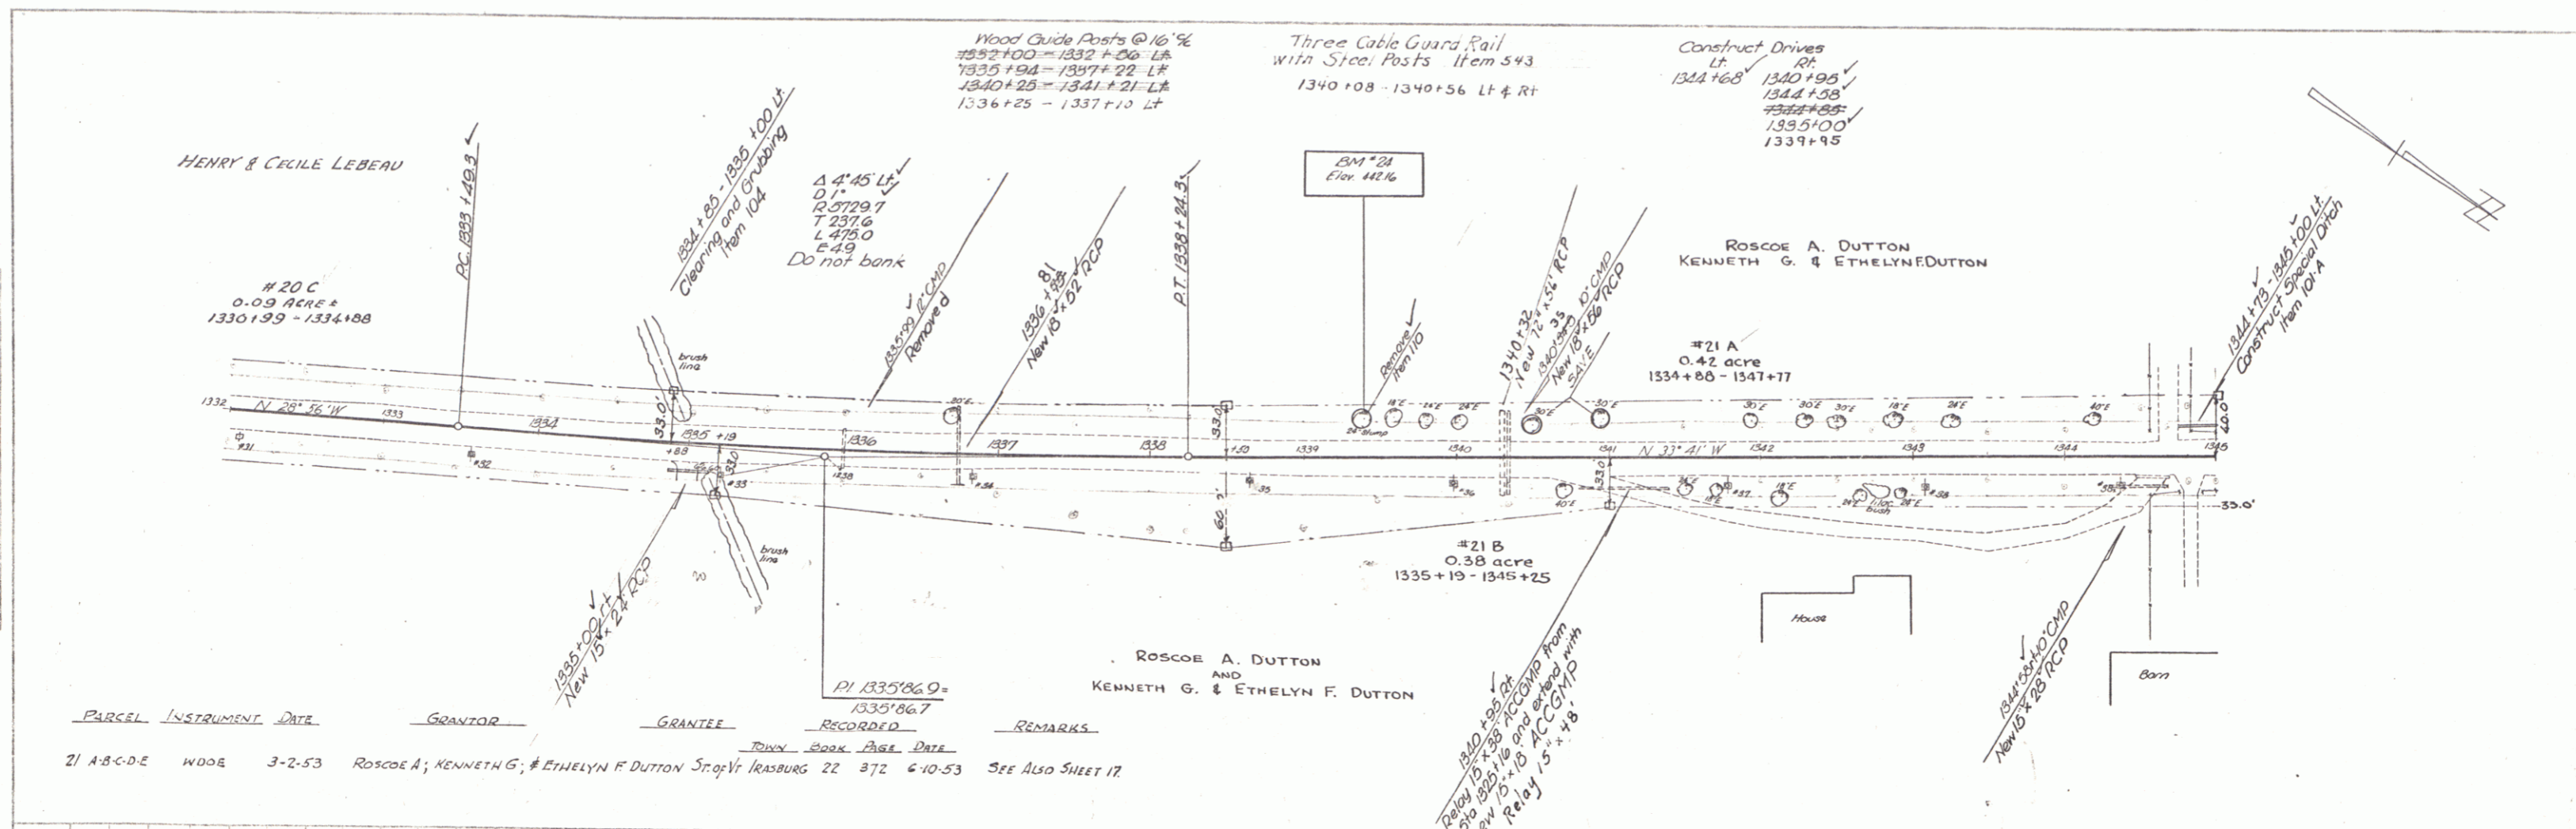

IRASBURG
 Project S No 166751
 Sheet 113 of 113