
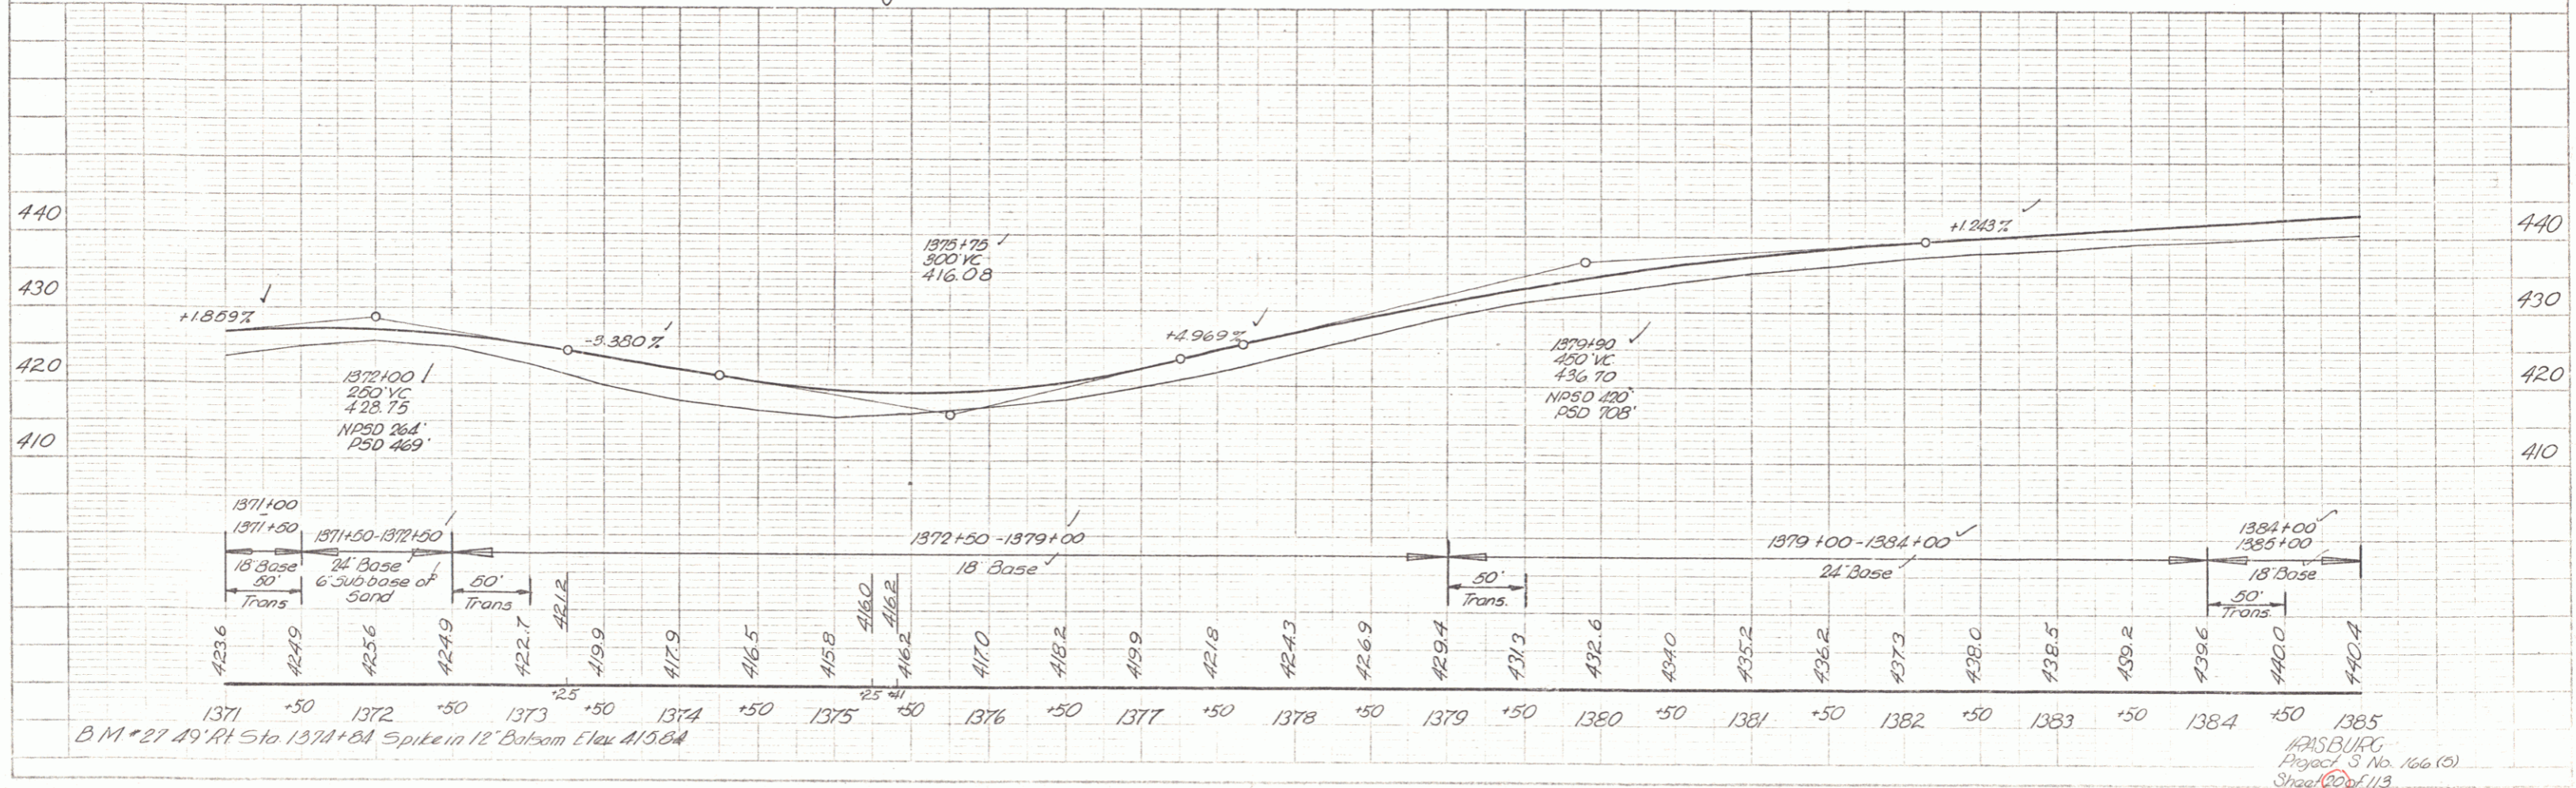


PLAN
 DATE
 SHEET NO.
 OF SHEETS
 DRAWN BY
 CHECKED BY

PLAN
 DATE
 SHEET NO.
 OF SHEETS
 DRAWN BY
 CHECKED BY

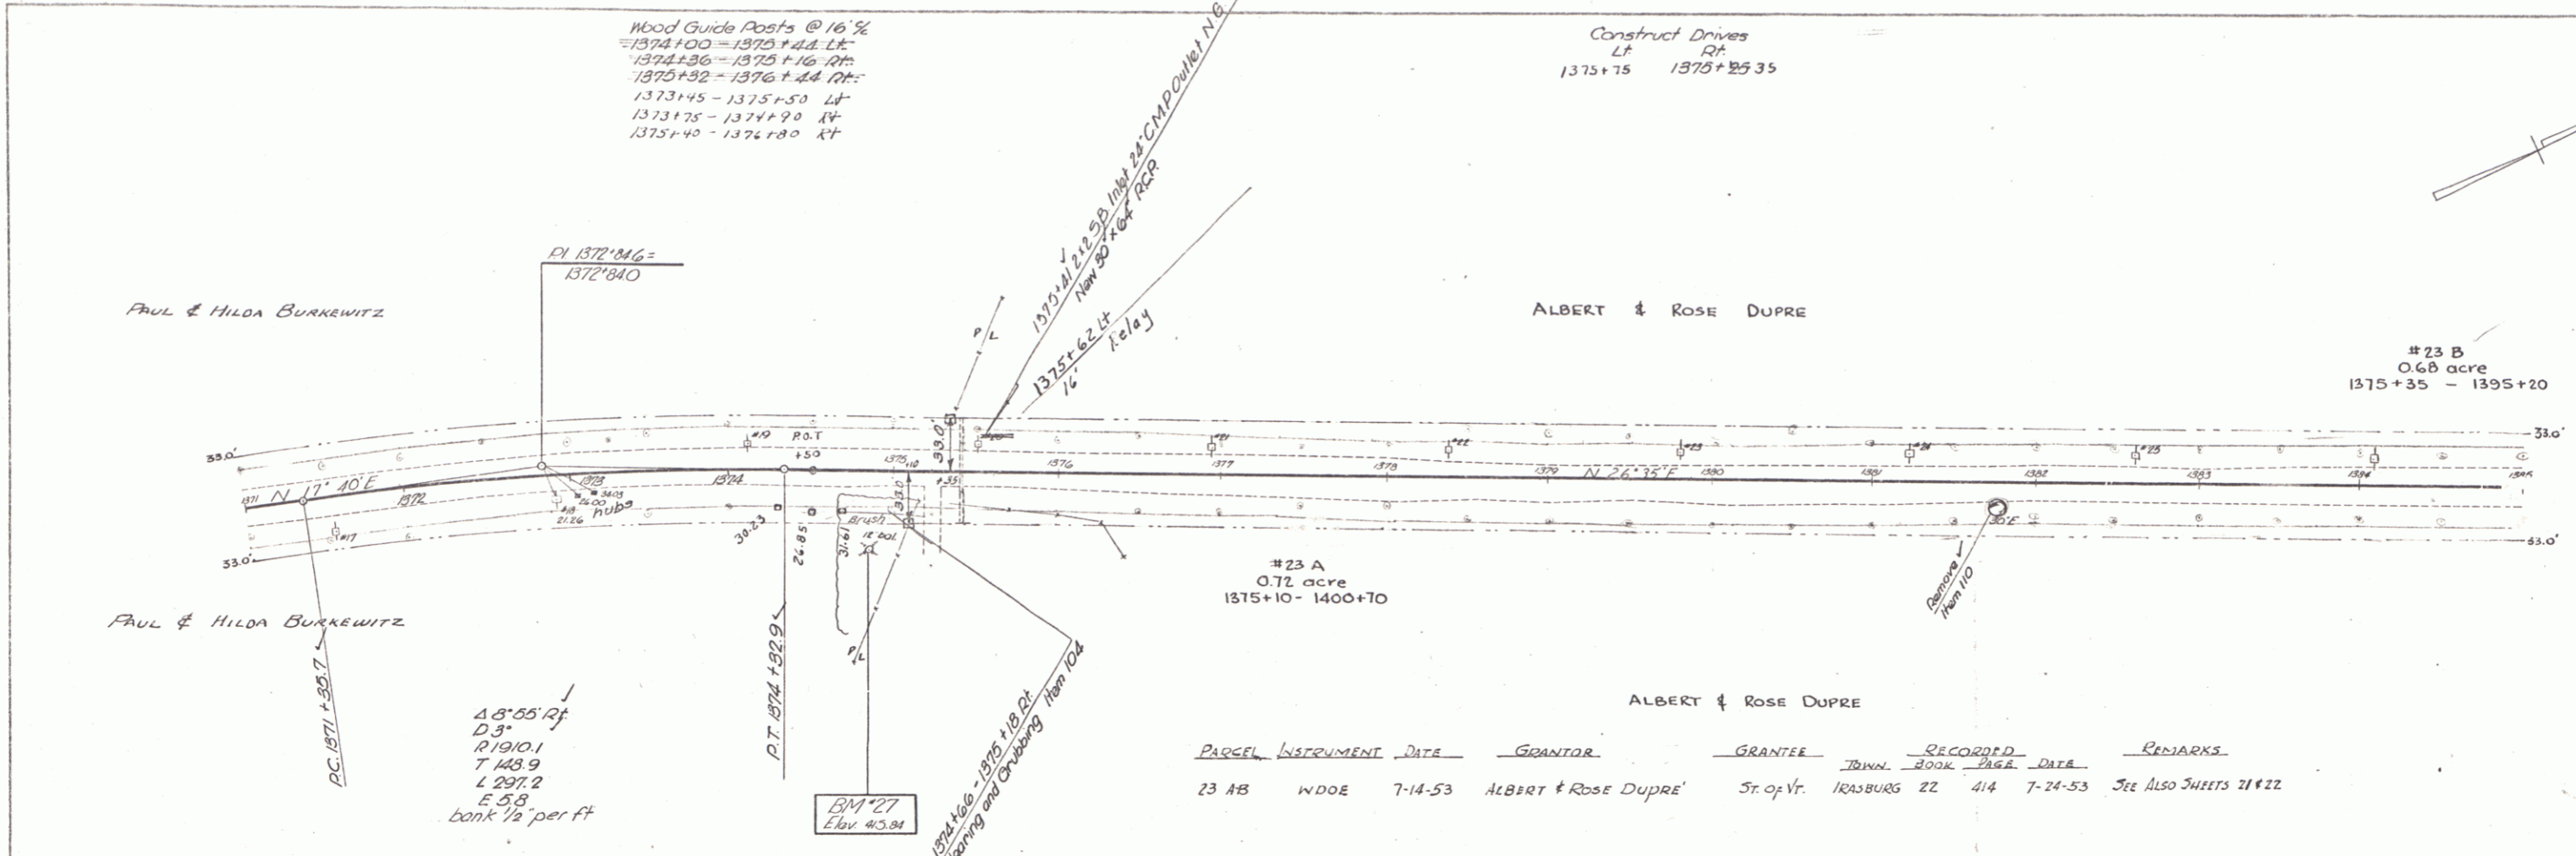

IRASBURG
 Project S No. 166 (C)
 Sheet 20 of 113