
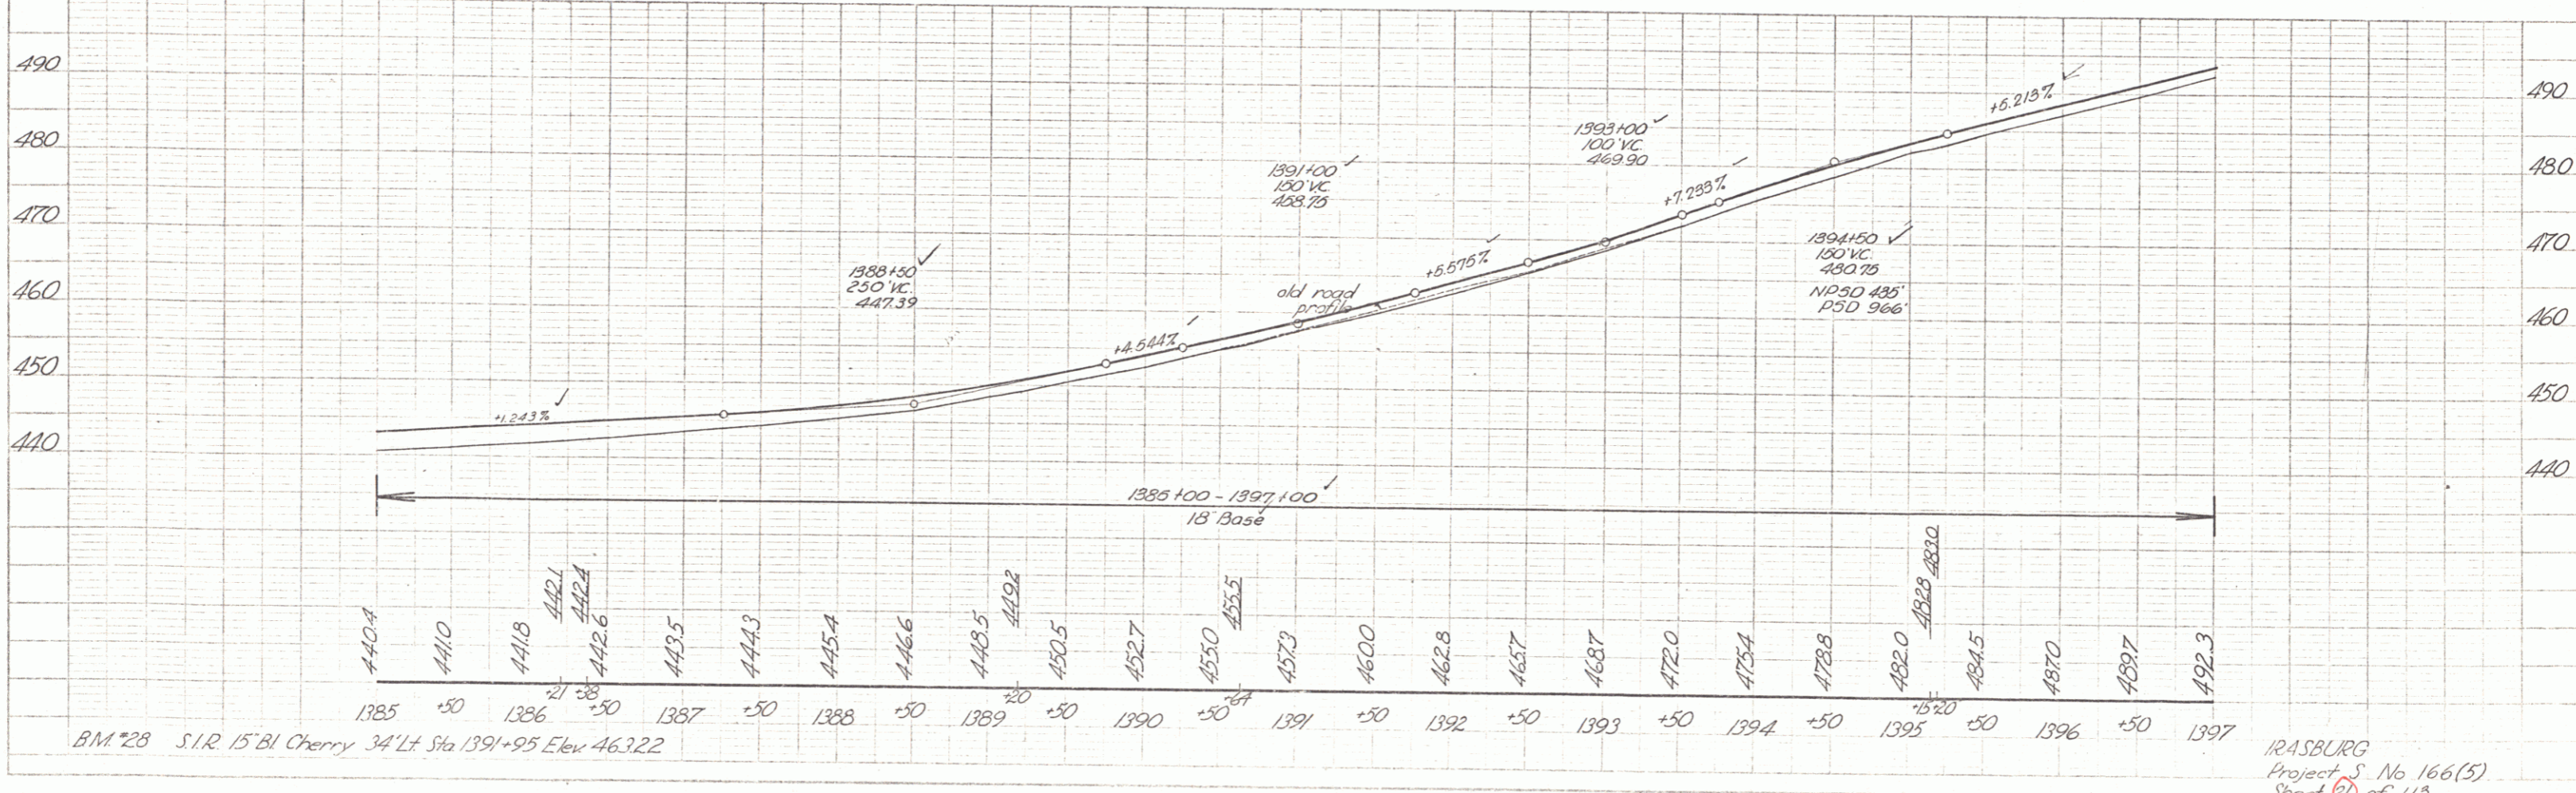


DATE	1/22
BY	W. J. H.
CHECKED	H. J. H.
SCALE	AS SHOWN
PROJECT	113
SHEET	113

DATE	1/22
BY	W. J. H.
CHECKED	H. J. H.
SCALE	AS SHOWN
PROJECT	113
SHEET	113

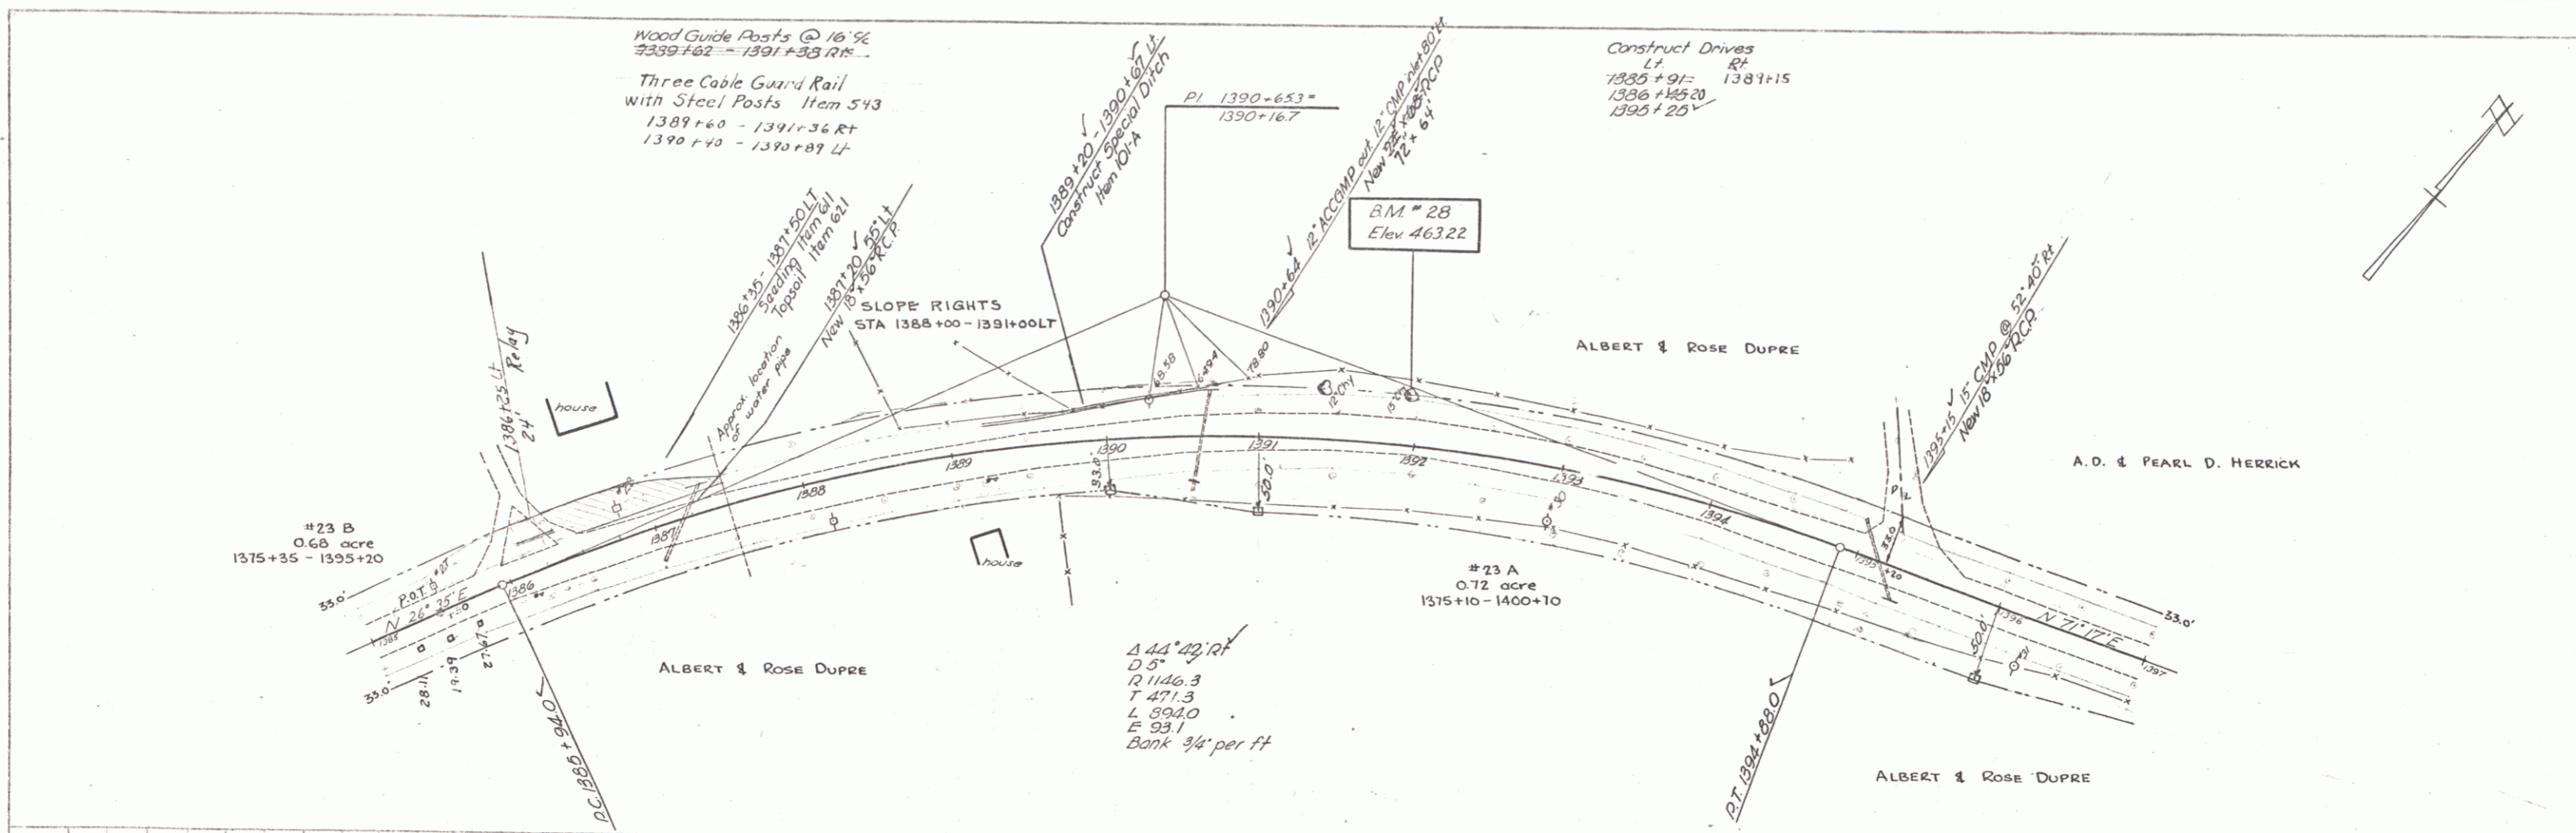

IRASBURG  
Project S No 166(5)  
Sheet 113 of 113