



PLAN
 SHOWING
 SPREADING
 BERM
 HORIZONTAL
 VERTICAL

PLAN
 SHOWING
 SPREADING
 BERM
 HORIZONTAL
 VERTICAL

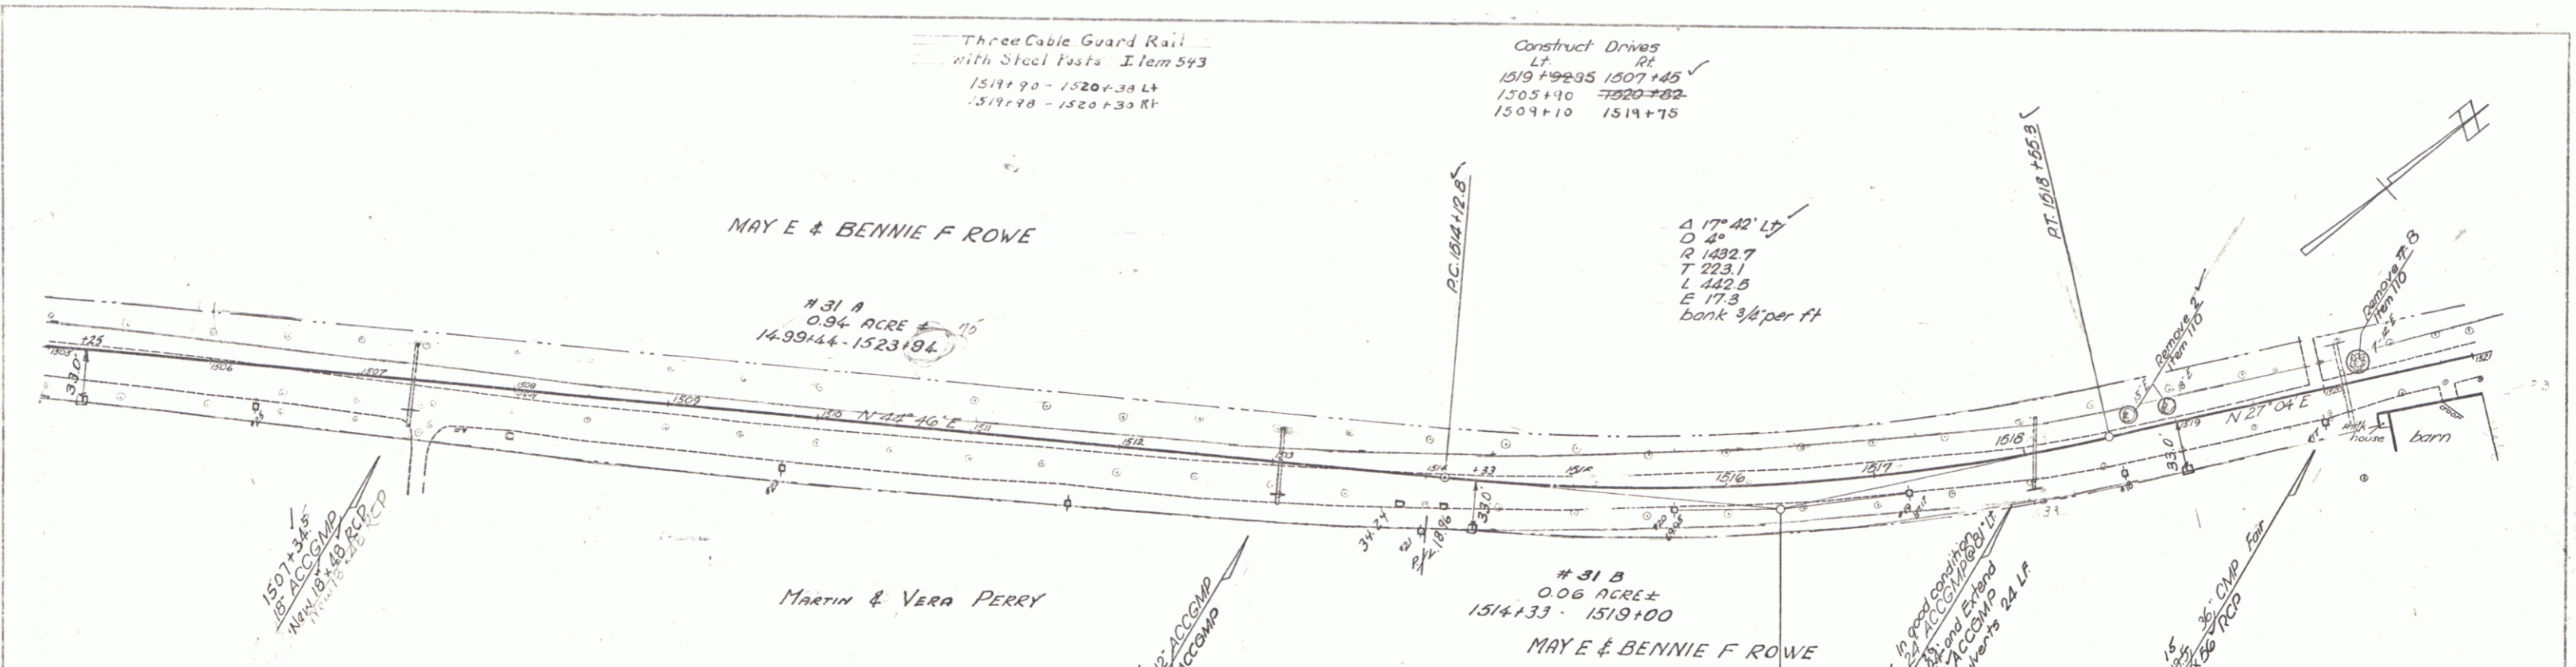

PARCEL	INSTRUMENT	DATE	GRANTOR	GRANTEE	RECORDED	REMARKS
					TOWN BOOK PAGE DATE	SHEET
31A-B-C-D	WOOE	4-28-53	MAY E & BENNIE F ROWE	ST. OF VT.	IRASBURG 22 350 5-2-53	See also 28130

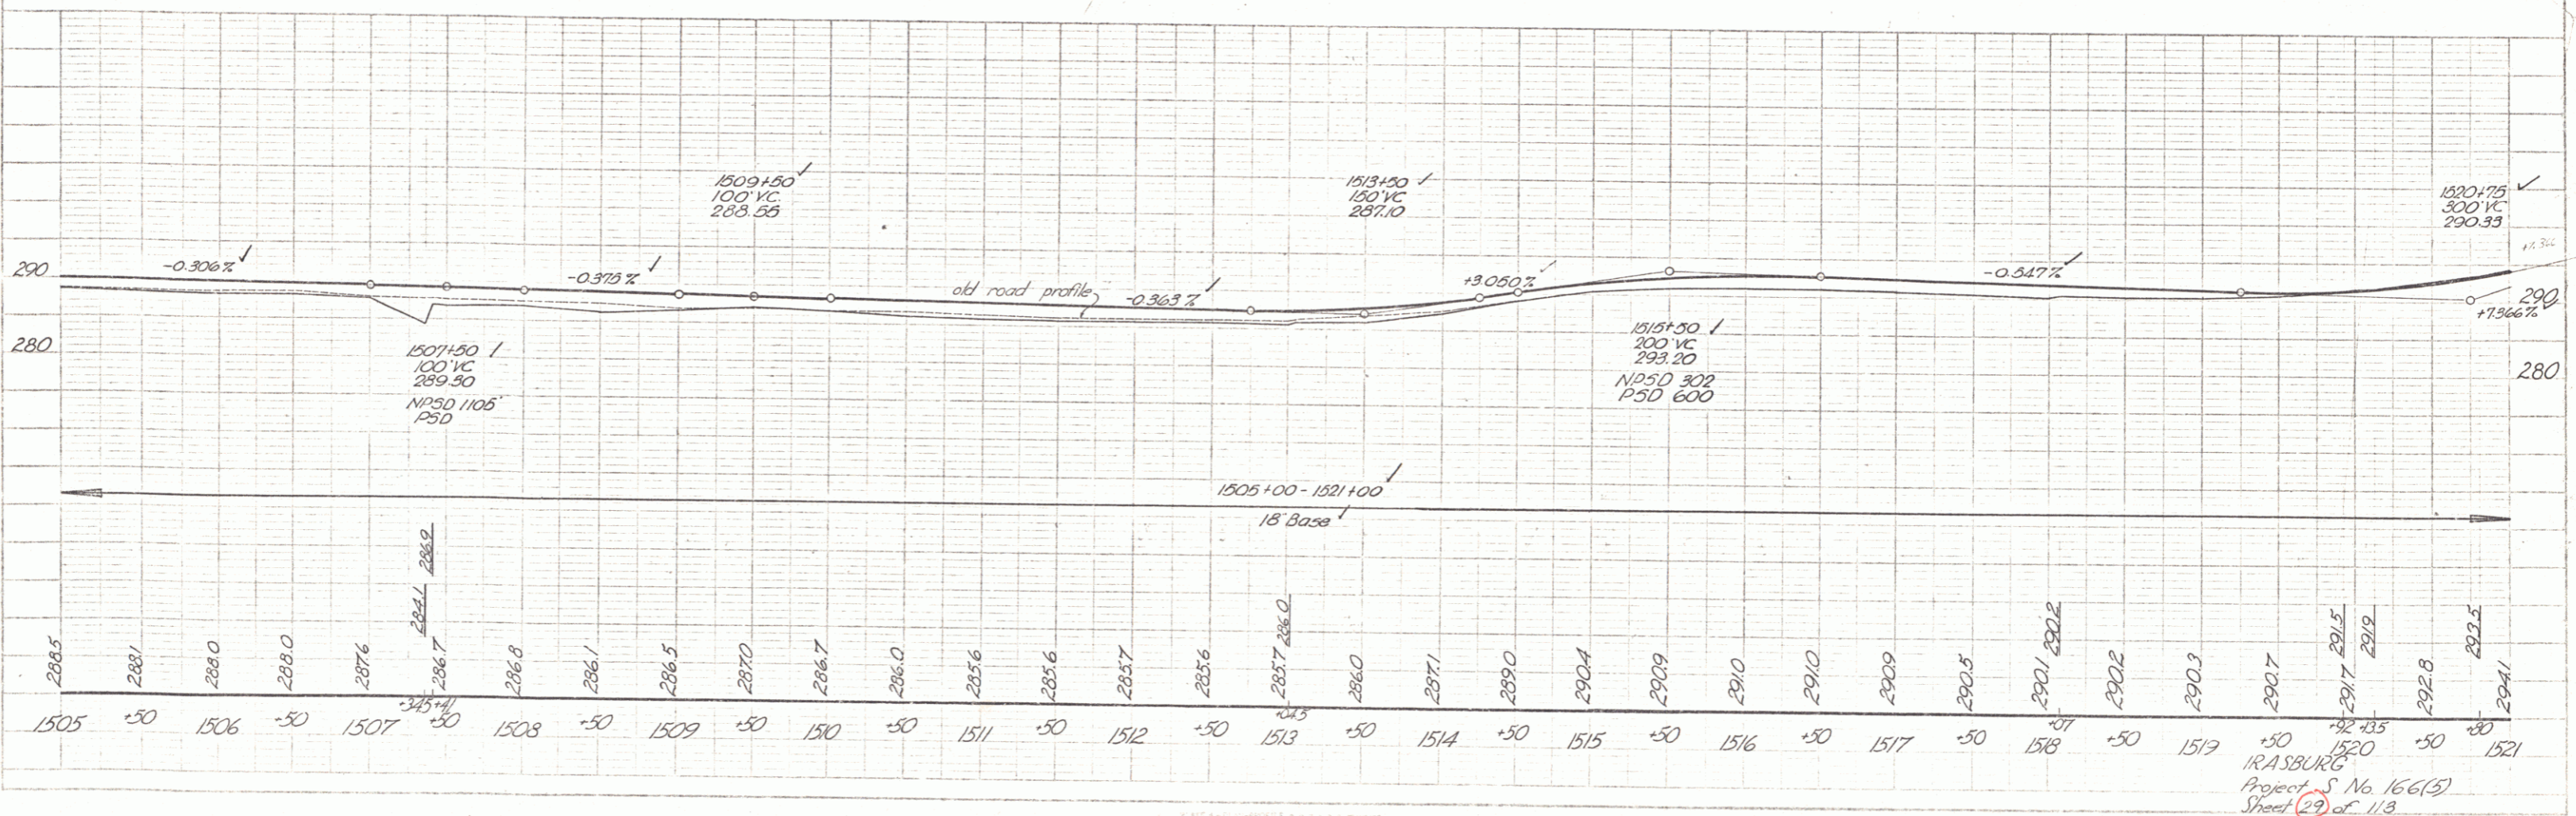

IRASBURG
 Project No. 166(3)
 Sheet 29 of 113