

INSTALL SLEEVE FOR WATER PIPE
ACROSS ROADWAY
ITEM 103' X 64" X 30" VIT
SLEEVE TO BE FURNISHED BY PROPERTY
OWNER
STA. 1521+68 ±

Construct Drives
L.F. 30
1521+138 1522+135
1526+02 1526+70

REV. P.I. 1525+62.0 =
1525+33.3



Survey
P.I. 1526+257 ±
1525+85.2
Δ 44° 32' RT
D 6'

B.M. #41
Elev. 337.68

WOOD GUIDE POSTS
1526+54 - 1527+20 4'

DATE	7/22
BY	W. J. ...
CHECKED	...
SCALE	AS SHOWN

DATE	8/22
BY	W. J. ...
CHECKED	...
SCALE	AS SHOWN

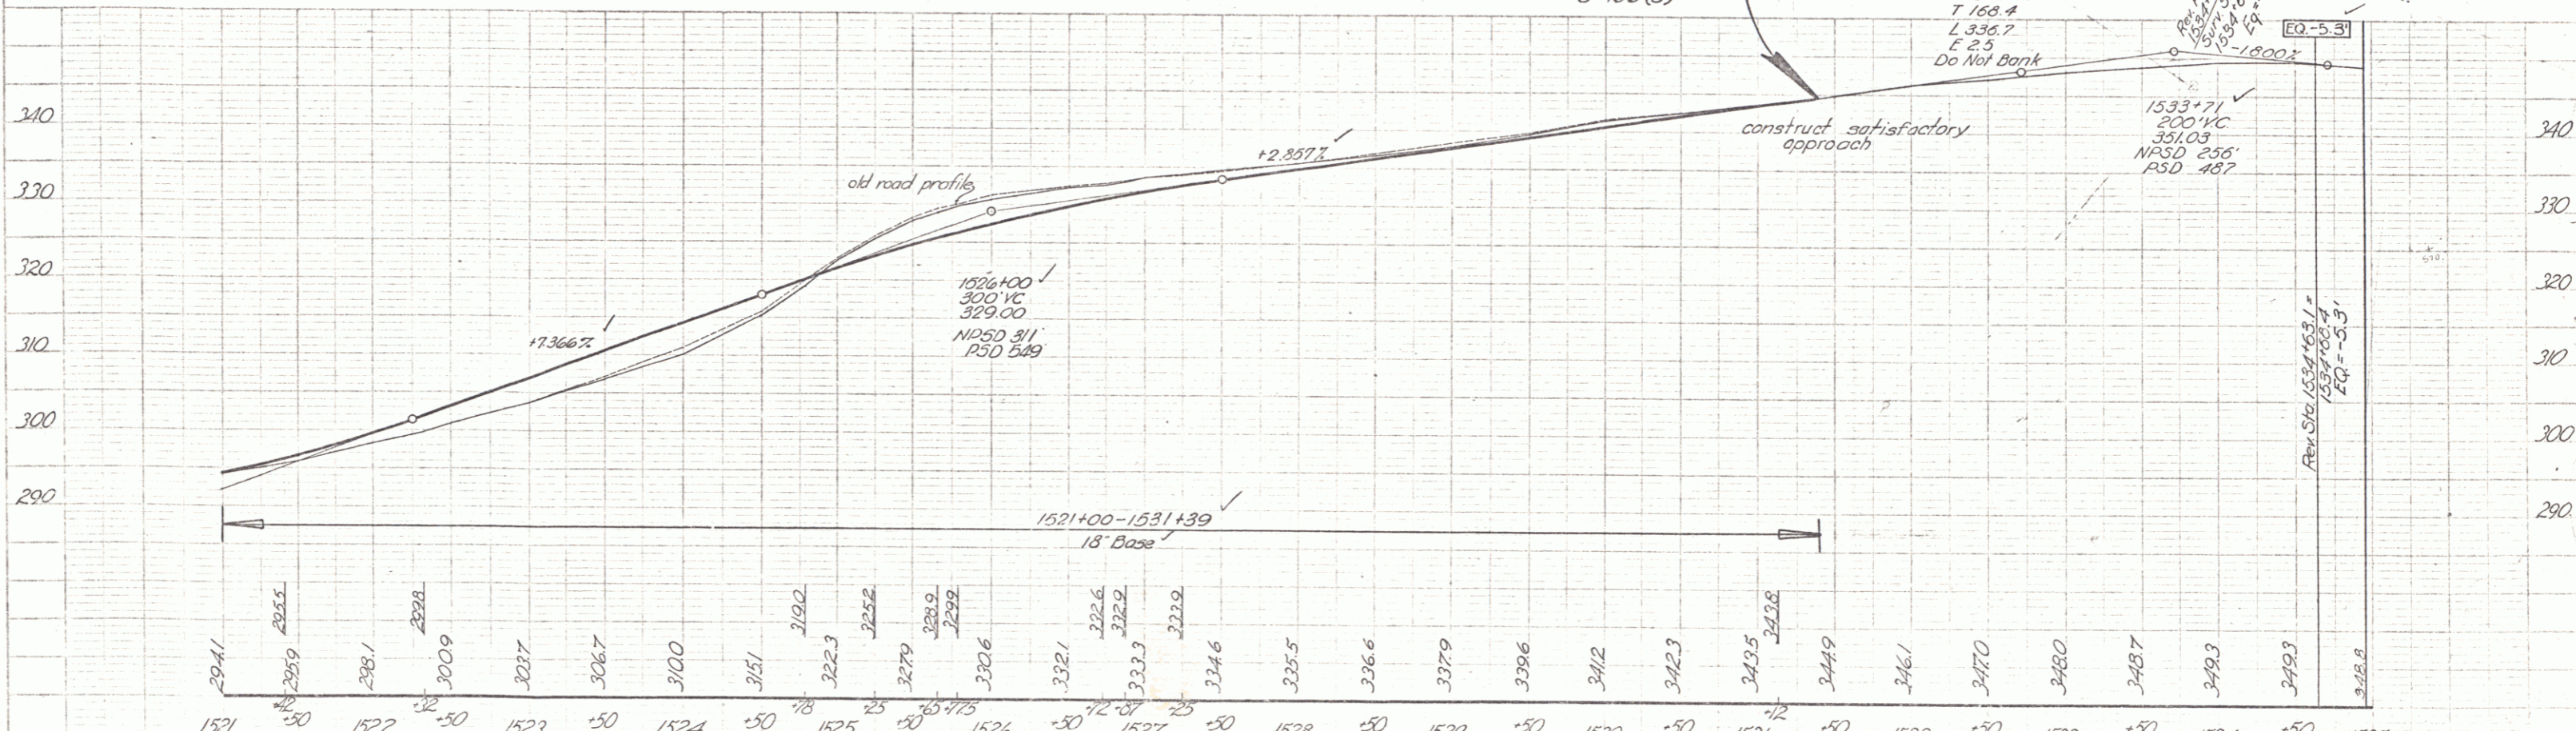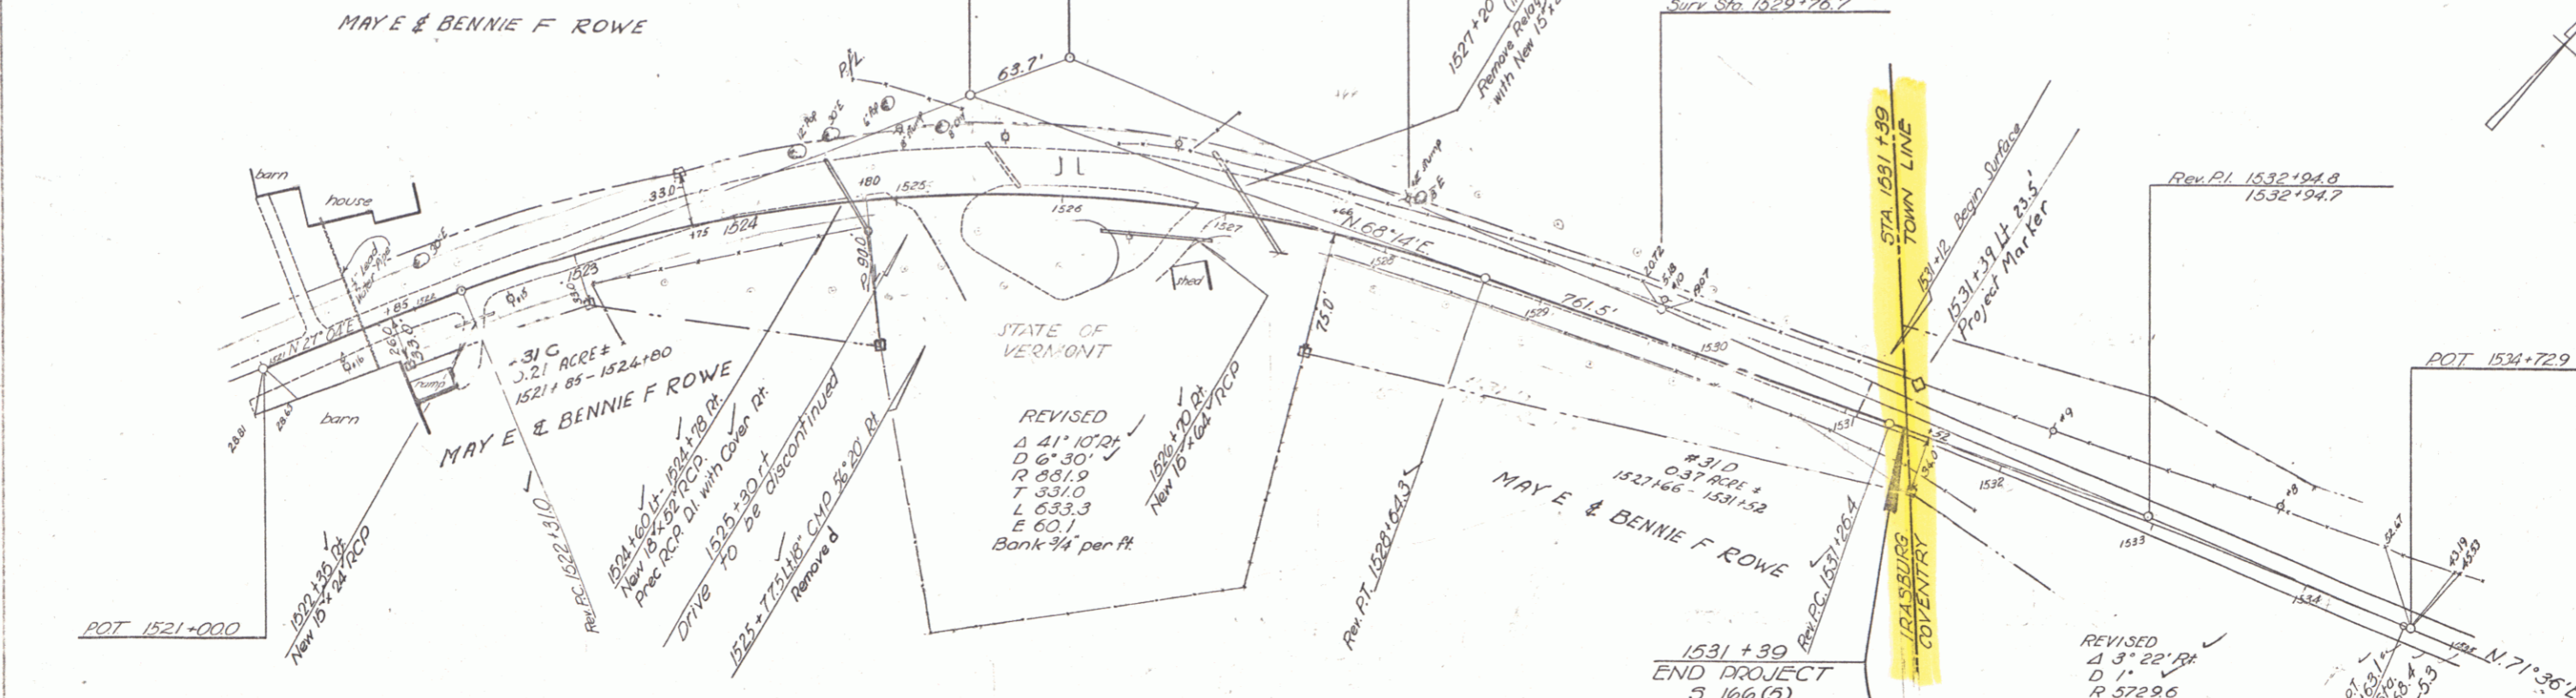

B.M. #41 S.I.R. 12 Birch Stump L.L. Sta 1528+10 Elev. 337.68

IRASBURG
Project S No. 166(5)
Sheet 30 of 113