



THIS IS PART OF THE SAME LAND AND PREMISES ACQUIRED BY THE STATE OF VERMONT BY EDWARD T. & LILA BELL SNAY BY WARRANTY DEED DATED DEC., 22 1959 AND RECORDED IN BOOK 22, PAGE 77 OF THE COVENTRY LAND RECORDS.

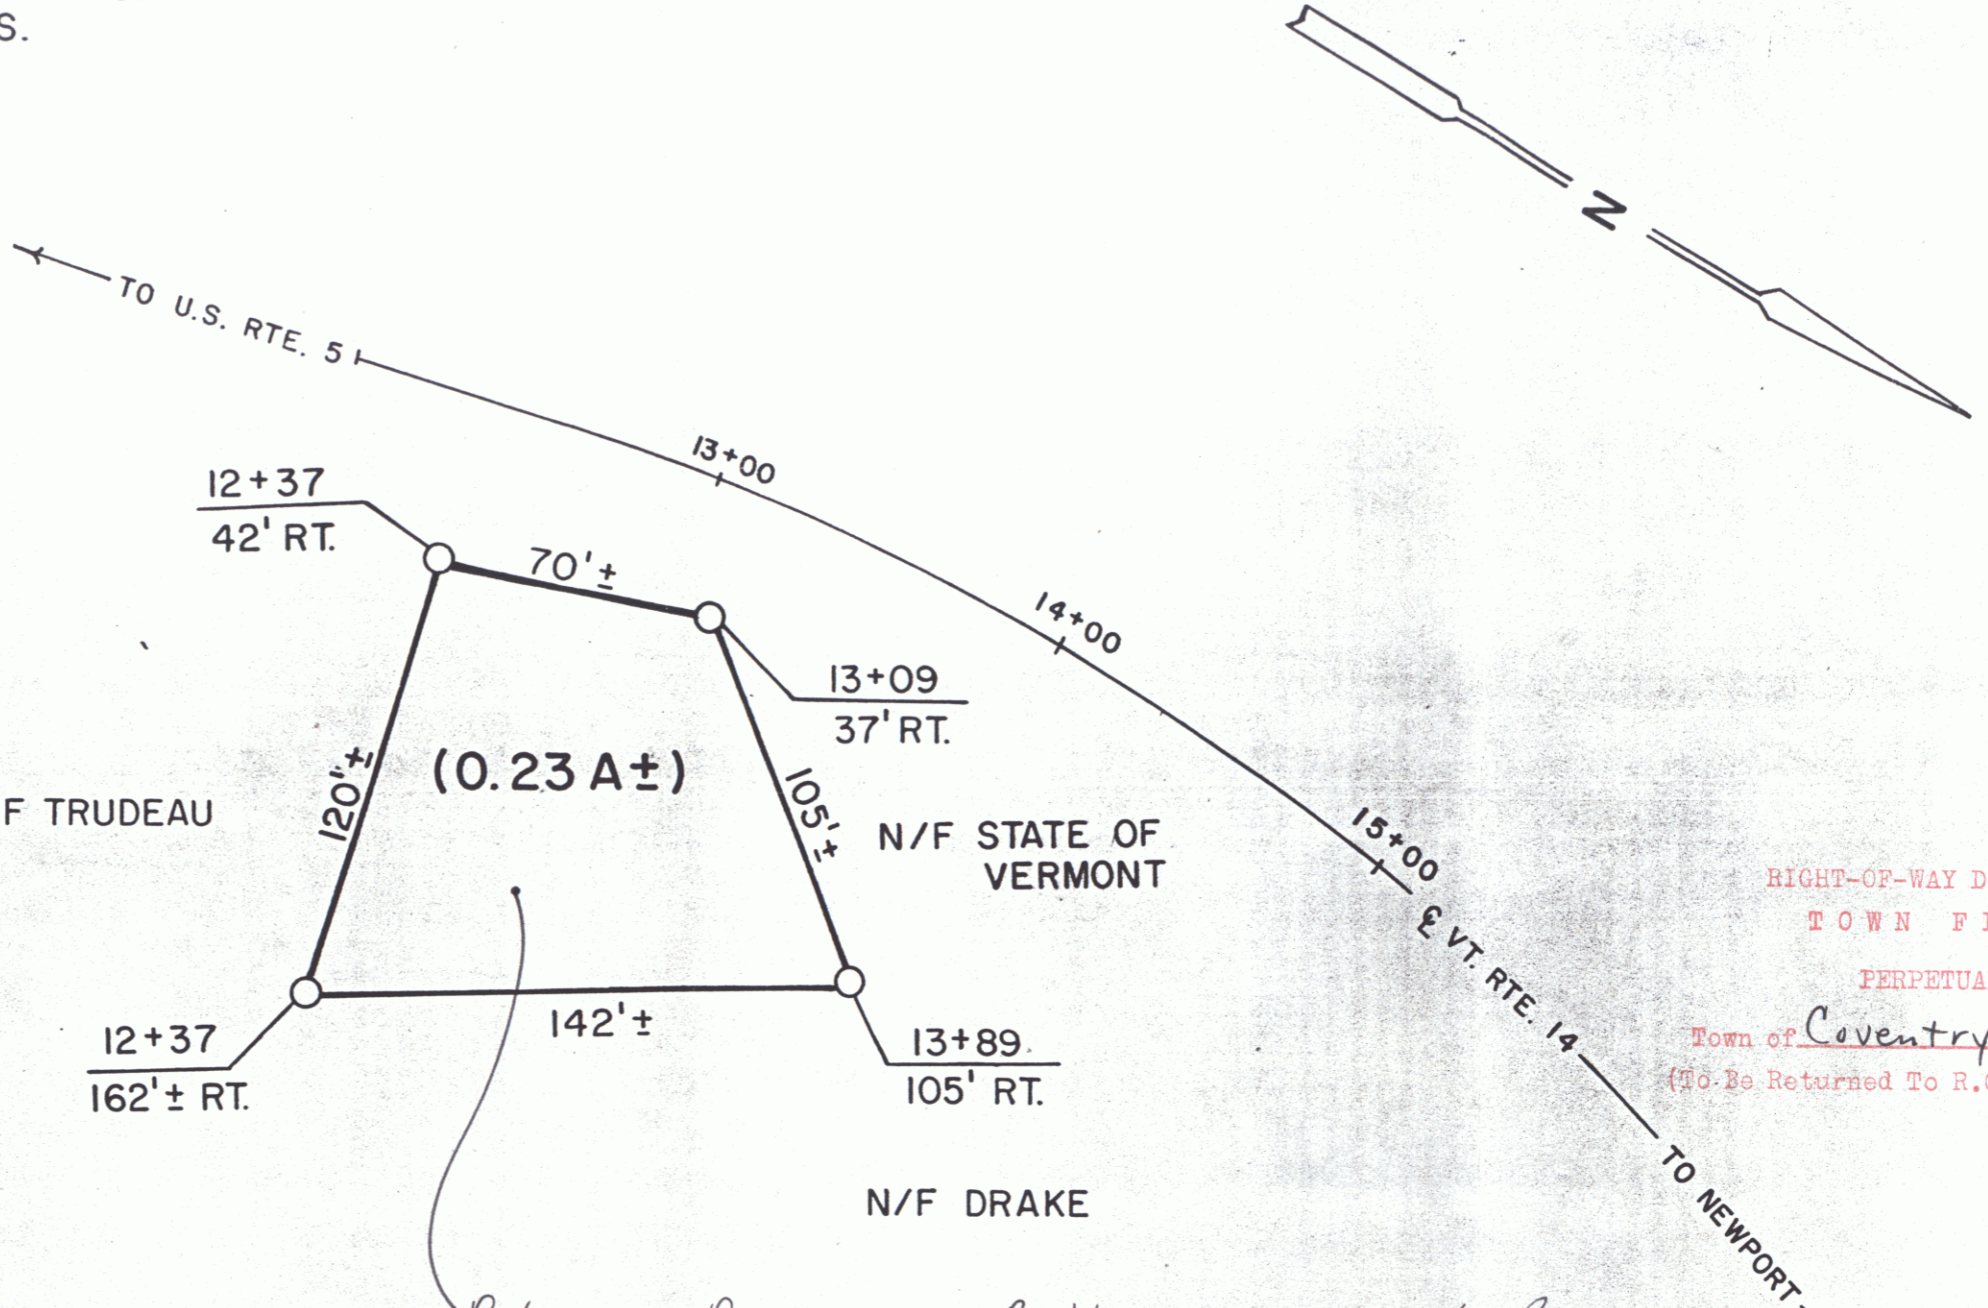

RIGHT-OF-WAY DIVISION
TOWN FILE
PERPETUAL
Town of Coventry Vt#4
(To Be Returned To R.O.W. Division)

Release of Reversionary Right.
to Town of Coventry
QCD dated 11/5/90 recorded BK30, Pg 132, 133
(original deed dated 2/5/60 BK 30, Pg 7)

Surplus Property No. 03-6275-9013
REF: COVENTRY-NEWPORT S-0313(1)
SHEET 25 OF 163

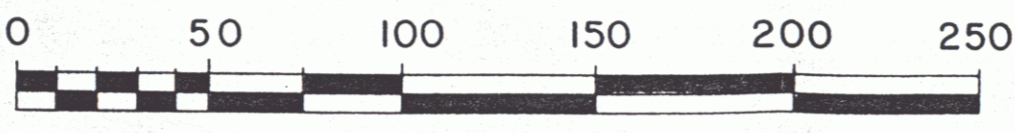

STATE OF VERMONT
AGENCY OF TRANSPORTATION
SHEET 25A
TOWN OF COVENTRY
APPROX. SCALE 1" = 50' DATE: 10-18-90 DRAWN BY M.J.R. 5