
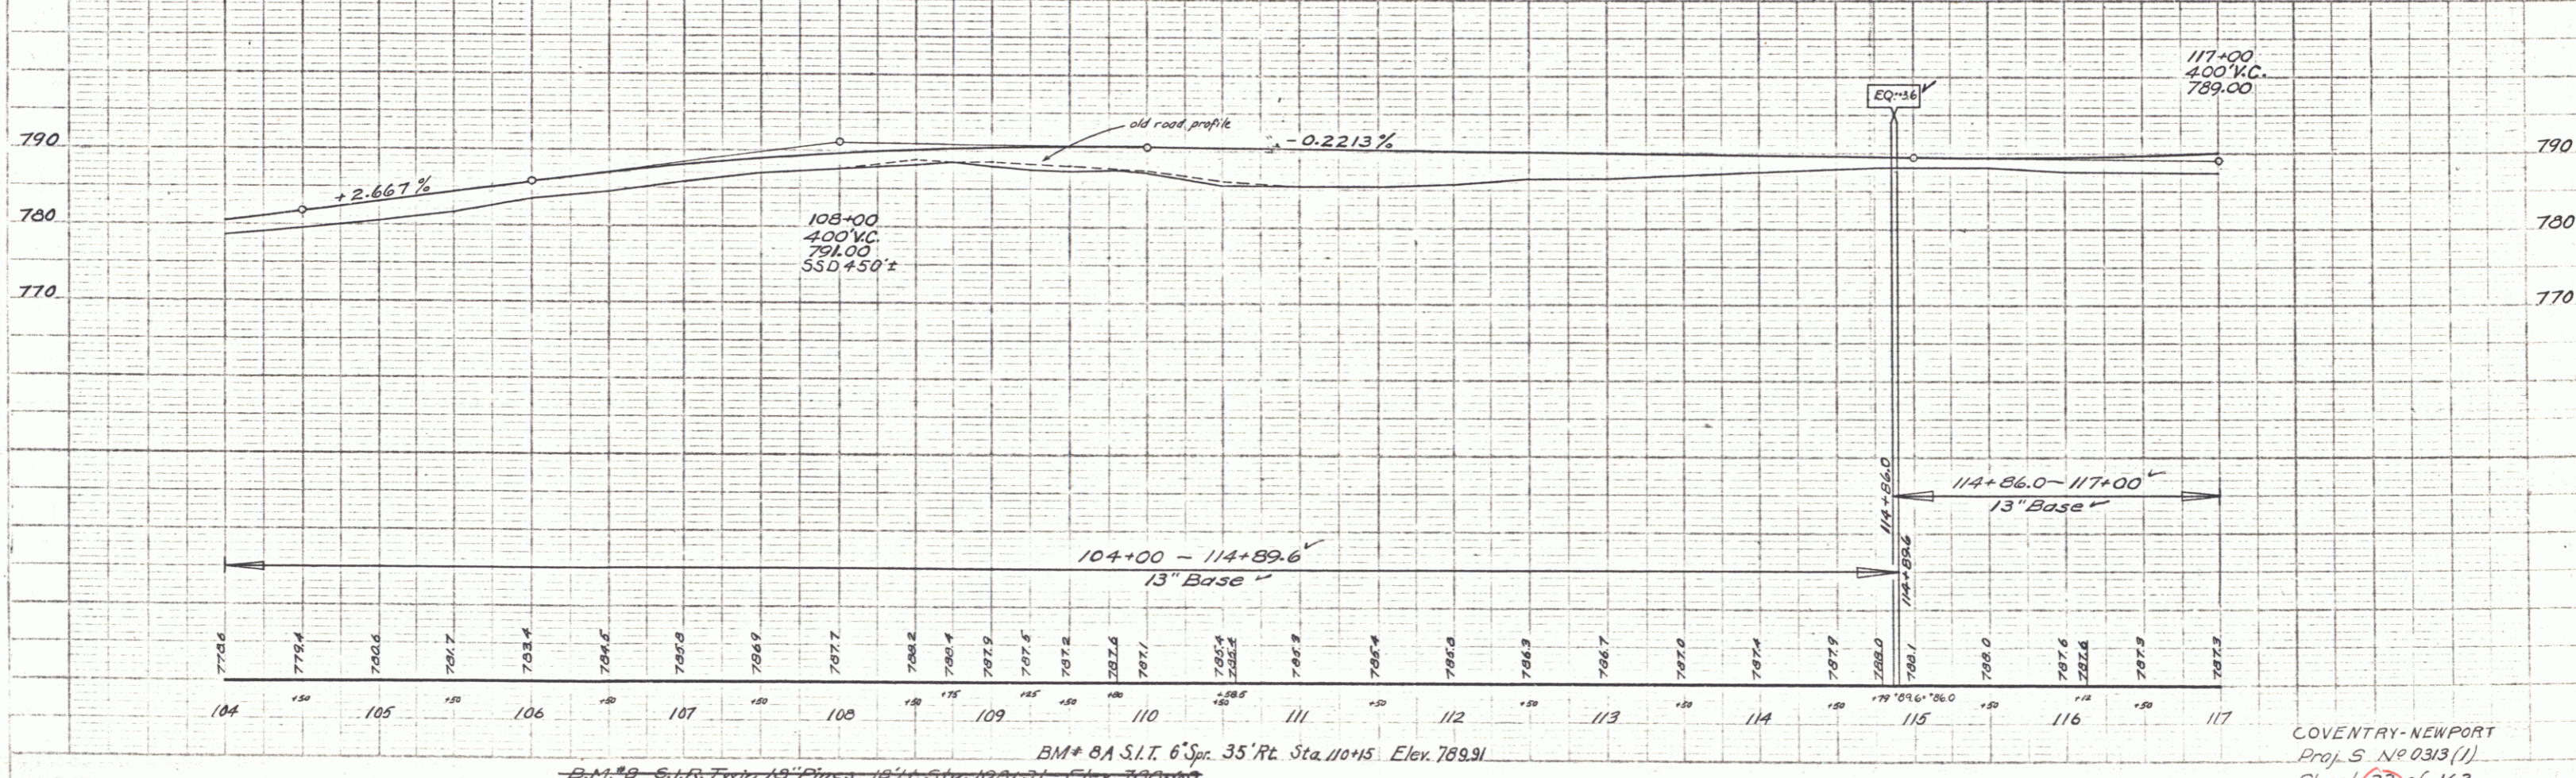


PLAN  
 DATE: 11/15/58  
 DRAWN BY: C.E.H.  
 CHECKED BY: C.E.H.

PROFILES  
 DATE: 11/15/58  
 DRAWN BY: C.E.H.  
 CHECKED BY: C.E.H.

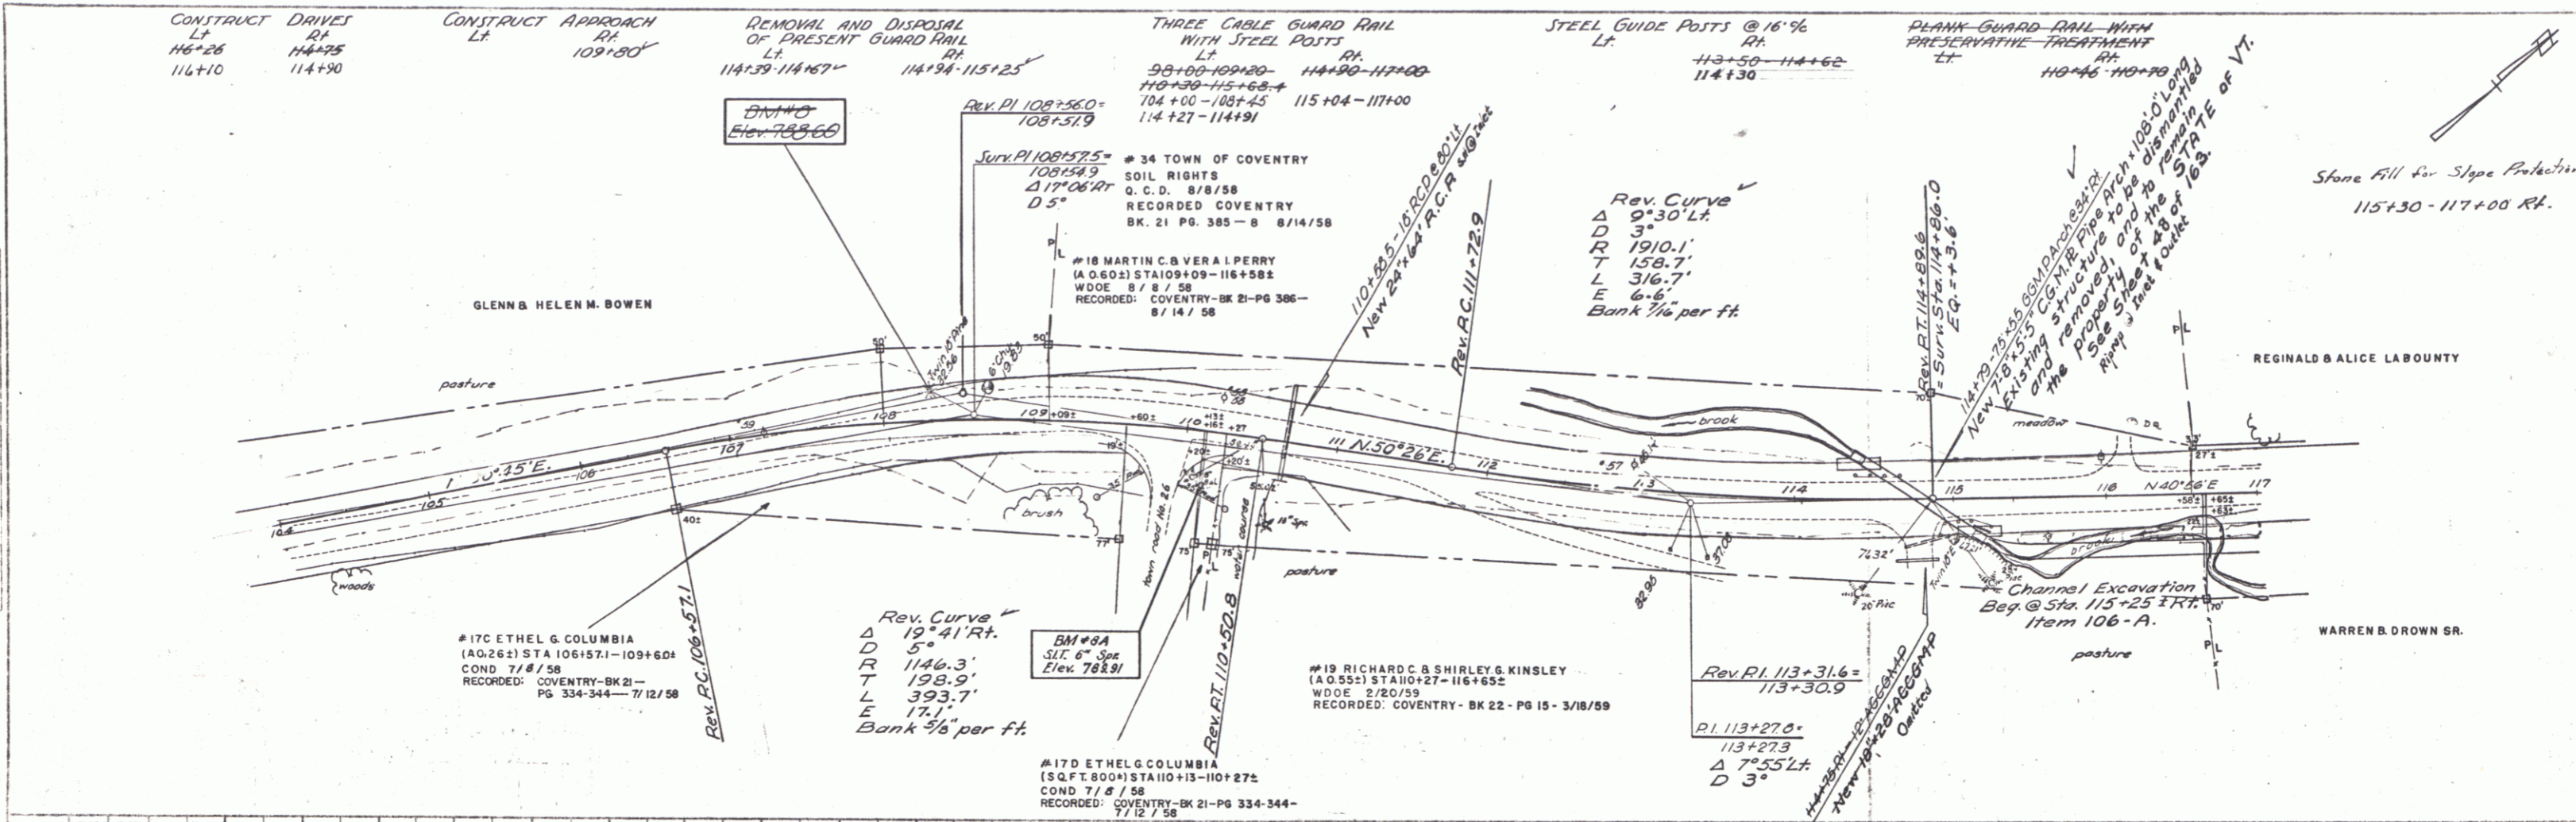

BM # 8A S.I.T. 6" Spr. 35' Rt. Sta. 110+15 Elev. 789.91  
 B.M. # 9 S.I.T. 6" Spr. 19' Lt. Sta. 108+31 Elev. 788.60  
 COVENTRY-NEWPORT  
 Proj. S. No. 0313(1)  
 Sheet 33 of 163