

PLAN
 DATE: 11-28-58
 DRAWN BY: BURNESS
 CHECKED BY: [Signature]
 PROJECT: COVENTRY-NEWPORT
 SHEET: 11 of 163

PROFILE
 DATE: 11-27-58
 DRAWN BY: [Signature]
 CHECKED BY: [Signature]
 PROJECT: COVENTRY-NEWPORT
 SHEET: 11 of 163

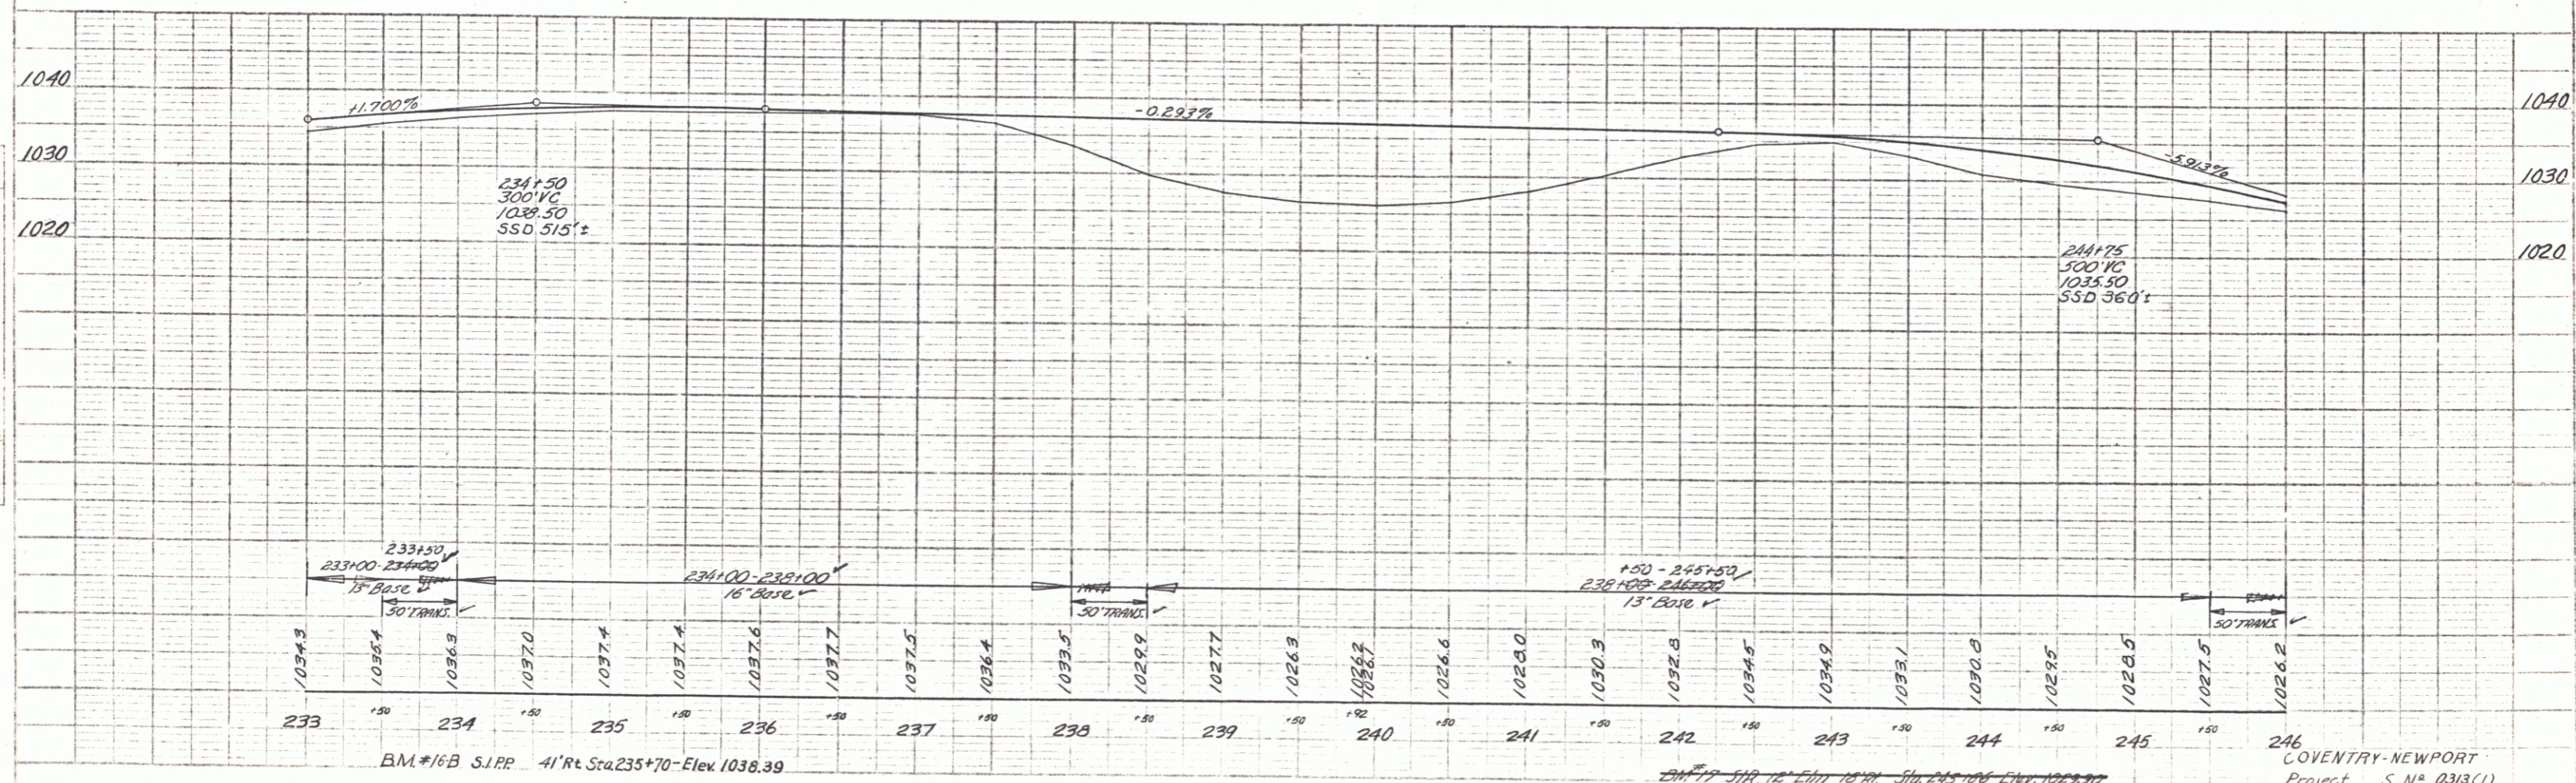
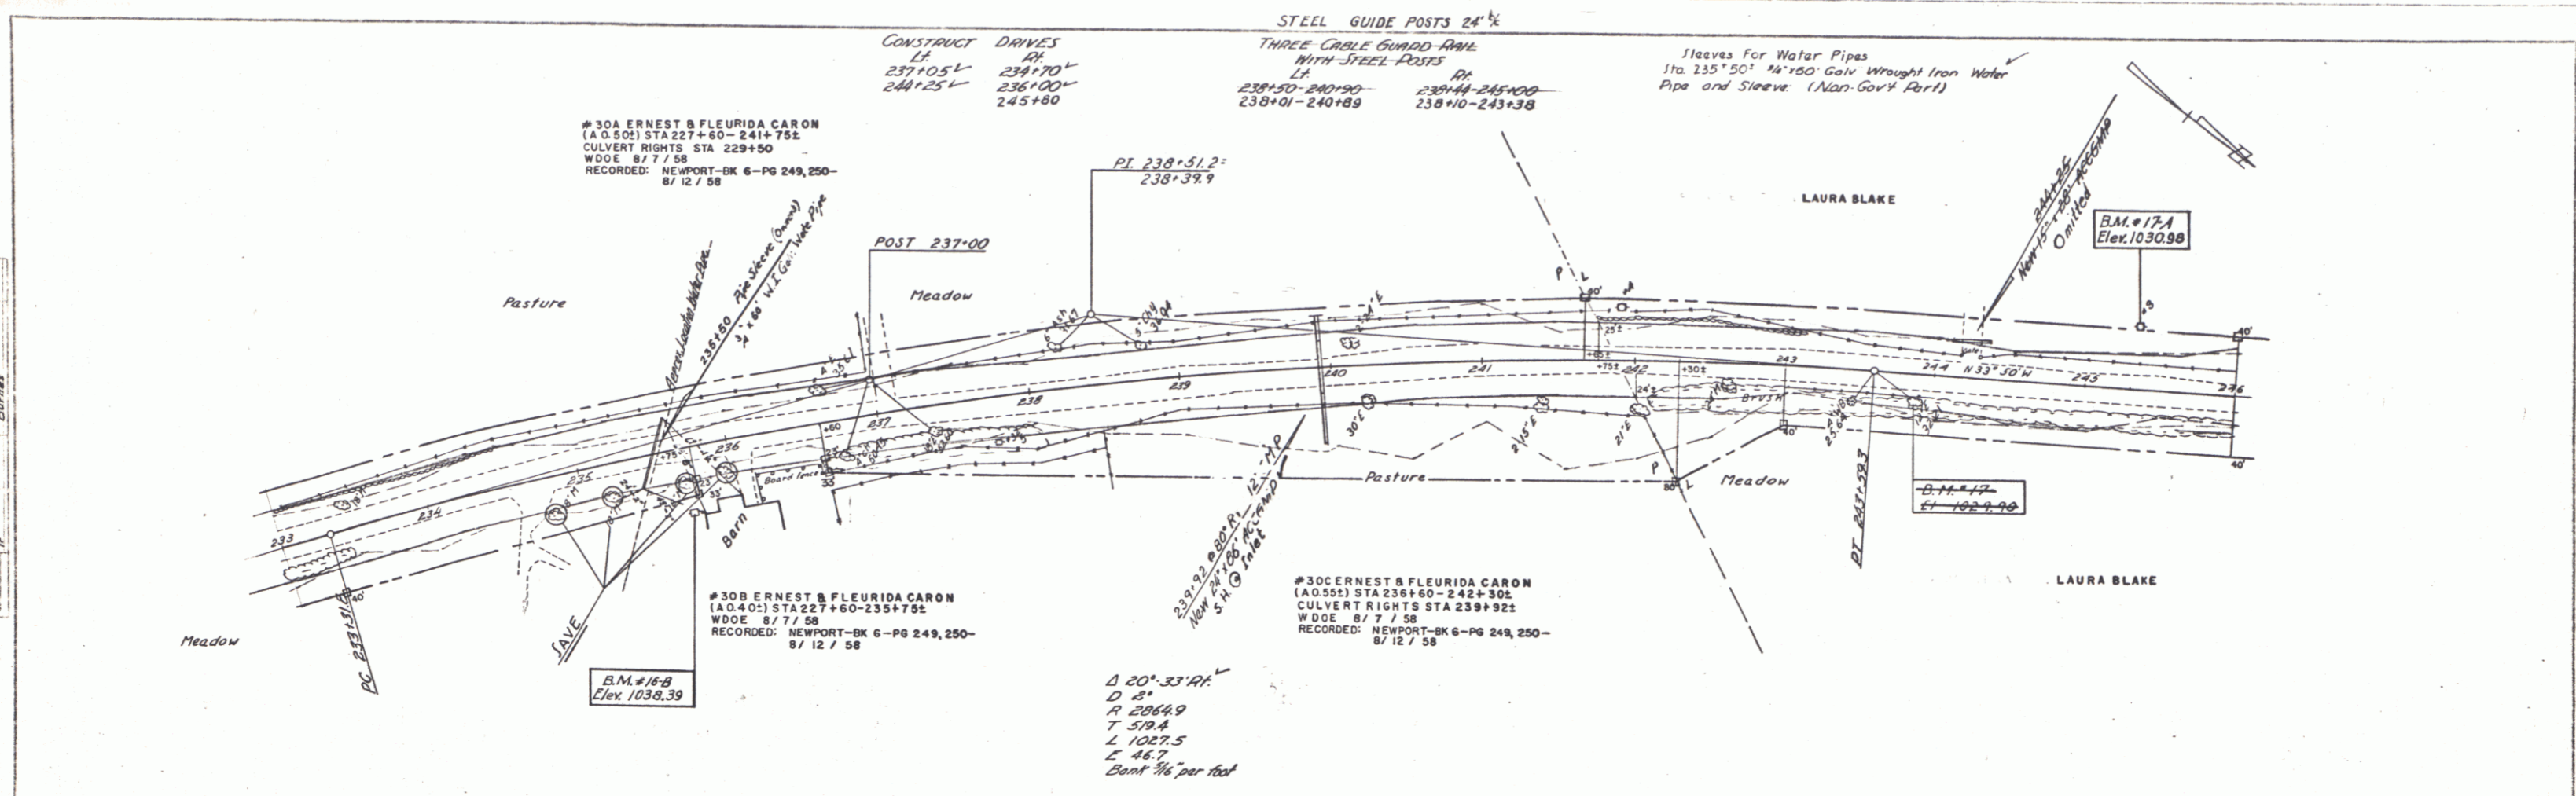


PLATE 1. PLAN/PROFILE P.P. 8. STANDARD
 10/25/58

COVENTRY-NEWPORT
 Project S N° 0313(1)
 Sheet 11 of 163