
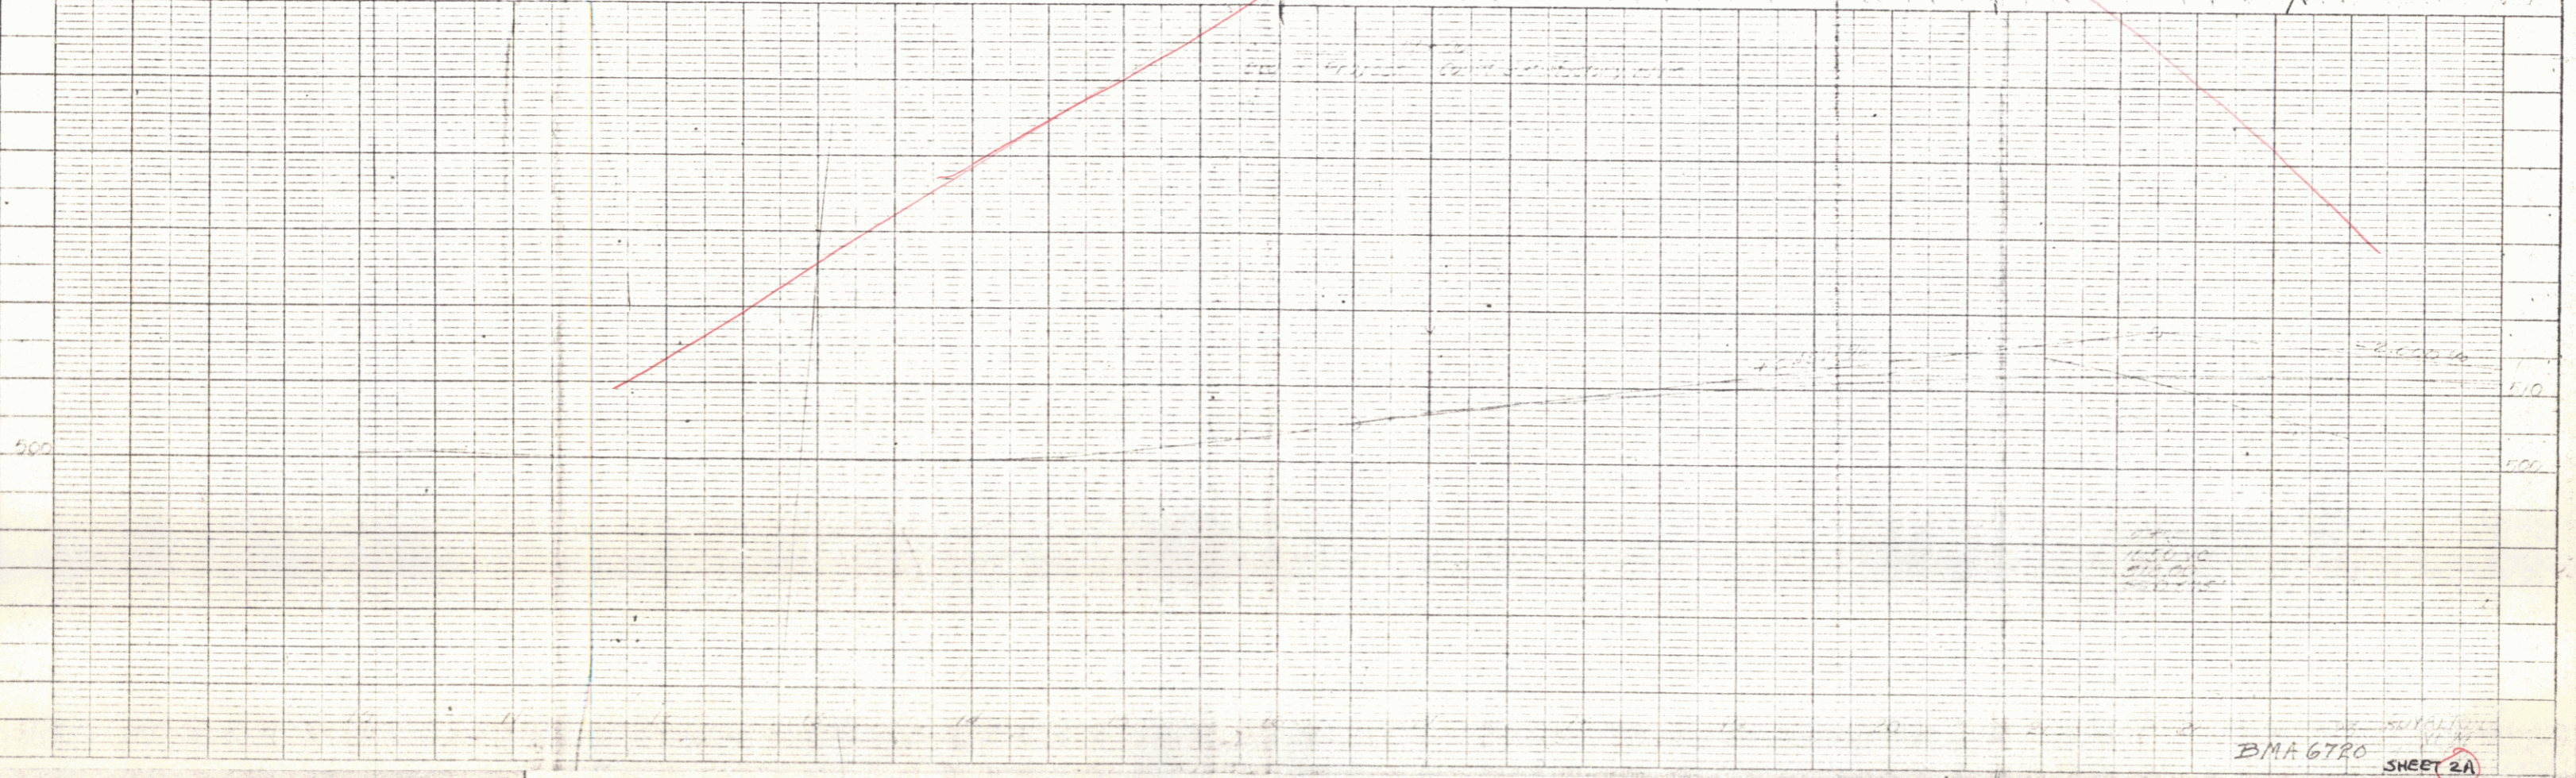


**PLAN**  
 DATE: 11/11/11  
 DRAWN BY: [Signature]  
 CHECKED BY: [Signature]  
 NO. 1

**PROFILE**  
 DATE: 11/11/11  
 DRAWN BY: [Signature]  
 CHECKED BY: [Signature]  
 NO. 1

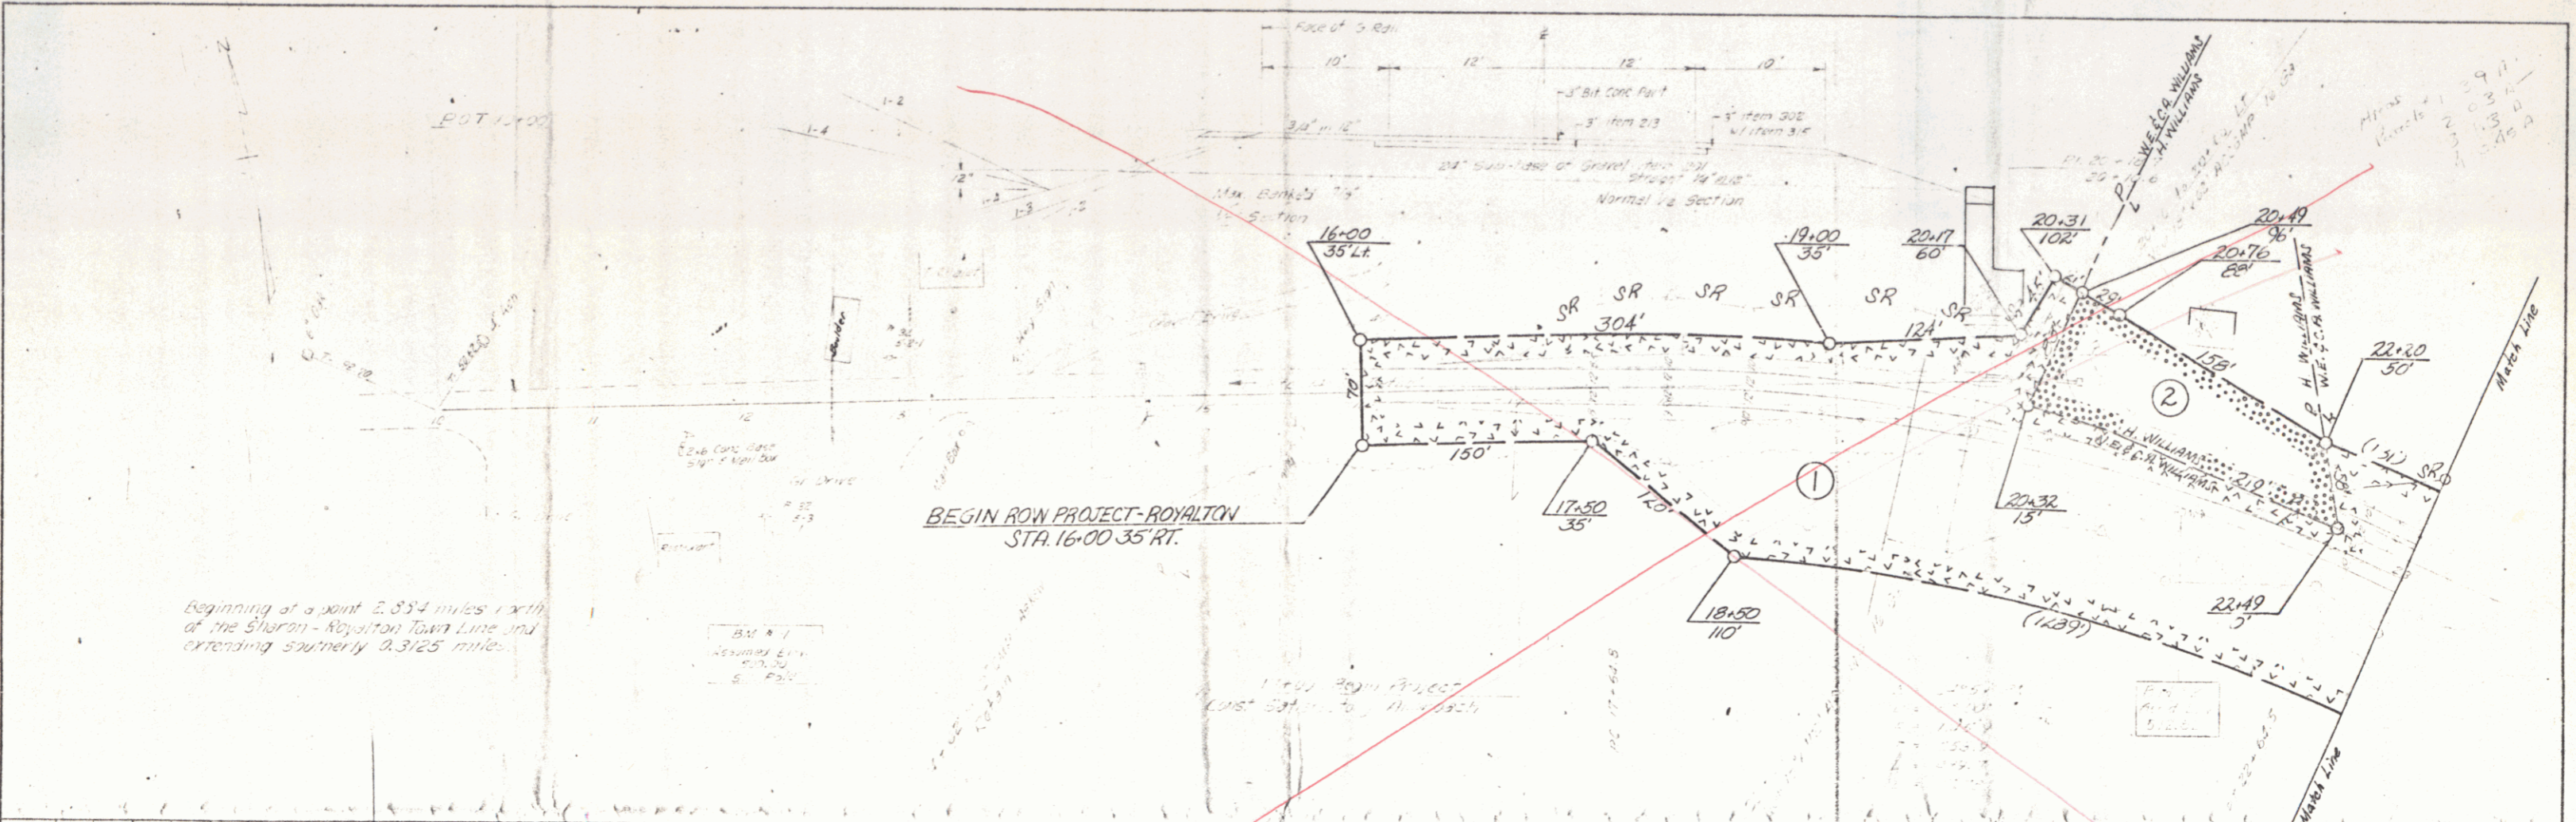

BMA 6780 SHEET 2A