


PLAN  
 DRAWN BY J. J. JEWETT  
 DATE 1/10/37  
 CHECKED BY C. H. J. JEWETT  
 DATE 1/10/37  
 NO. 137

PROFILE  
 DRAWN BY J. J. JEWETT  
 DATE 1/10/37  
 CHECKED BY C. H. J. JEWETT  
 DATE 1/10/37  
 NO. 137

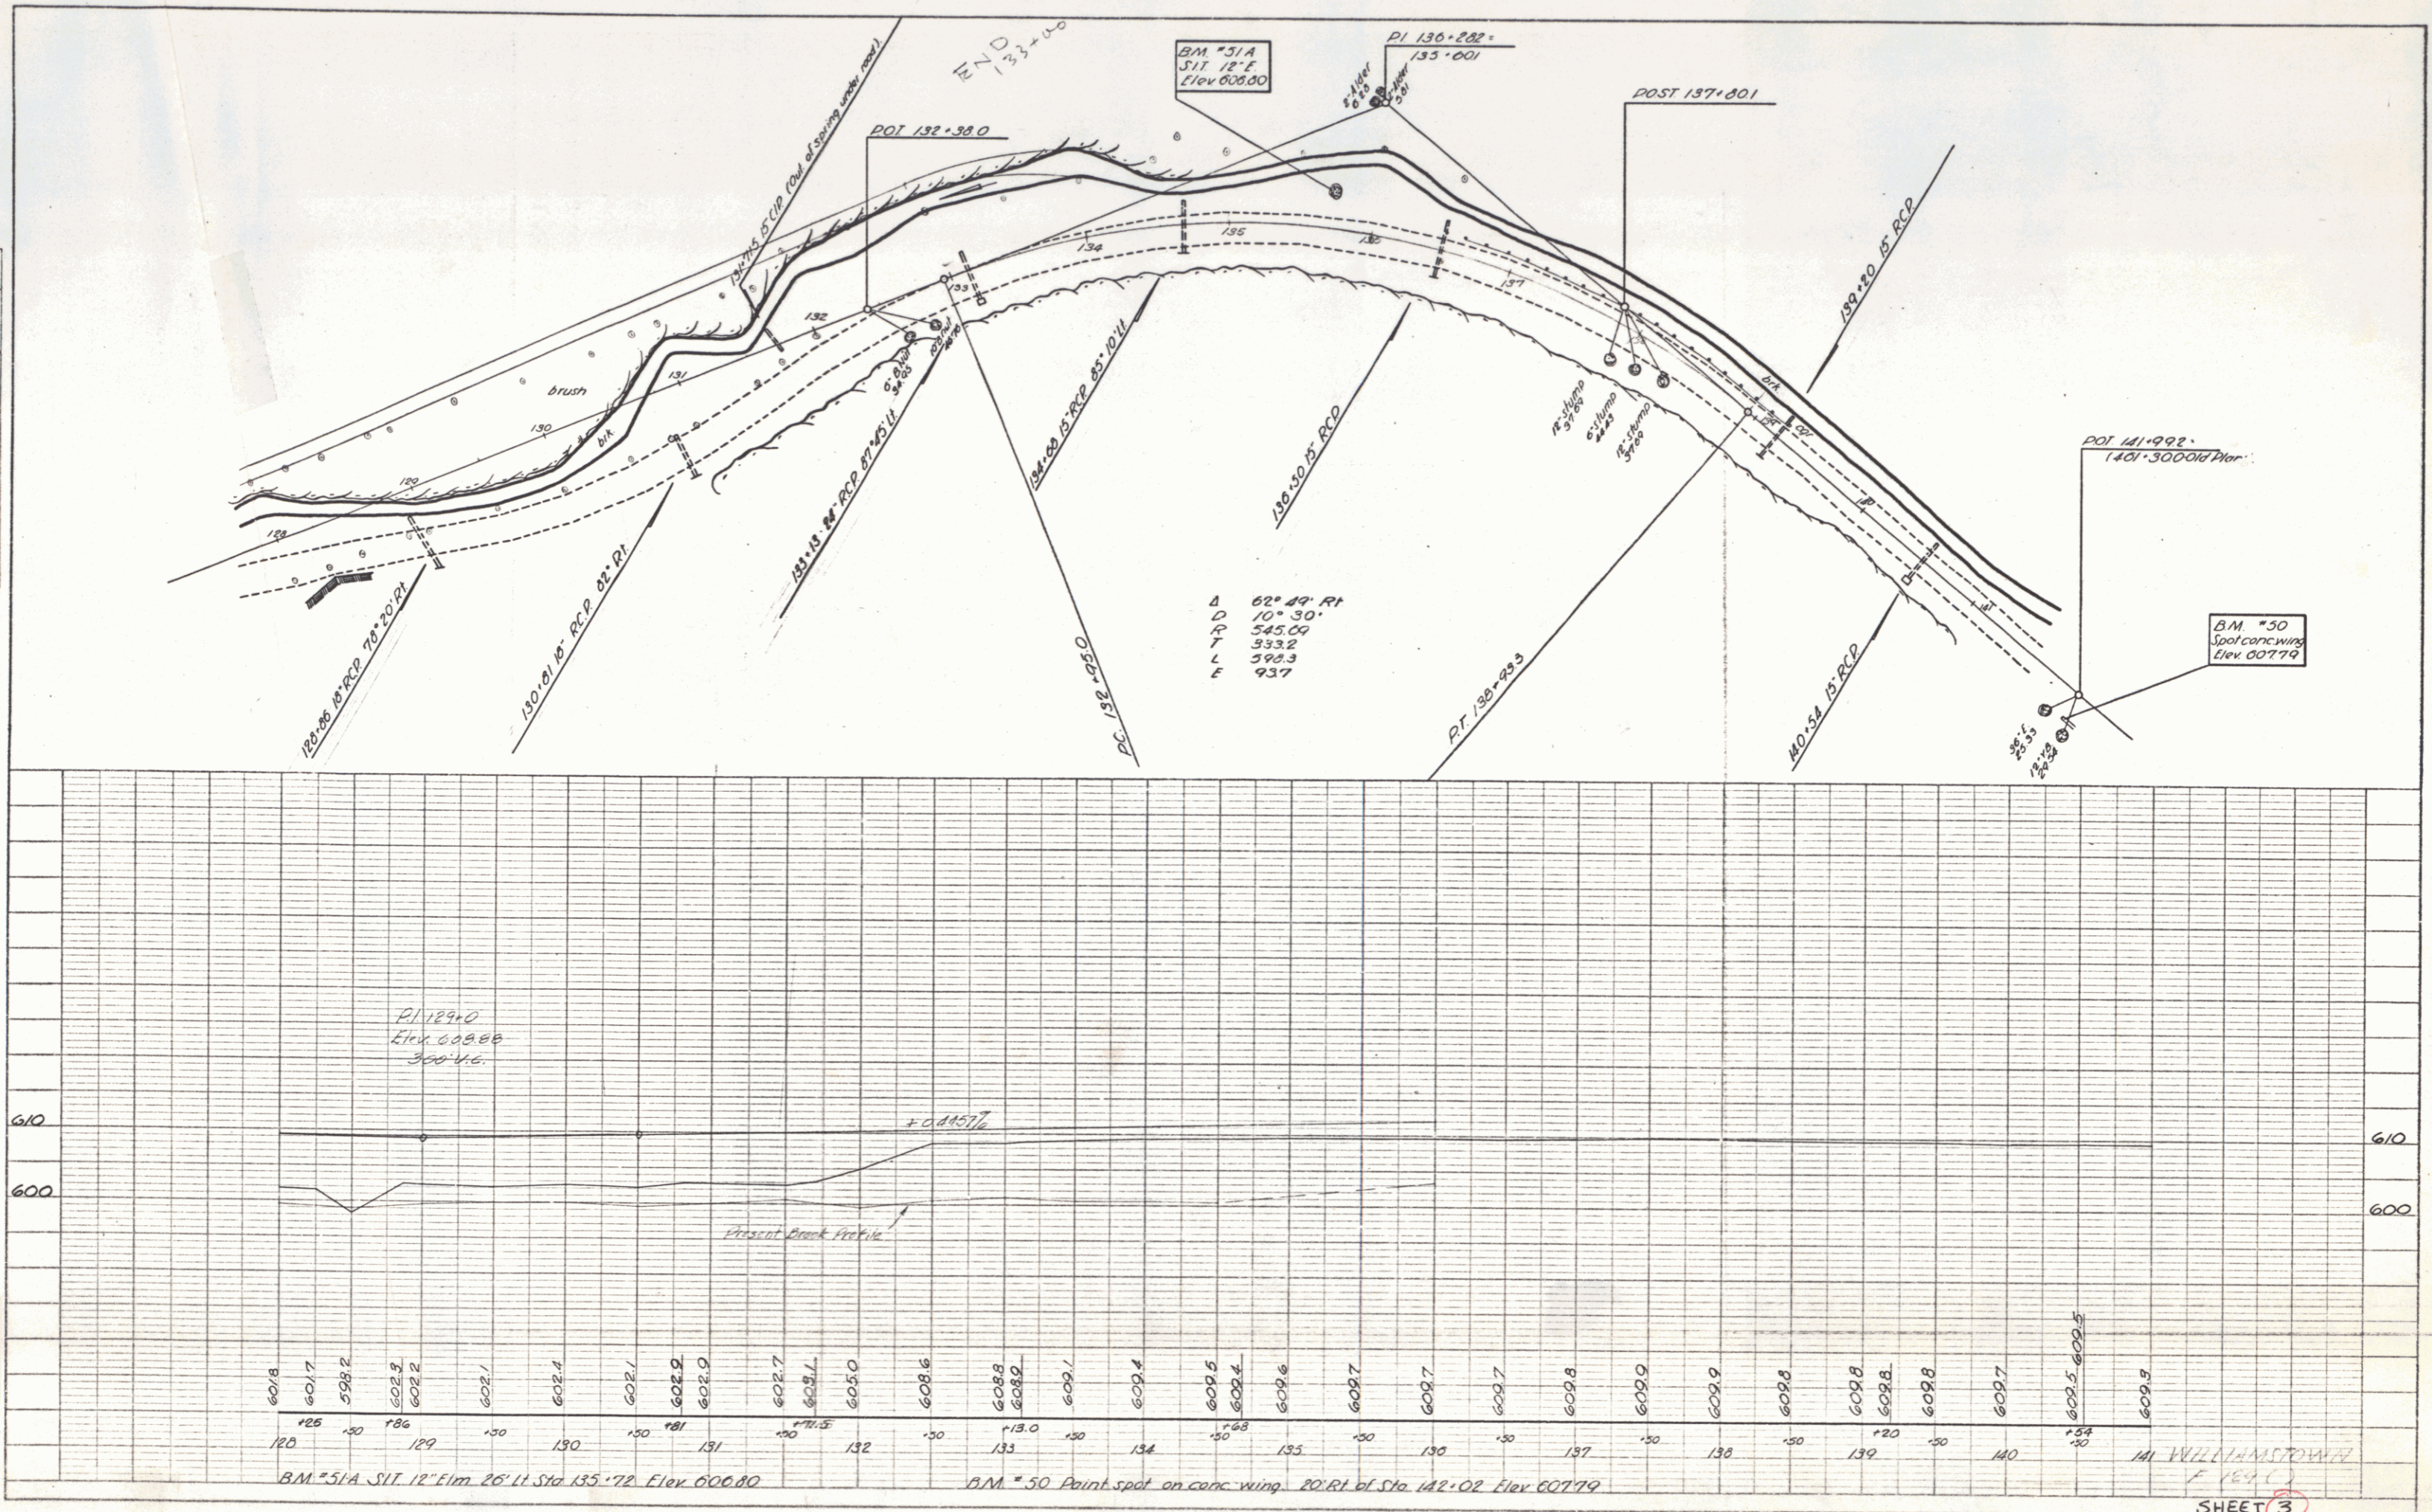

SHEET 3