

Limits of Clearing and Grubbing Item 104  
 Sta 349+00 to 350+00 Lt. 49° 41' - 35° 0' 58" Lt.  
 Sta 349+00 to 350+00 Rt. 35° 0' 00" - 35° 0' 57" Rt.

Construct Drives  
 360+25 Rt.  
 356+00 Lt. & Rt.

2 Cable Guard Rail  
 345+85 - 347+29 Rt. - 144'  
 347+86 - 356+02 Rt. - 816'


Wood Guide Posts  
 356+25 - 359+93 - 24

Plank Guard Rail  
 355+68 - 356+00 Lt. - 32'

○ C. & R. TREE  
 ITEM 110

PLAN NO.	STATE	FED. AID PROJECT	FISCAL YEAR	SHEET NO.
1	VT.	6-41-423	1957	15

DATE	BY
10/21/55	J.E.B.
REVISIONS	
1	As Shown
2	As Shown
3	As Shown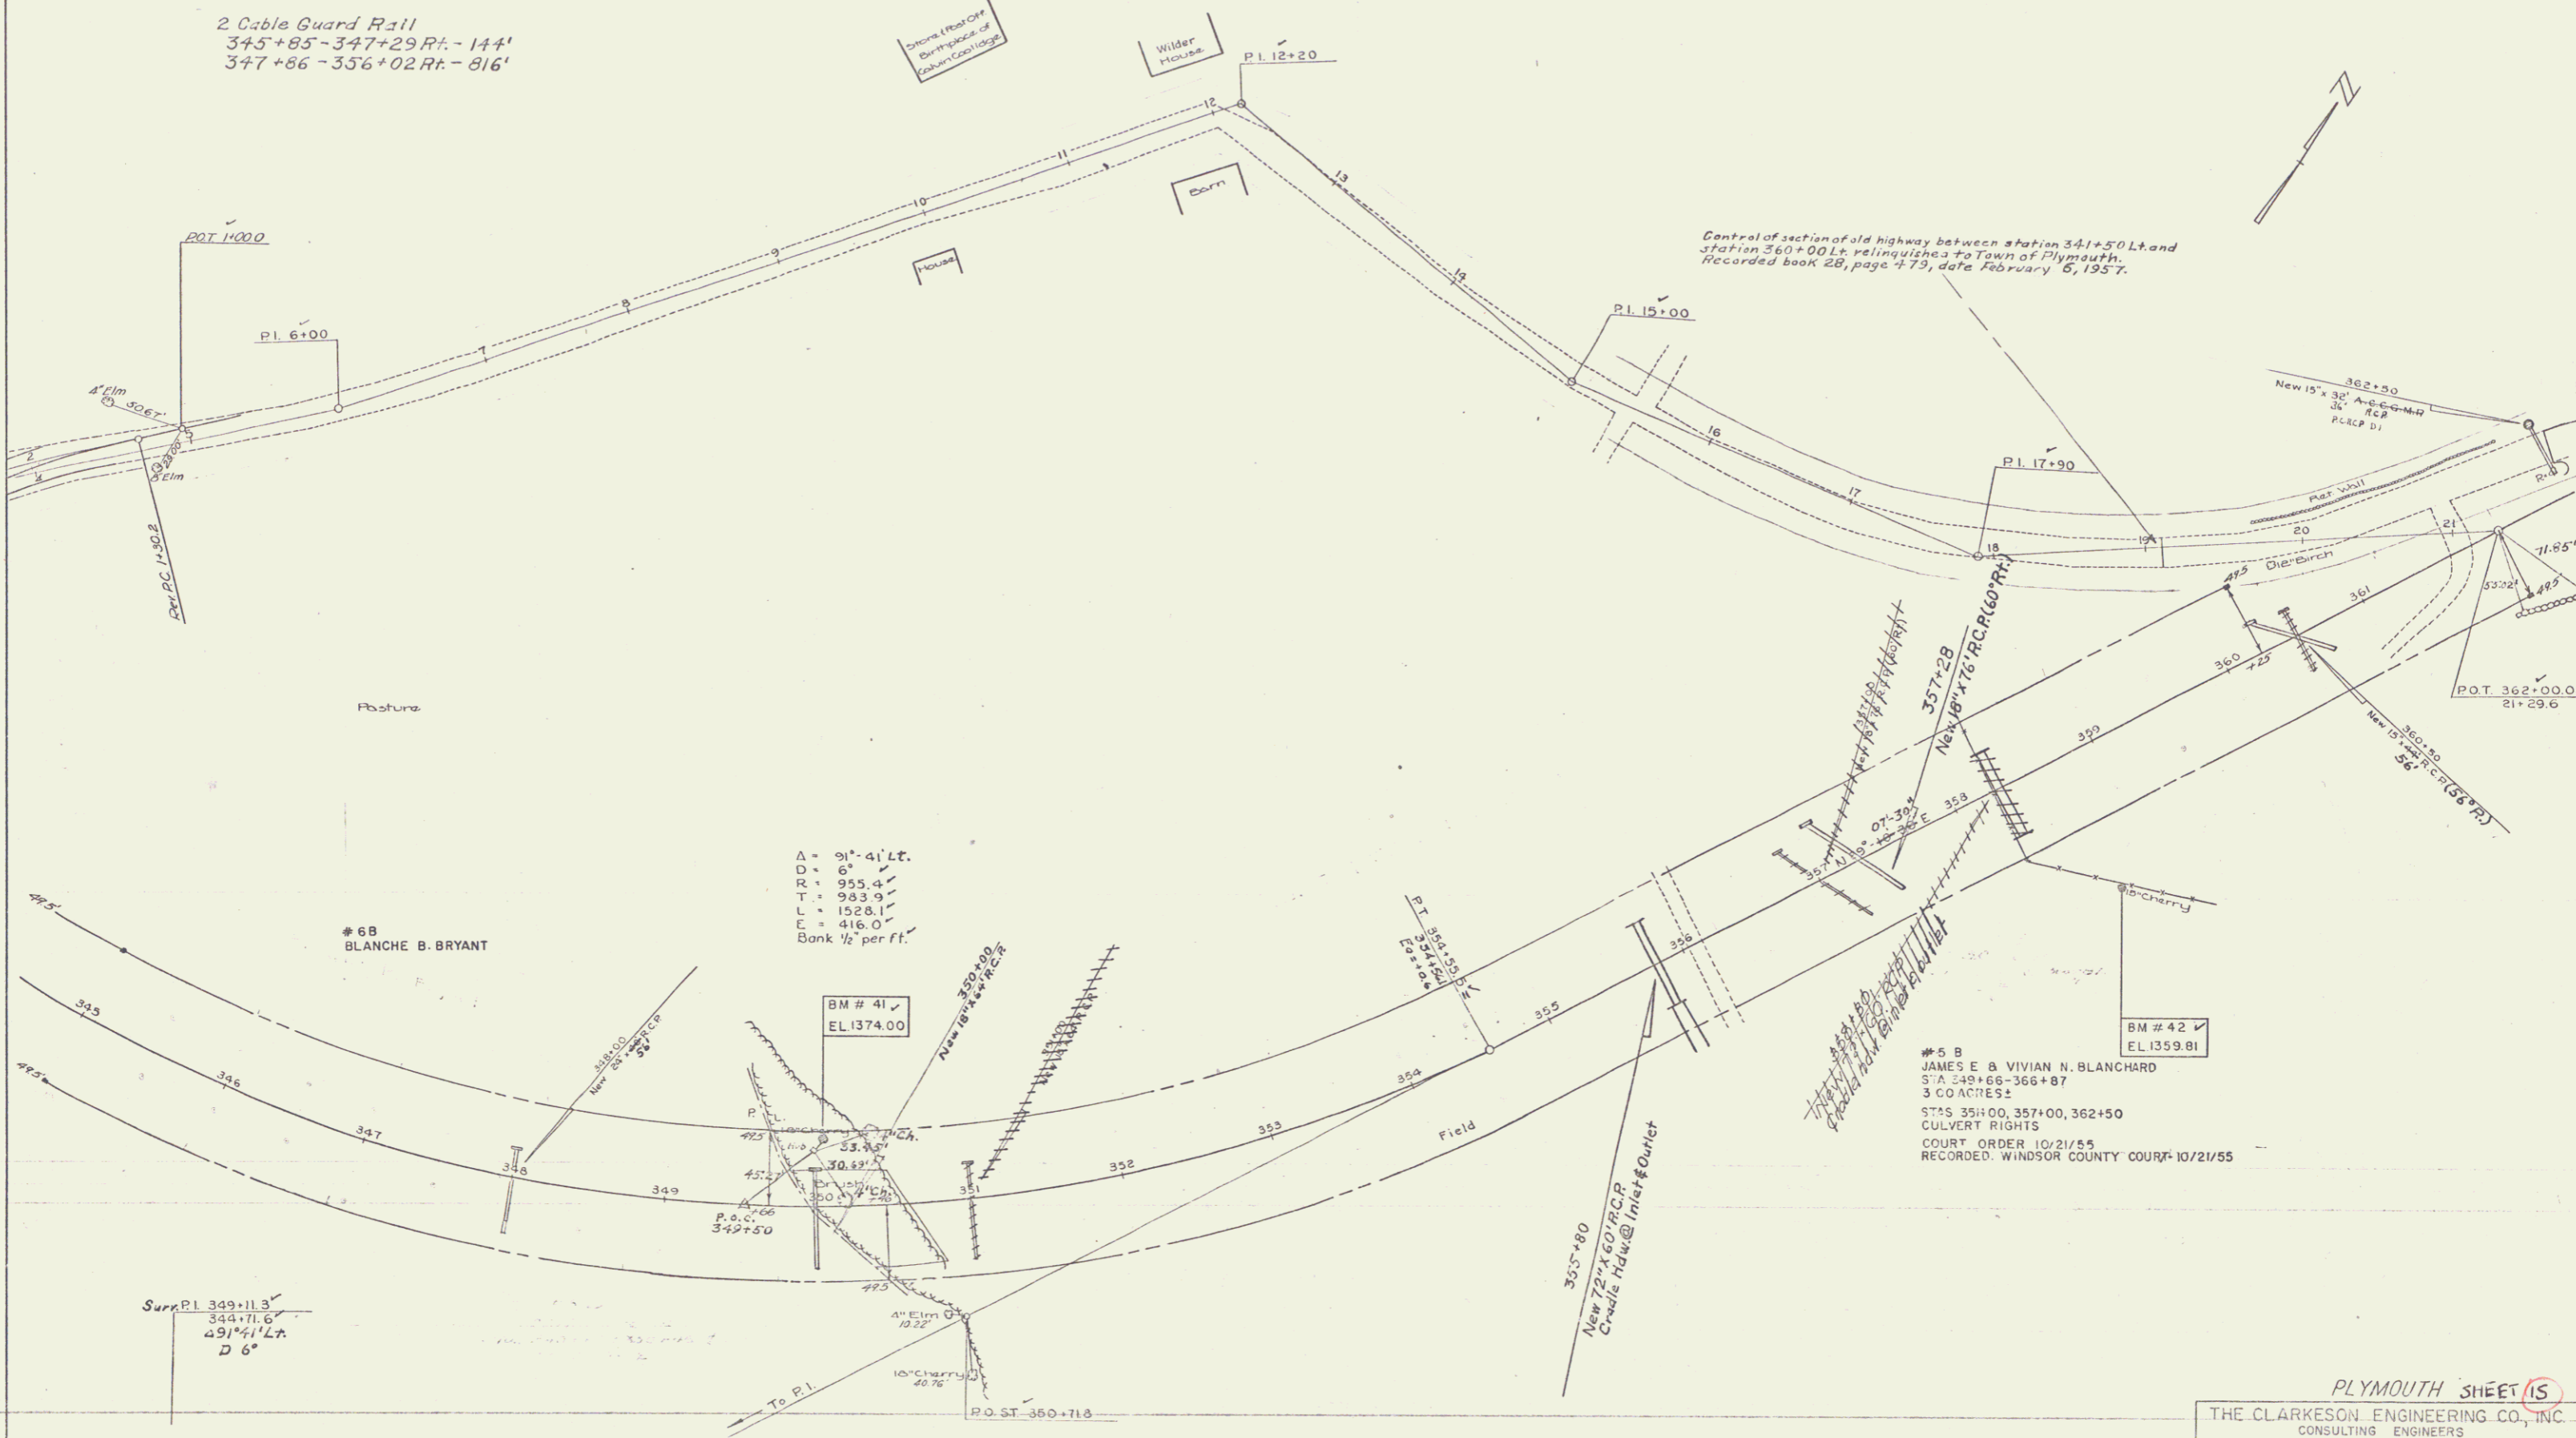
PLYMOUTH SHEET 15  
 THE CLARKSON ENGINEERING CO., INC.  
 CONSULTING ENGINEERS  
 BOSTON MASSACHUSETTS