



New Posts - Resetting Cable  
492+49 - 493+07 Lt. - 4'

P.I. 483+39.4  
482+85.7

Removing & Resetting C.G.R. C. & R. TREE  
ITEM 110  
492+33 - 492+75 Lt. - 42'  
492+49 - 493+07 Rt. - 58'

Limits of Stone Fill for Slope Protection  
Item 521C  
Construct Drive  
Sta. 496+40 Rt. 4.83 x 25' Lt.

Removal & Disposal of G.R.  
496+75 - 497+15 Rt. - 40'

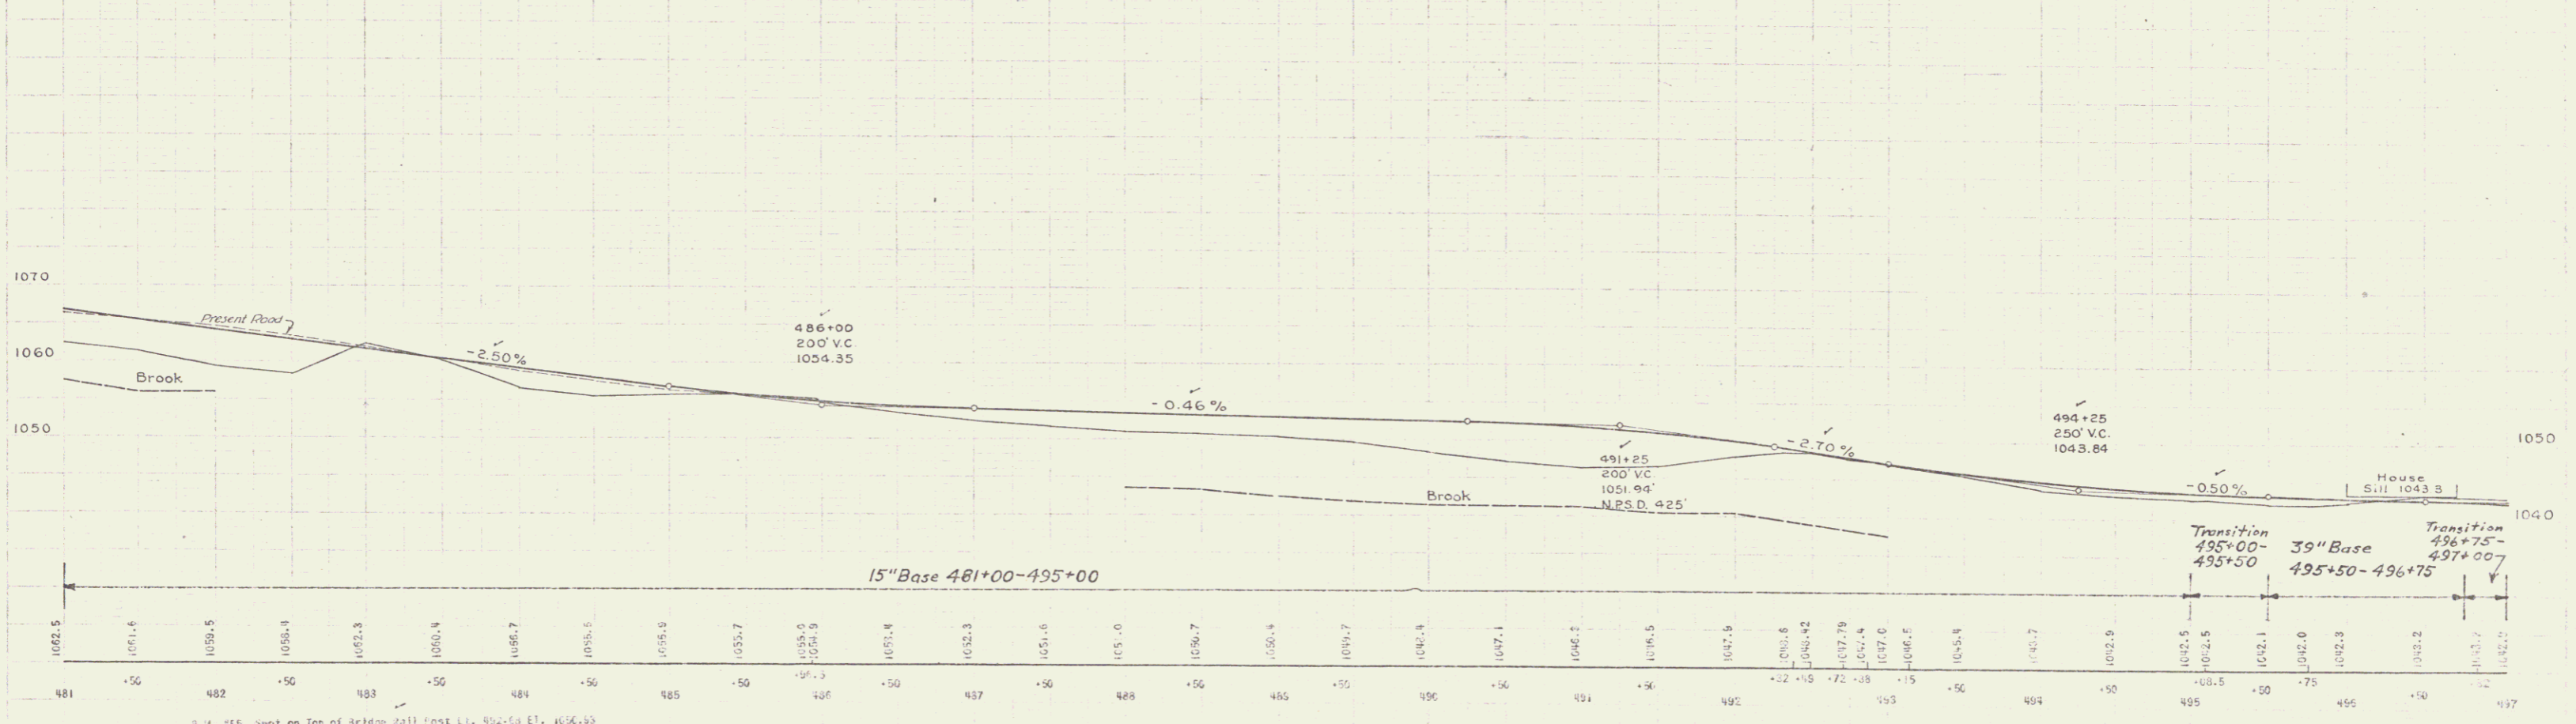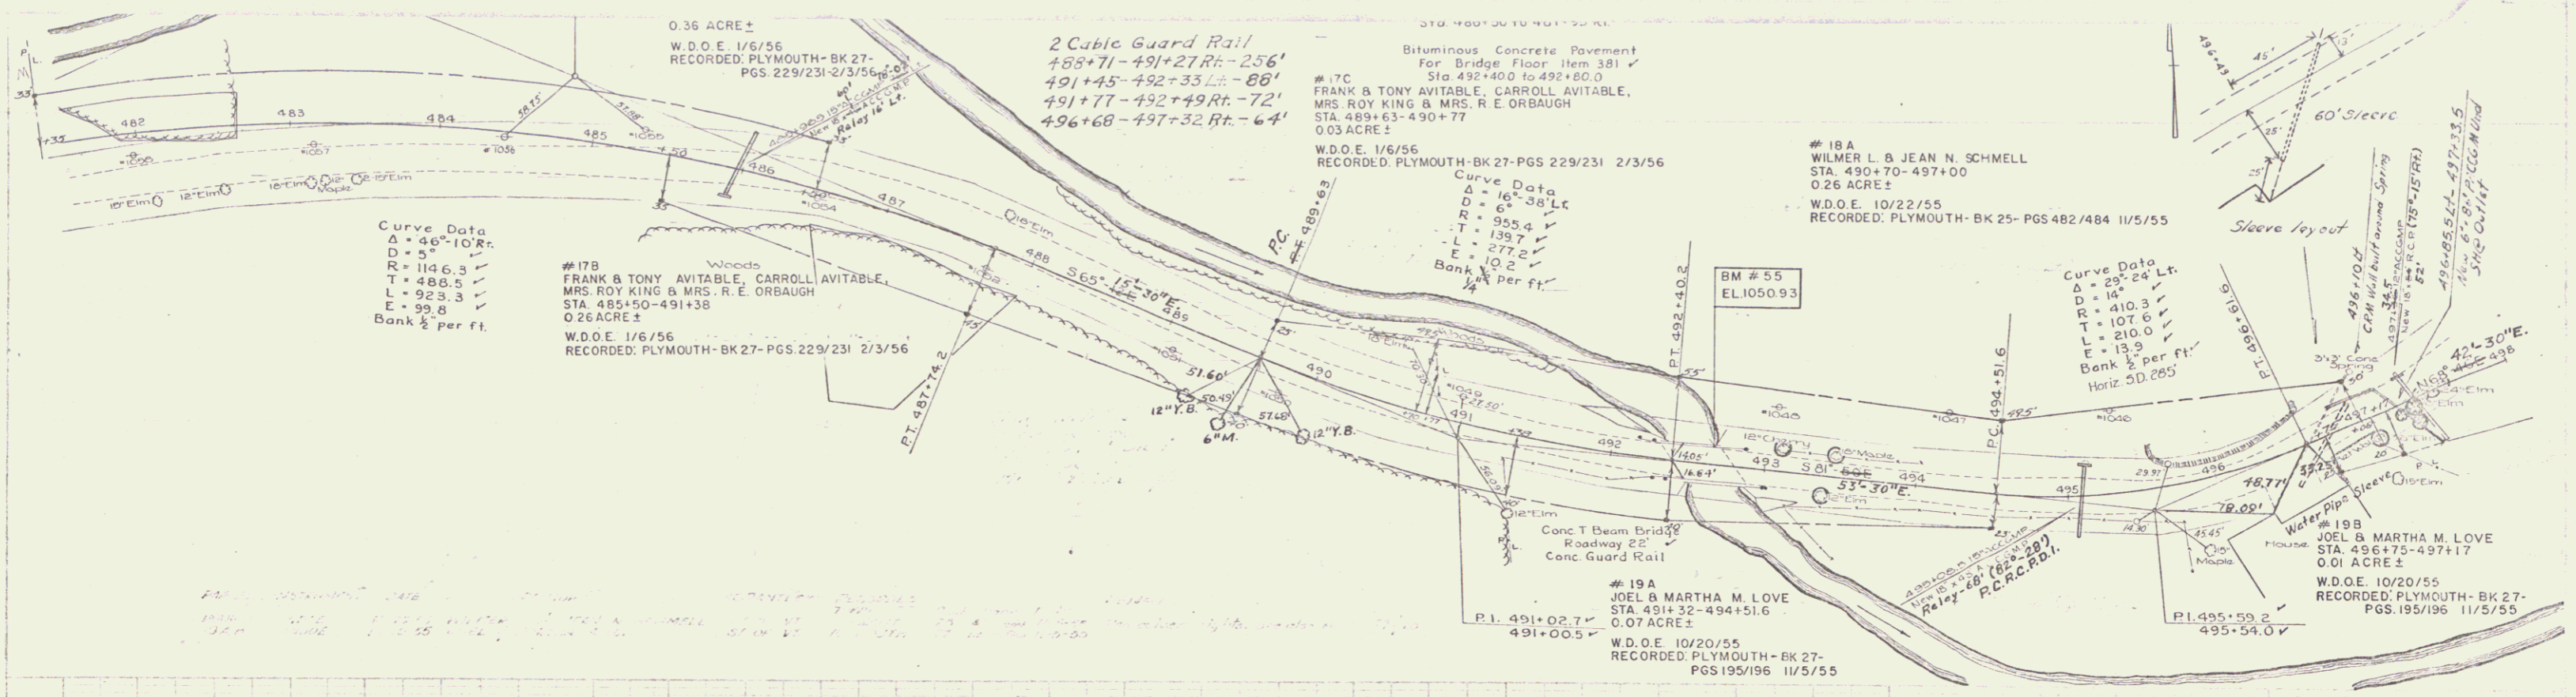

Sheet 355 - sheet on Top of Bridge (all) from L.L. 492+58 Et. 1056.55