

Sta. 528+00 Lt.
533+00 Rt.
534+30 Rt.

Construct Drive
Sta. 528+00 Lt.
533+00 Rt.
534+00 Rt.
534+75 Rt.

Construct Approach
Sta. 528+20 Lt.

C. & R. TREE
ITEM 110

Limits of Stone Fill for Slope Protection
Item 921C
Sta. 526+25 to 528+25 Rt.
Sta. 536+75 to 539+75 Rt.
529+00 - 528+35 Rt.

Channel Excavation Item 106A
Sta. 536+75 to 539+25 Rt.
534+70 - 539+30 Rt.

Limits of Clearing and Grubbing Item 104
Sta. 534+60 to 538+35 Rt.
536+25 - 537+00 Rt.
535+00 - 538+30 Lt.
536+75 - 539+00 Rt.

2 Cable Guard Rail
528+00 - 530+03 Rt. - 203'
530+47 - 533+19 Rt. - 272'
536+10 - 540+02 Rt. - 392'

Curve Data
Δ=67°09' Lt.
D=10°
R=573.7
T=300.0
L=671.5
E=114.9
Bank 1/2" per ft.



21C
EDWIN R. & BEULAH N. PUTNAM
STA. 534+50 - 538+90
0.35 ACRE ±
W.D.O.E. 10/20/55
RECORDED: PLYMOUTH - BK 27 - PGS 197/198 - 11/5/55

23 B
HERBERT C. RICHARDSON
STA. 529+75 - 532+09
0.04 ACRE ±
W.D.O.E. 10/22/55
RECORDED: PLYMOUTH - BK 27 - PGS 203/204 11/5/55

23 A
HERBERT C. RICHARDSON
STA. 527+66 - 530+97
0.16 ACRE ±
W.D.O.E. 10/22/55
RECORDED: PLYMOUTH - BK 27 - PGS 203/204 11/5/55

20B
HARRY RICHARDSON
STA. 530+97 - 531+90
0.09 ACRE ±
COND. 7/27/55
RECORDED: PLYMOUTH - BK 28 - PGS. 360-378 7/28/55

24
LYMAN B. LUVIA MAY GRIGGS
STA. 531+90 - 540+07.7
0.81 ACRE ±
STA. 540 ±
CULVERT RIGHTS
W.D.O.E. 10/22/55
RECORDED: PLYMOUTH - BK 27 - PGS 205/206

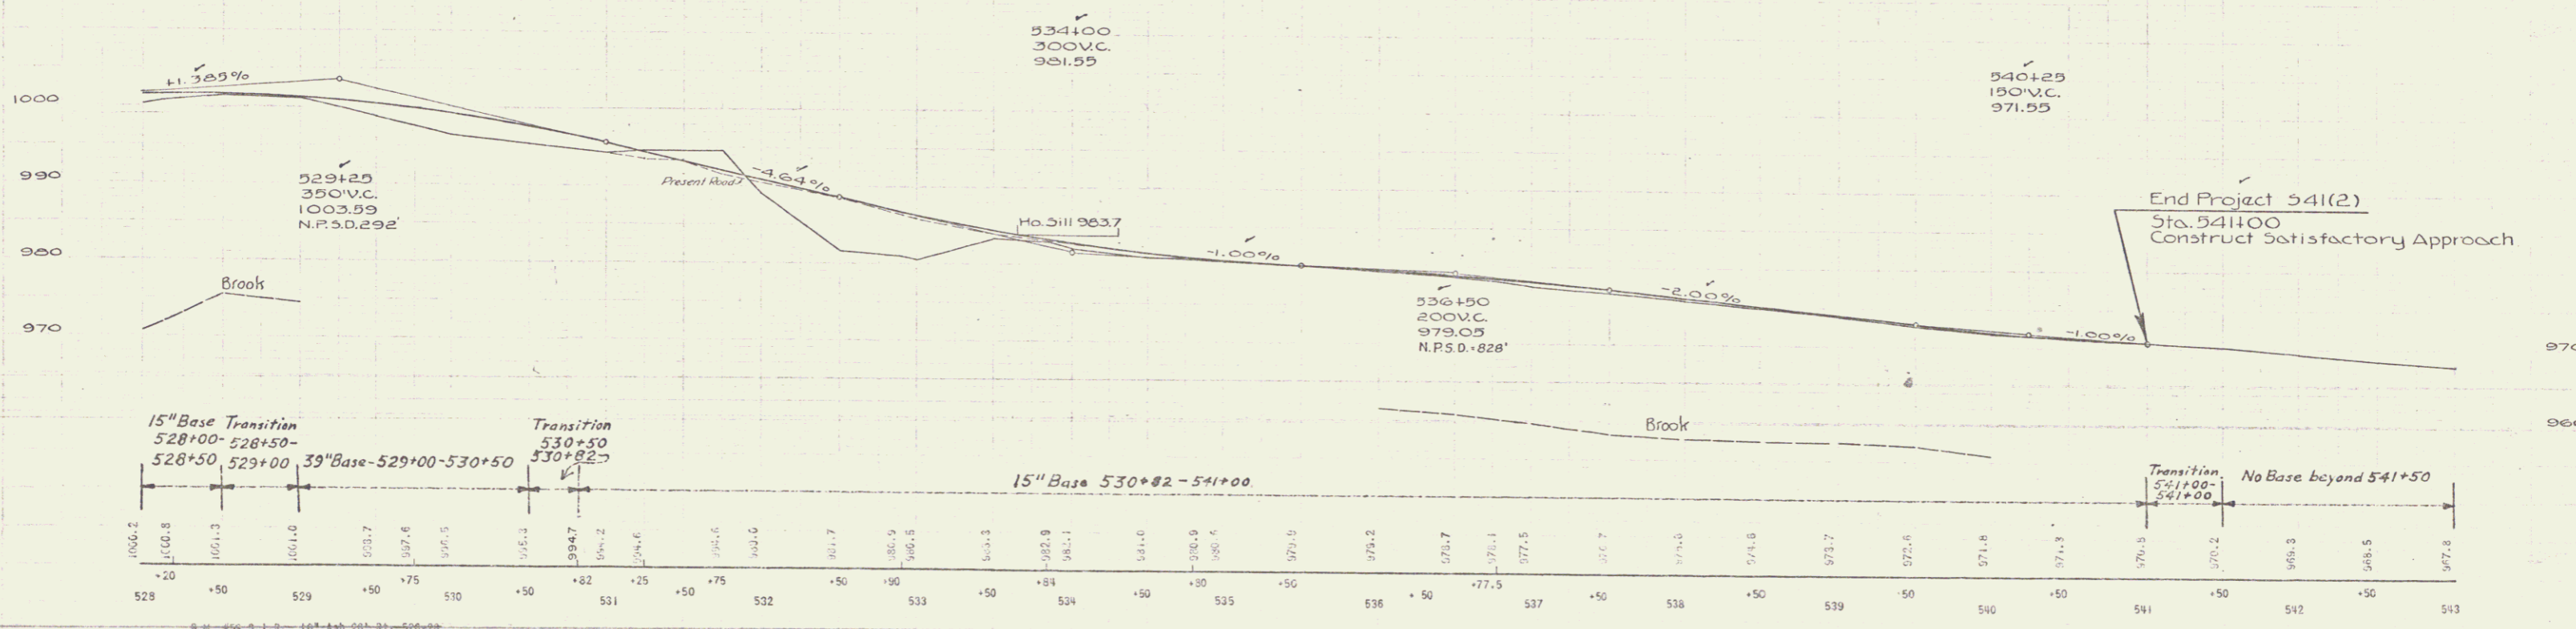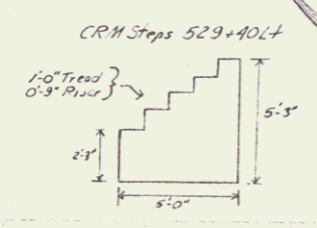

End Project 541(2)
Sta. 541+00
Construct Satisfactory Approach

Project Marker
541+00 Rt.

End Project 541(2)
Sta. 541+00
Construct Satisfactory Approach