

PROJECT NUMBER	BRIDGEWATER 541(3)	LENGTH	1.383 MI.
TYPE	Dbl. Th. Ct. Ret. Tow. Boston, Cal.	YEAR	19 56
CONTRACTOR	Baslow Const. Corp.	LOCATION	Beginning 130 ft. sou. side of intersection of W. 100th and U.S. 4 and extending southerly 730.22 ft.




PROJECT BRIDGEWATER 541(3)
 CONTRACTOR BASLOW CONST CORP
 RECORD PLANS J.R. PHALEN
 CONST COMPLETED OCT 24, 1956

GROUND ELEVATION	DATUM	LINE
GRADE ELEVATION	DATUM	LINE
CURVE DATA		
DEFLECTION OF ANGLE	Δ
DEGREE OF CURVE	D
RADIUS OF CURVE	R
TANGENT DISTANCE	T
LENGTH OF CURVE	L
EXTERNAL DISTANCE	E
POINT OF INTERSECTION	P.I.
POINT OF CURVE	P.C.
POINT OF TANGENT	P.T.
POINT ON TANGENT	P.O.T.
POINT ON SUB-TANGENT	P.O.S.T.

SCALES

TITLE	1" = 400'
TYPICAL	1" = 2'
PLAN	1" = 50'
PROFILE HORIZONTAL	1" = 50'
PROFILE VERTICAL	1" = 10'
CROSS-SECTIONS	1" = 5'

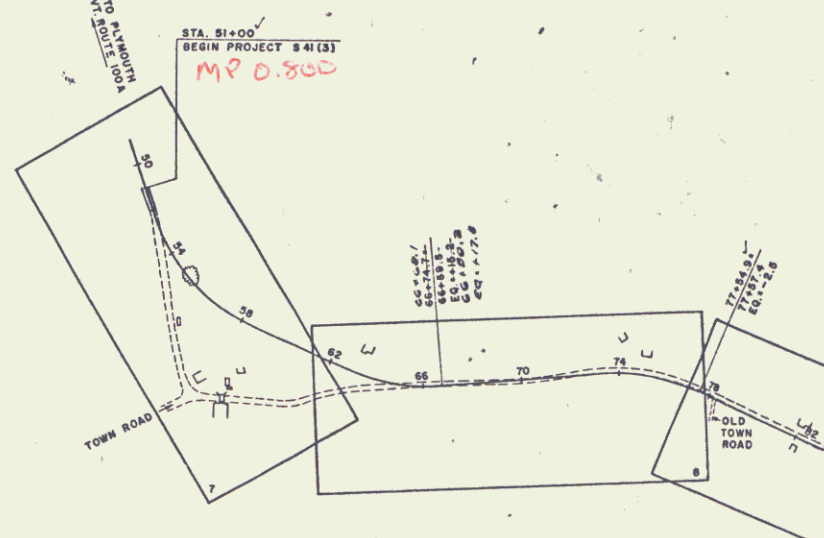

THE CL
 BOSTON
 APPROVED _____
 DATE _____