


Specifying
 A.A.
 B.M.
 10/54

651.00 ✓
 500' V.C.
 219.73

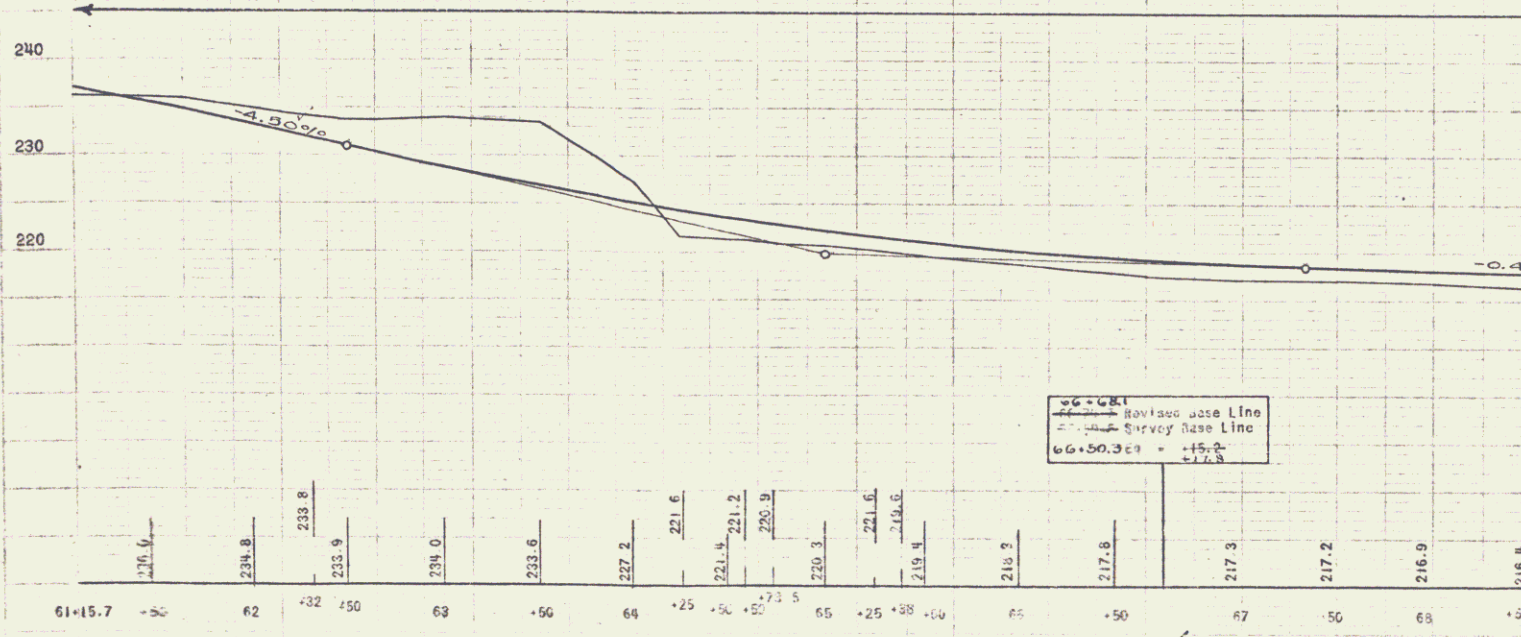

3.11 26 S.I.R. 24' El. 80' Rt. Sta. 63-97 El. 222.78

B.M. #9 S.I.R. 36' Manle 30' Lt. Sta. 72-68 El. 222.24