


Jewett
 P.M.
 D.M.
 9/54

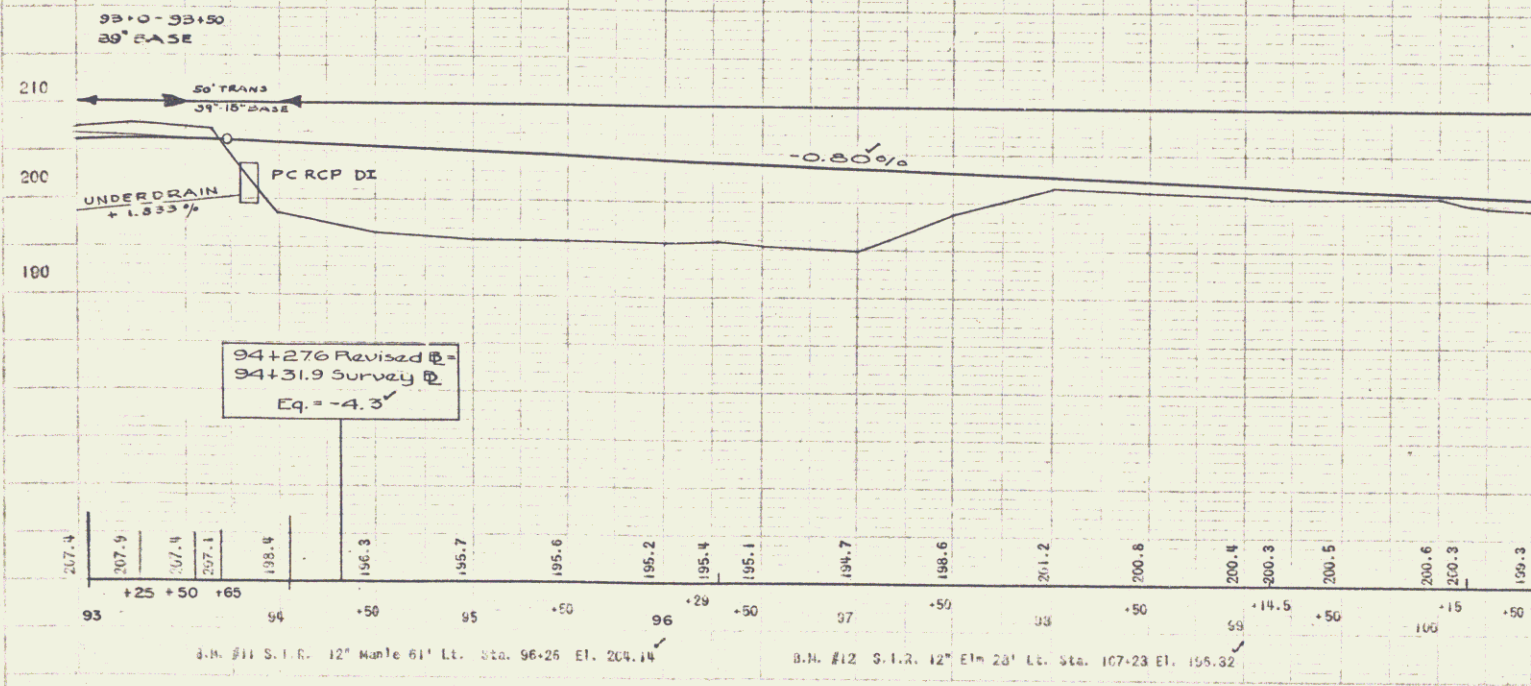

2/22