


9/54
B.M.

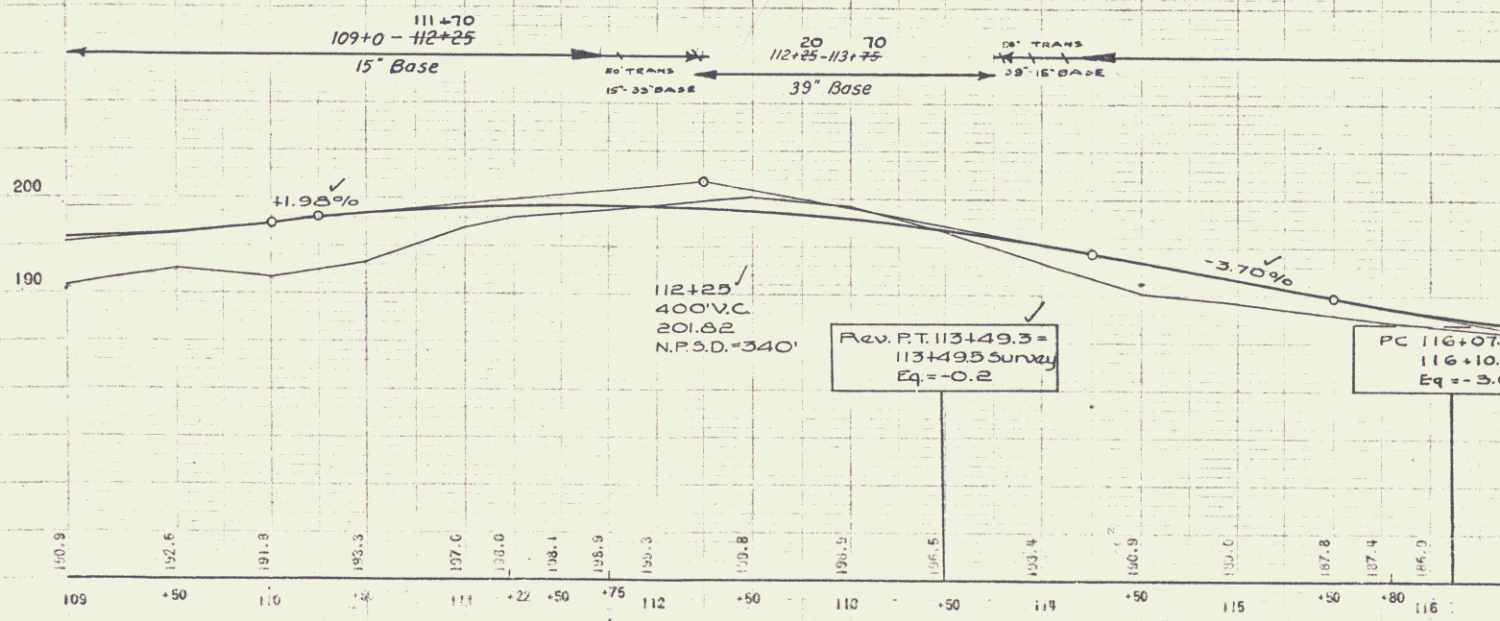

B.M. #13 Spot on Cora Bridge Lt. Sta. 119+63.5 El. 188.65