


OFFSETS - CURVE # 9

STATIONING	DIET. FT.
94+00	0.0'
94+10	0.7'
95+00	2.5'
95+10	3.5'
96+00	2.7'
96+10	0.3'
96+25	0.0'
99+50	0.0'
100+00	2.2'
100+50	4.0'
101+00	5.0'
101+25	5.8'
101+50	6.0'
102+00	5.0'
102+25	4.8'
102+50	4.5'
103+00	3.2'
103+50	1.5'
104+00	0.0'

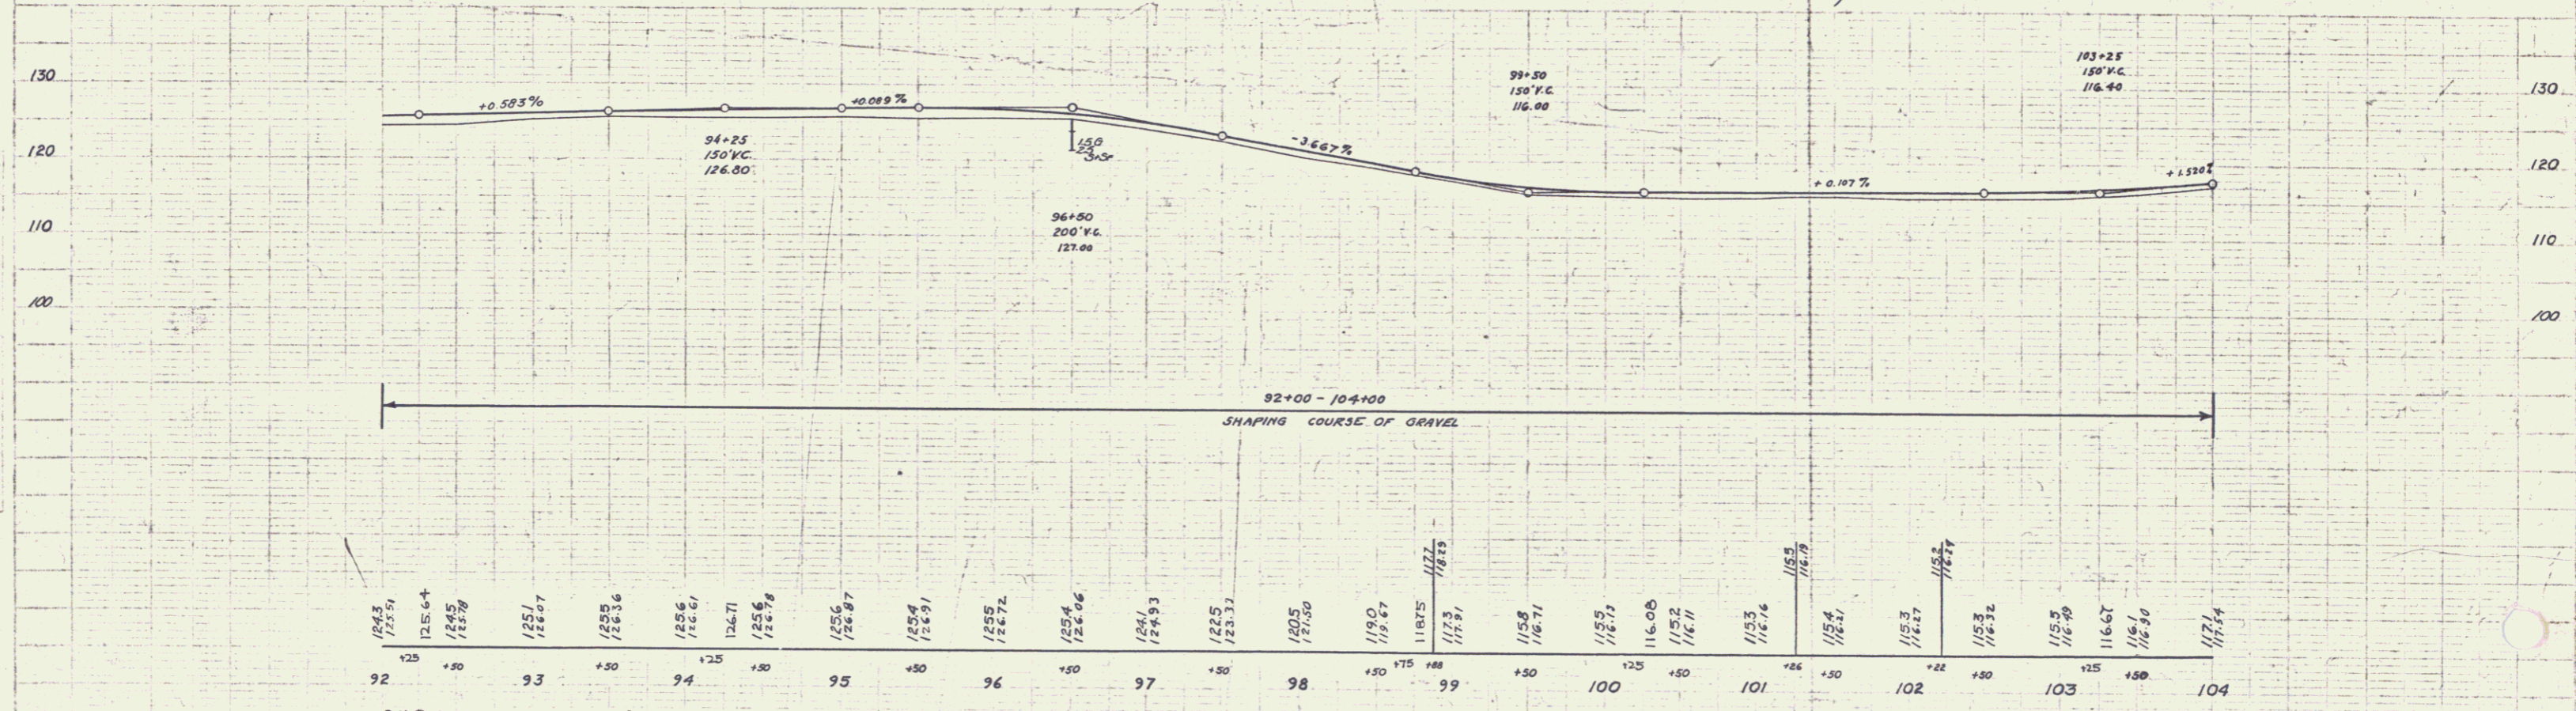

B.M. # 10 SPIKE IN ROOT OF 18' MAPLE 13' LT. OF STA. 95+04 ELEV. 124.83

5