


Relinquished TO MORETOWN
 6-21-1935
 MORETOWN LAND RECORDS
 Q 23 P 514
 216-35

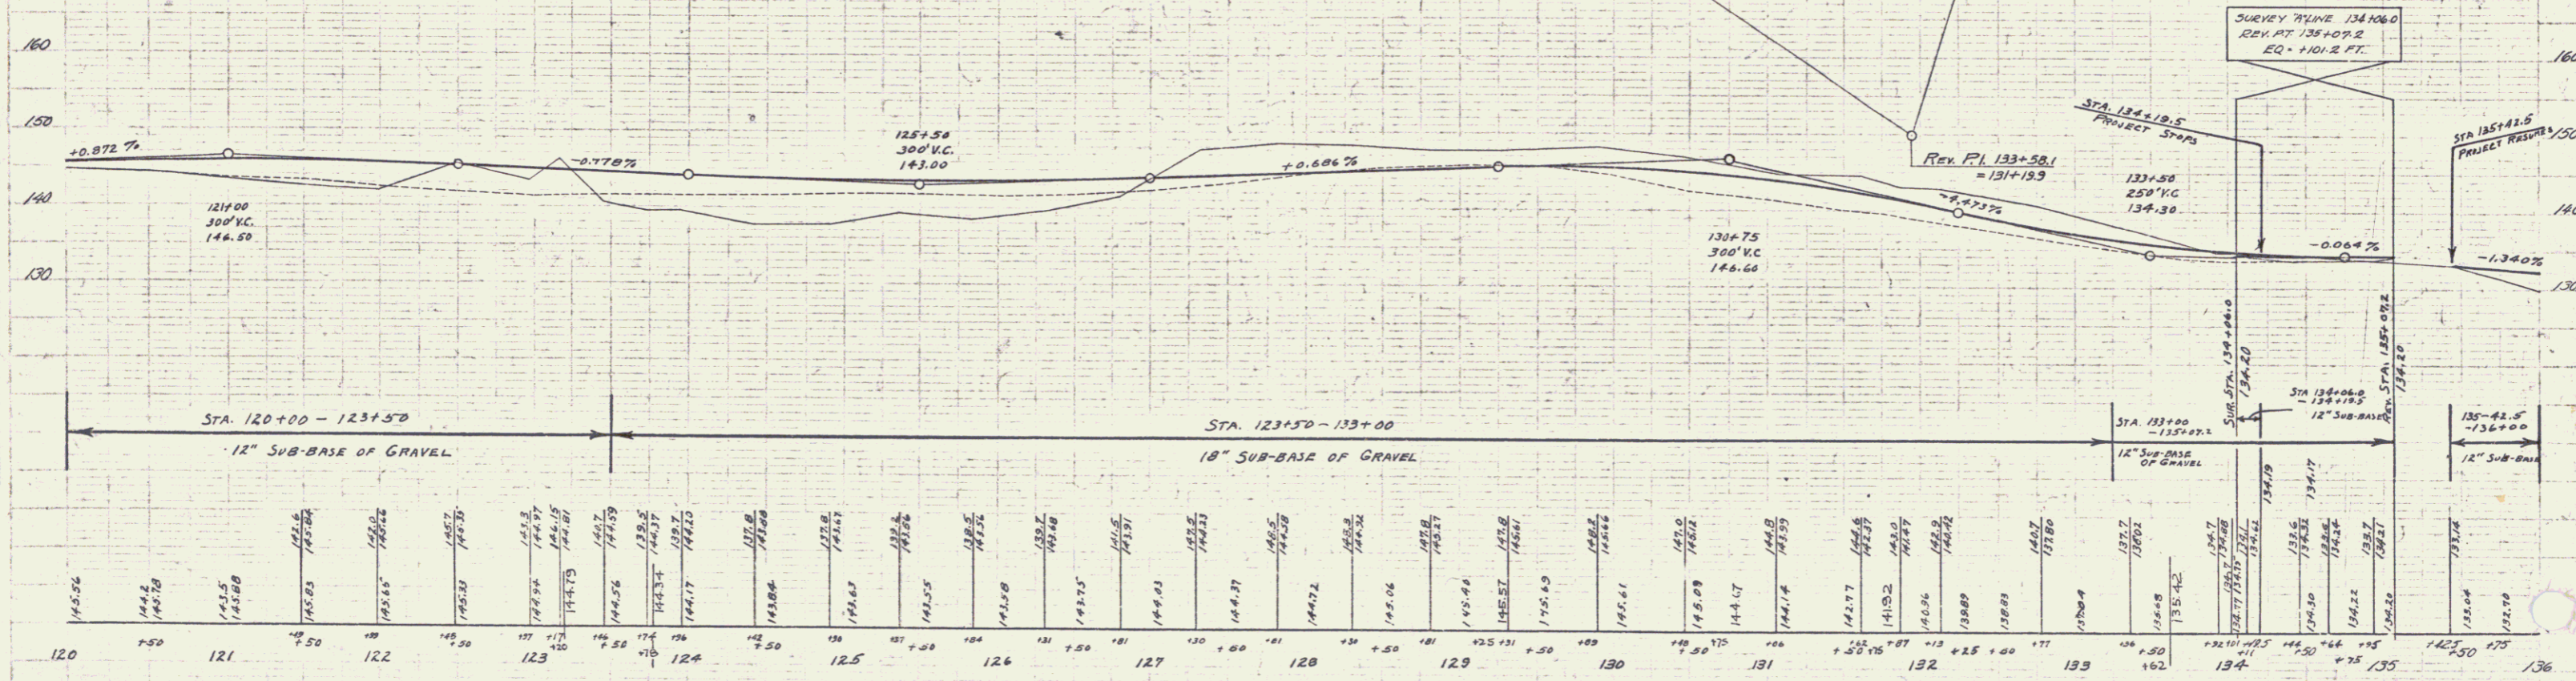

120 121 122 123 124 125 126 127 128 129 130 131 132 133 134 135 136

BM 13 SPOT ON CONC BRIDGE ADJUTMENT 16' LT. OF STA. 134+21 ELEV. 133.75

SURVEY PL. 133+58.1
 REV. PT. 131+19.3

SURVEY PL. 134+06.0
 REV. PT. 135+07.2
 EQ. 101.2 FT.

STA. 134+19.5 PROJECT SPAN
 STA. 135+41.5 PROJECT SPAN

12" SUB-BASE OF GRAVEL

18" SUB-BASE OF GRAVEL

12" SUB-BASE OF GRAVEL

12" SUB-BASE OF GRAVEL

12" SUB-BASE OF GRAVEL

SERIES N.C. 157 (1935)
 SHEET 3 OF 39