
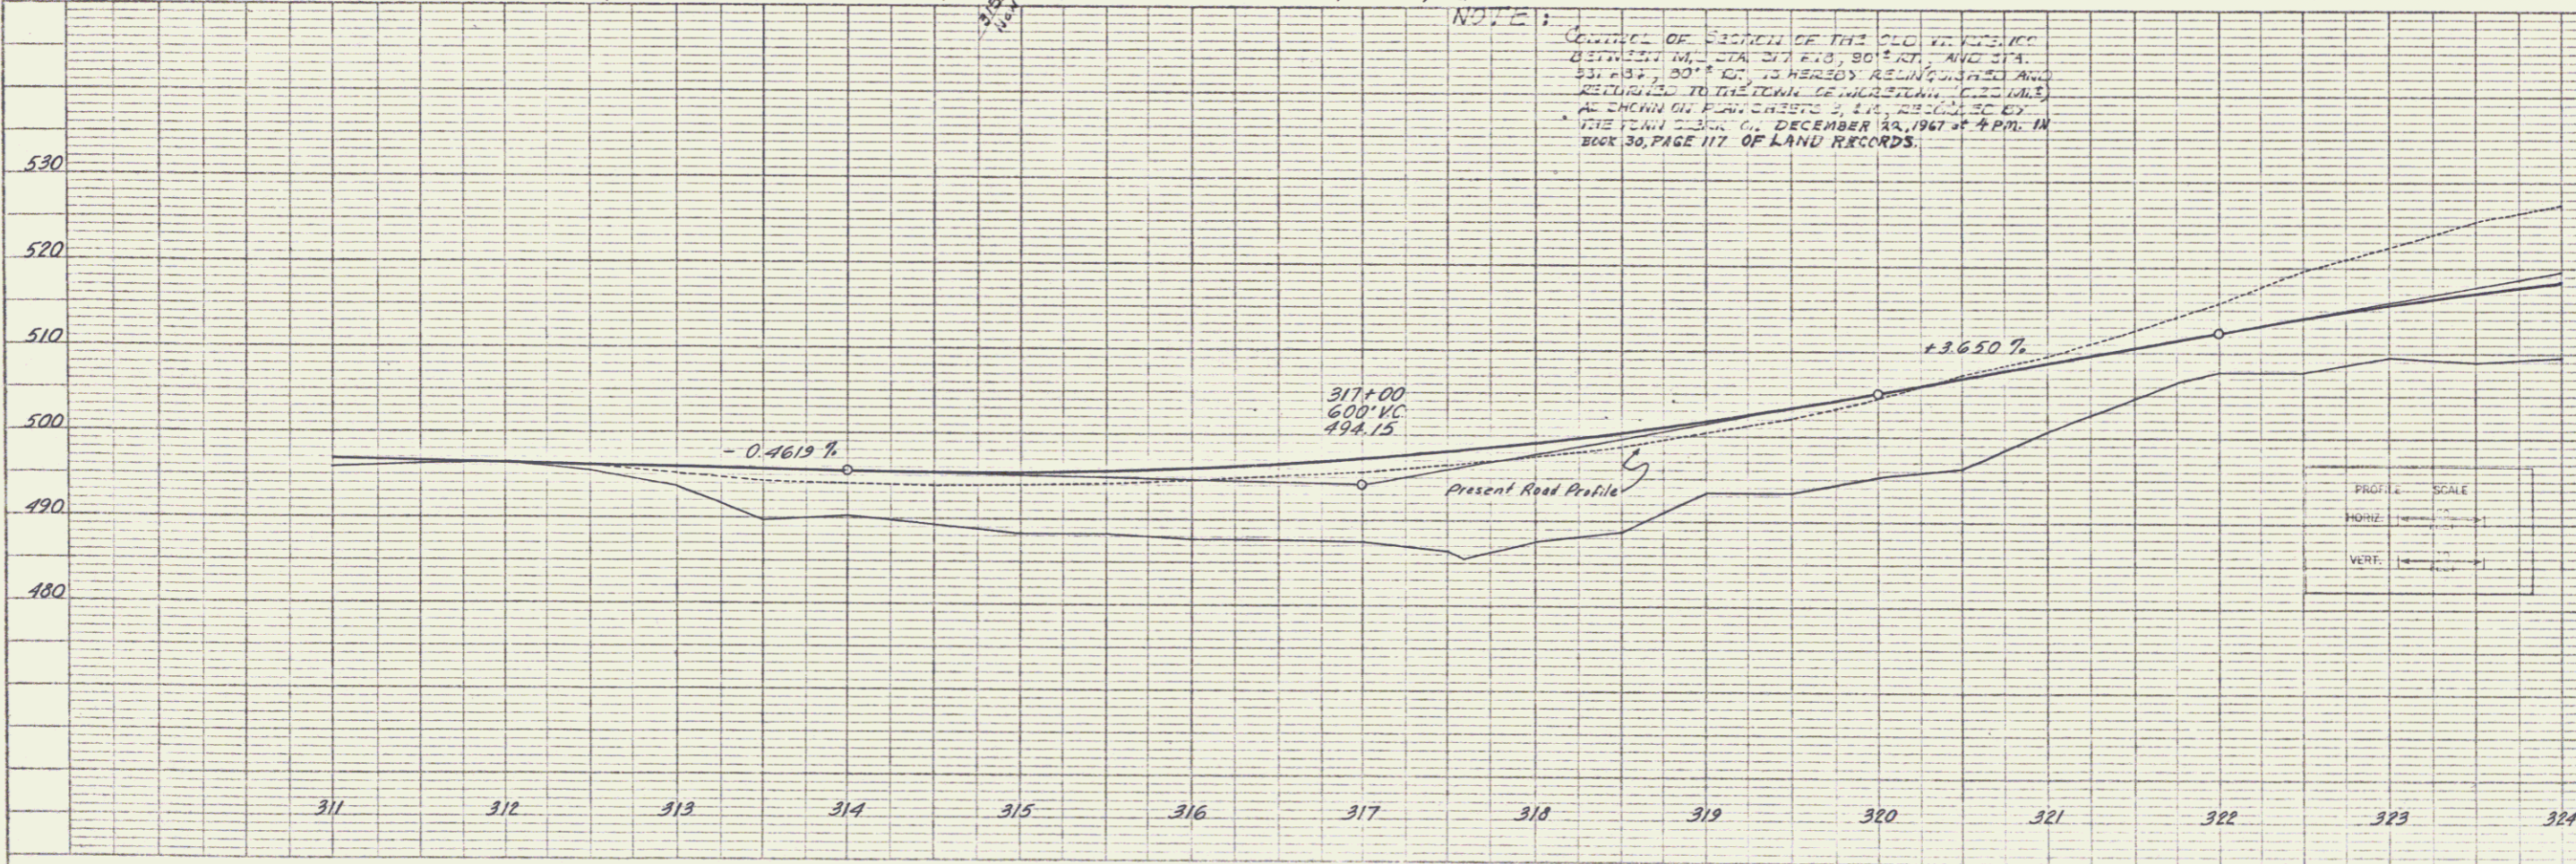


PLAN
 DRAWN BY: A. Gagnon
 CHECKED BY: A. Gagnon
 DATE: 11/13/17

PROFILE
 DRAWN BY: A. Gagnon
 CHECKED BY: A. Gagnon
 DATE: 11/13/17

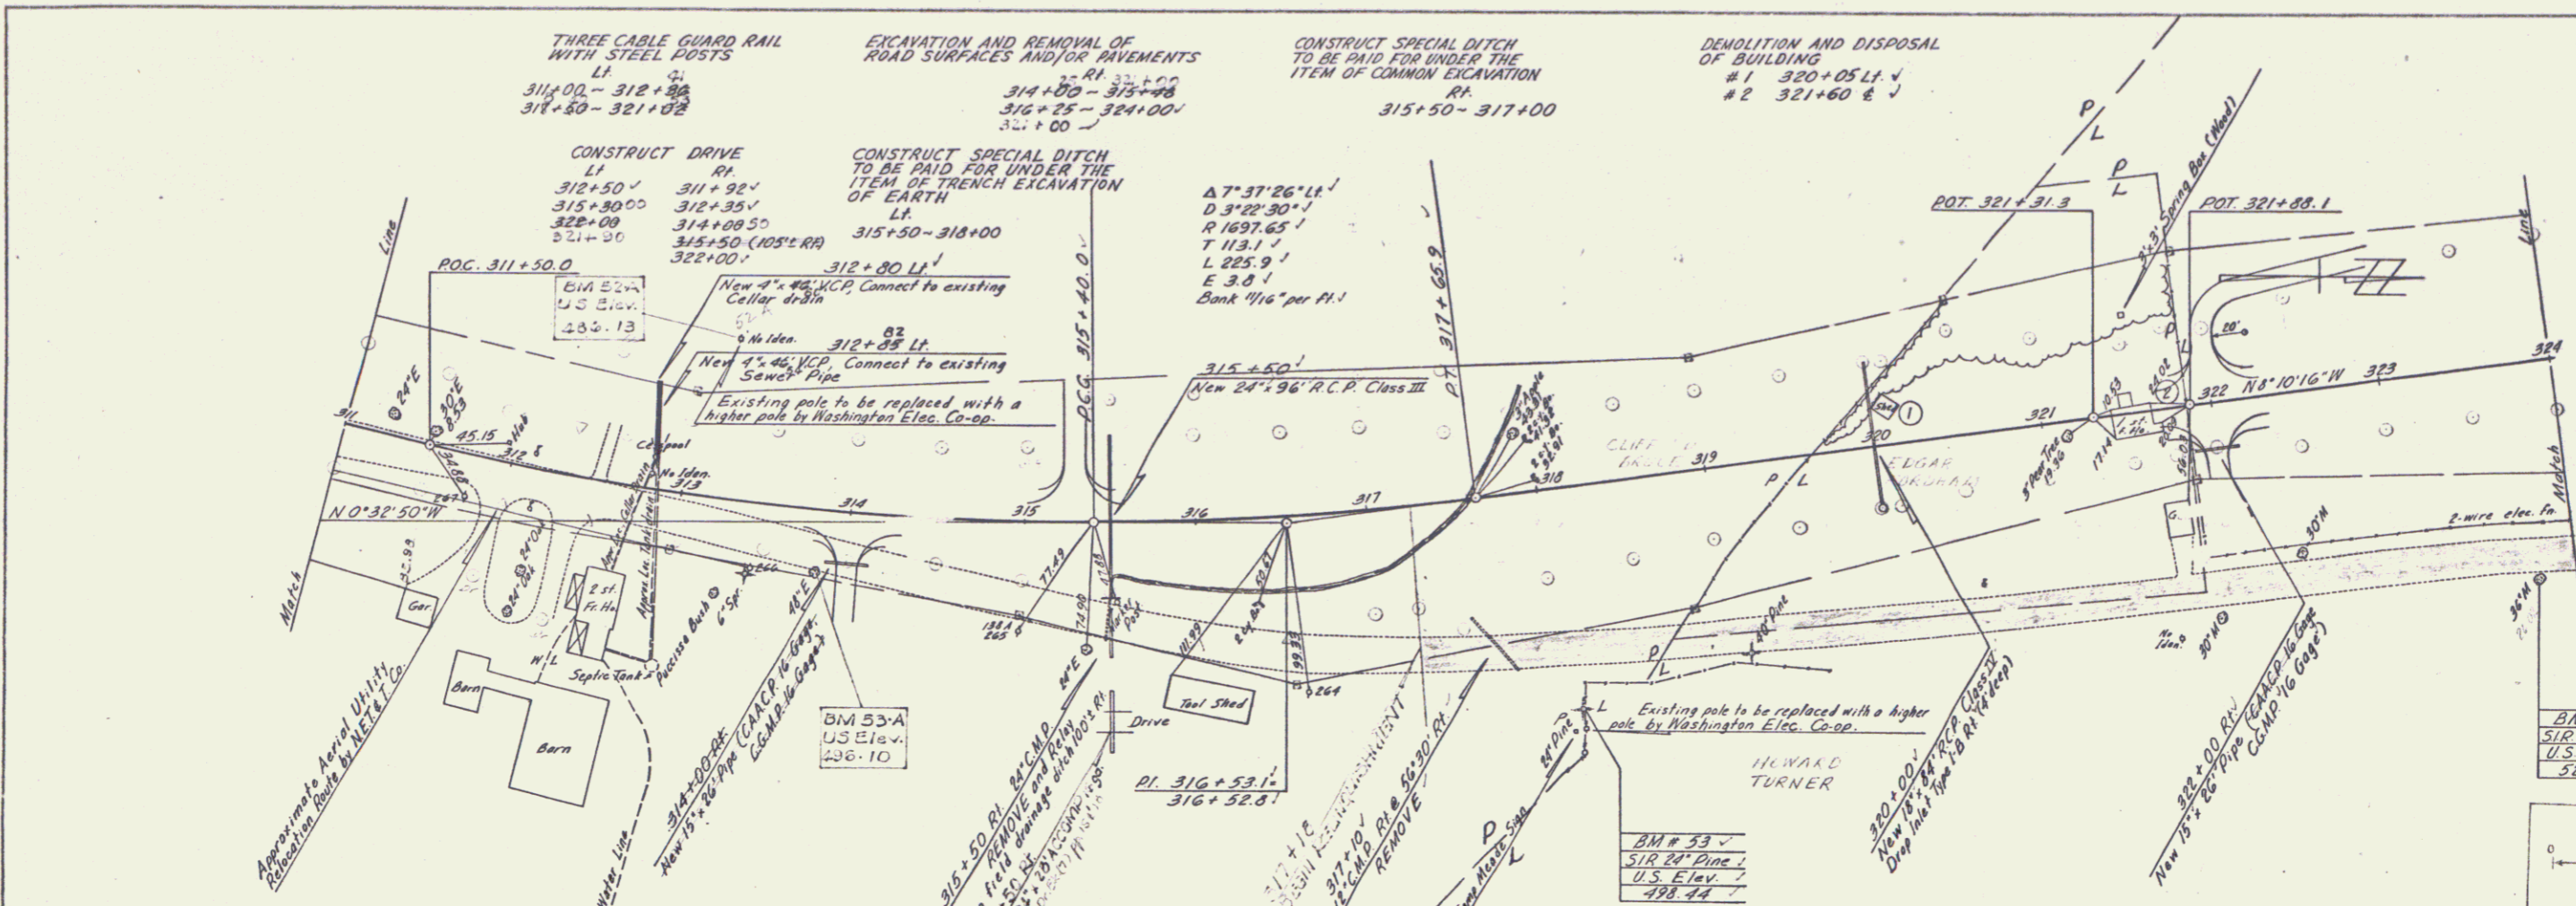

MORETOWN
 Project S.N. 0167 (7)
 Sheet 9 of 39