



PLAN  
 DATE: 10/15/81  
 DRAWN BY: A. Griffin  
 CHECKED BY: A. Griffin  
 TITLE:

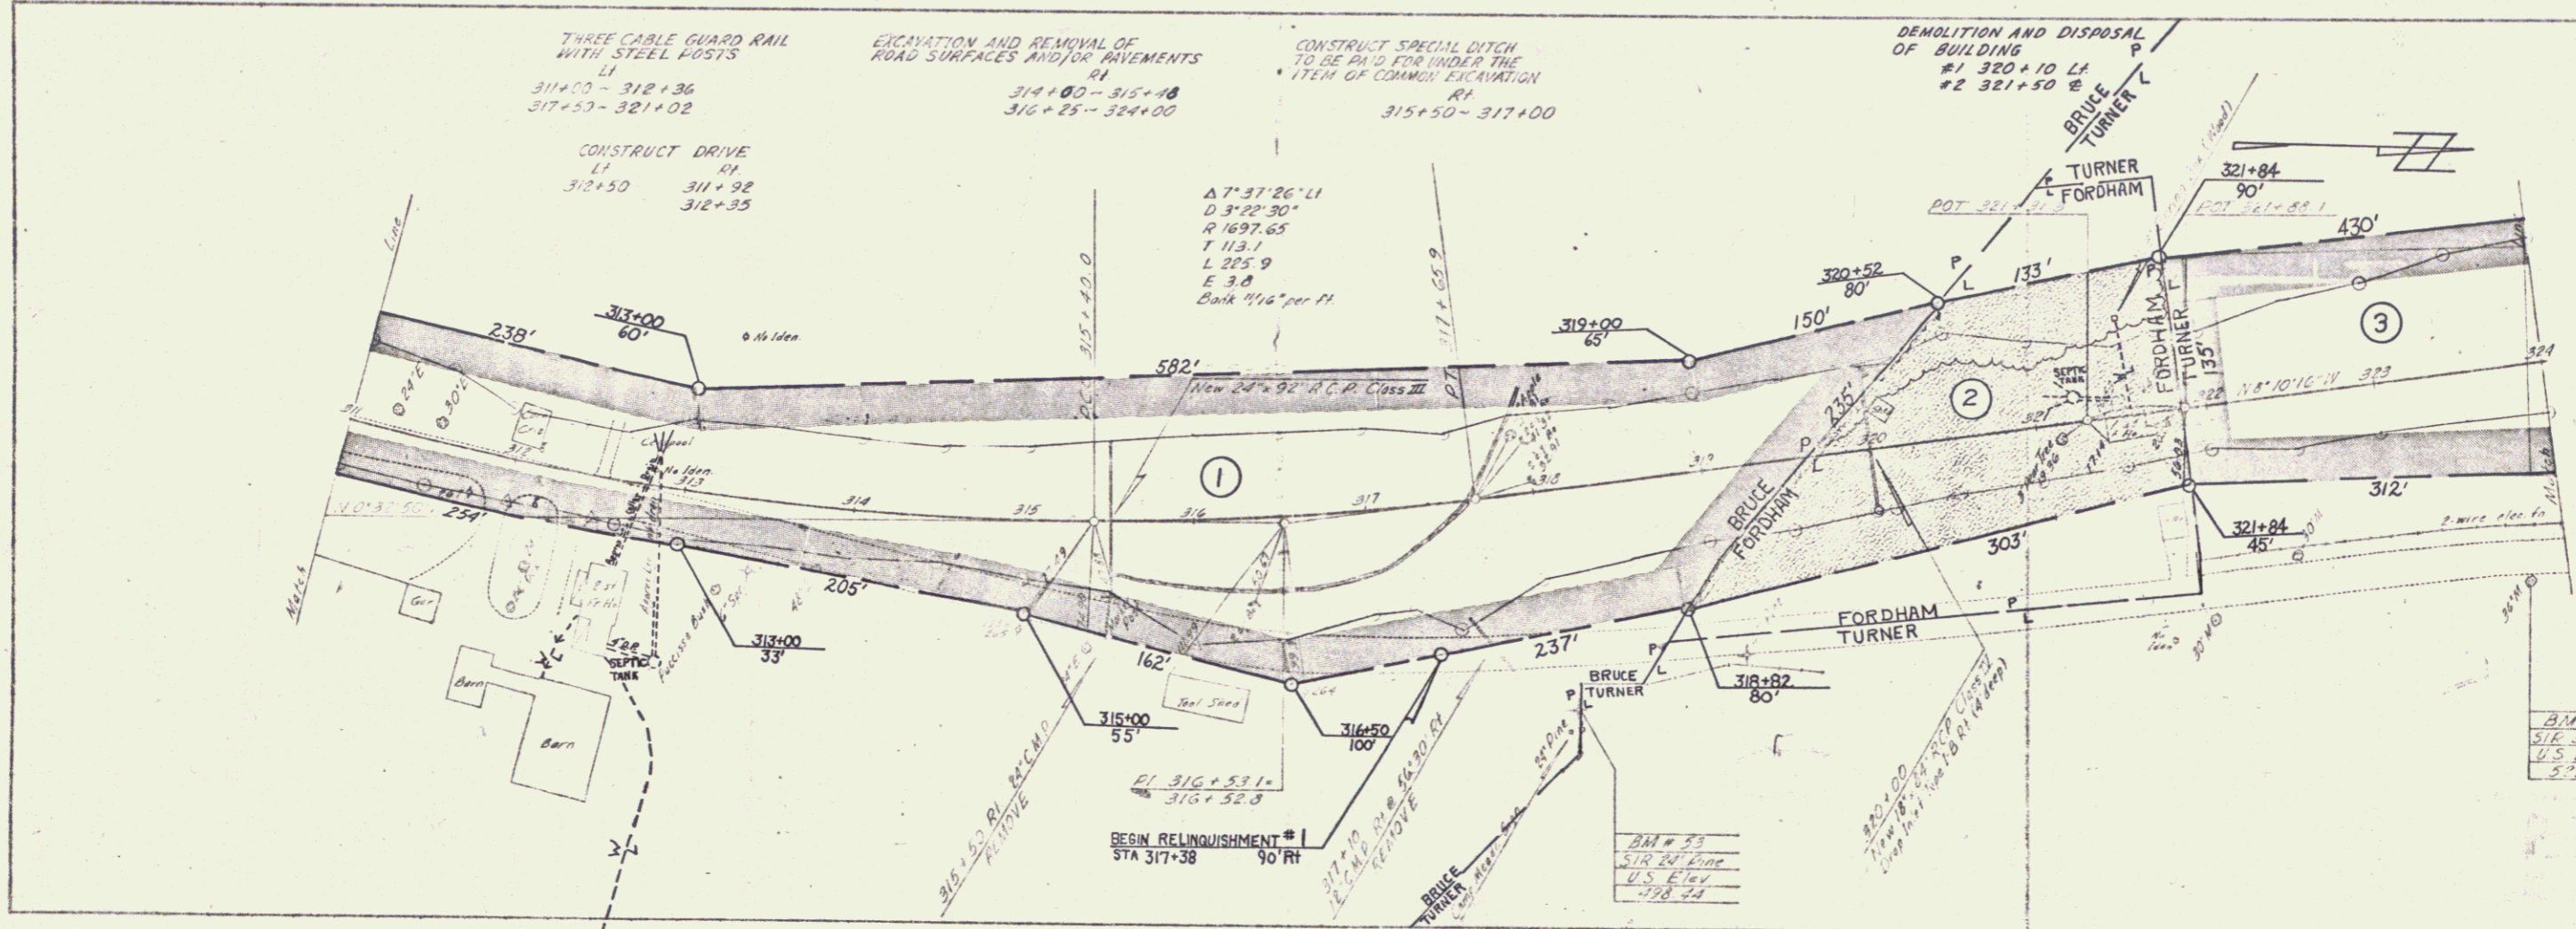

B.M. # 52
317+38.11
U.S. Elev.
279.13

B.M. # 53
318+82.80
U.S. Elev.
278.74

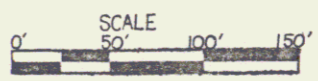

VERMONT DEPARTMENT OF HIGHWAYS  
 RIGHT-OF-WAY PLANS  
 PROJECT: MORETOWN  
 No. SQ167(7)  
 SHEET 9 OF 14

5