


BRIDGE DATA  
 Steel Truss  
 Span 720'  
 Roadway Width 16.0'

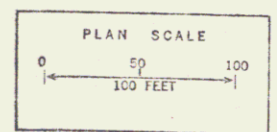

Martin & Leavelle May '62  
 SURVEYED BY Leavelle DATE Oct '62  
 DRAWN BY A. Gagnon DATE Oct '62  
 TRACED BY A. Gagnon DATE Oct '62  
**MORETOWN**  
 PROJ. 5 NO. 0167 (7)  
 SHEET 10 OF 39

$\Delta 105^{\circ}00'$  RA  
 D 71.30'  
 R 763.94'  
 T 995.6'  
 L 1400.0'  
 E 491.0'  
 Bank 15/16" per ft.

337+29  
 DITCH RELINQUISHMENT  
 EXCAVATION AND REMOVAL  
 OF ROAD SURFACES AND/OR  
 PAVEMENTS  
 RI 324+00-332+30  
 334+75-348+80  
 CONSTRUCT SPECIAL DITCH TO BE PAID  
 FOR UNDER THE ITEM OF COMMON EXCAVATION  
 RI 339+00-340+00

DRILLING & BLASTING OF  
 SOLID ROCK SUBGRADE  
 SL @ 332+50  
 1+55-2+10  
 3+00-4+20

CONTENTS OF SECTION OF THE OLD RIVER 100B,  
 BETWEEN STA. 337+29 TO (90' E.R.), AND  
 344+05 TO 327+00, IS HEREBY RELINQUISHED  
 AND RETURNED TO THE TOWN OF MORETOWN, ON M.T.  
 AS SHOWN ON PLAN SHEET 10 & 11 AND REFERRED  
 BY THE TOWN ENGINEER IN DECEMBER 22, 1962 at 4 PM. IN  
 BOOK 30, PAGE 117 OF THE LAND RECORDS.